PARENT PARCEL: 05-00-029-000-080
CHILD PARCEL: XX-XX-XXX-XXX-XXX
STARTING POINT: INTERSECTION OF C/L OF TELEGRAPH RD. AND EAST LINE OF O.L. 29

18-03946-D

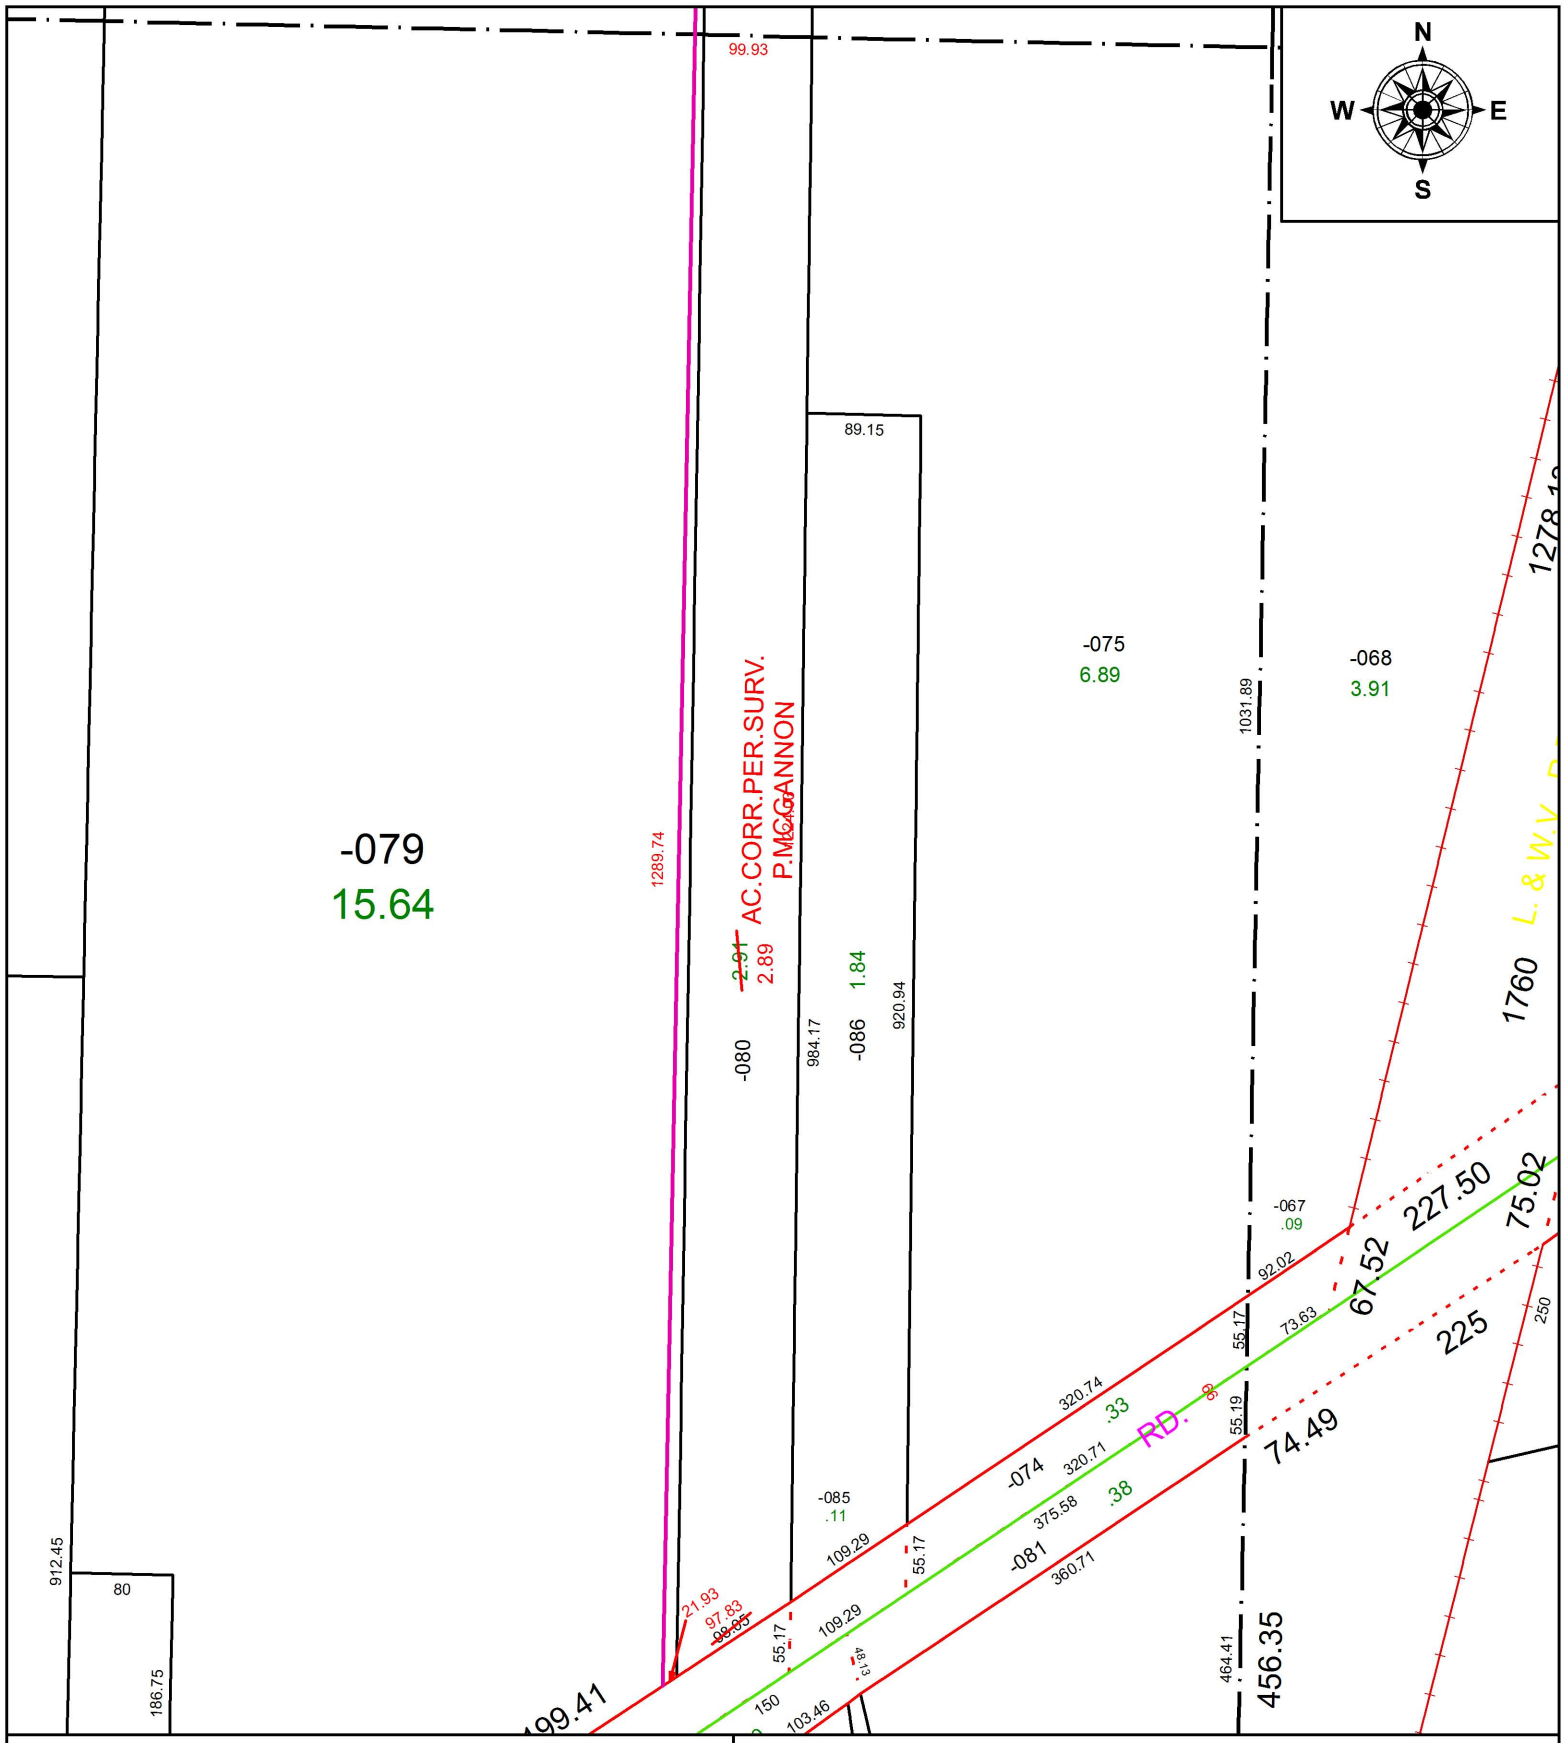

SPLITS/DEEDS PROCESSED
LORAIN COUNTY TAX MAP DEPARTMENT
226 MIDDLE AVE. ELYRIA, OH

SURVEYED BY: PATRICK A. MCGANNON
CLOSURE: 1: 395,471
MAP PAGE(S): 5-00-029
APPOVED BY: RRM **DATE:** 8-27-18
SCALE: 1" = 150 **PRIOR INSTRUMENT:** 20160582768