PARENT PARCEL: 02-01-008-101-212
CHILD PARCEL: 02-01-008-101-391, -392
STARTING POINT: SOUTHWEST CORNER OF LAND CONVEYED TO WILLIAM H. ROSS BAKER(DV 299/128)

18-03949-U

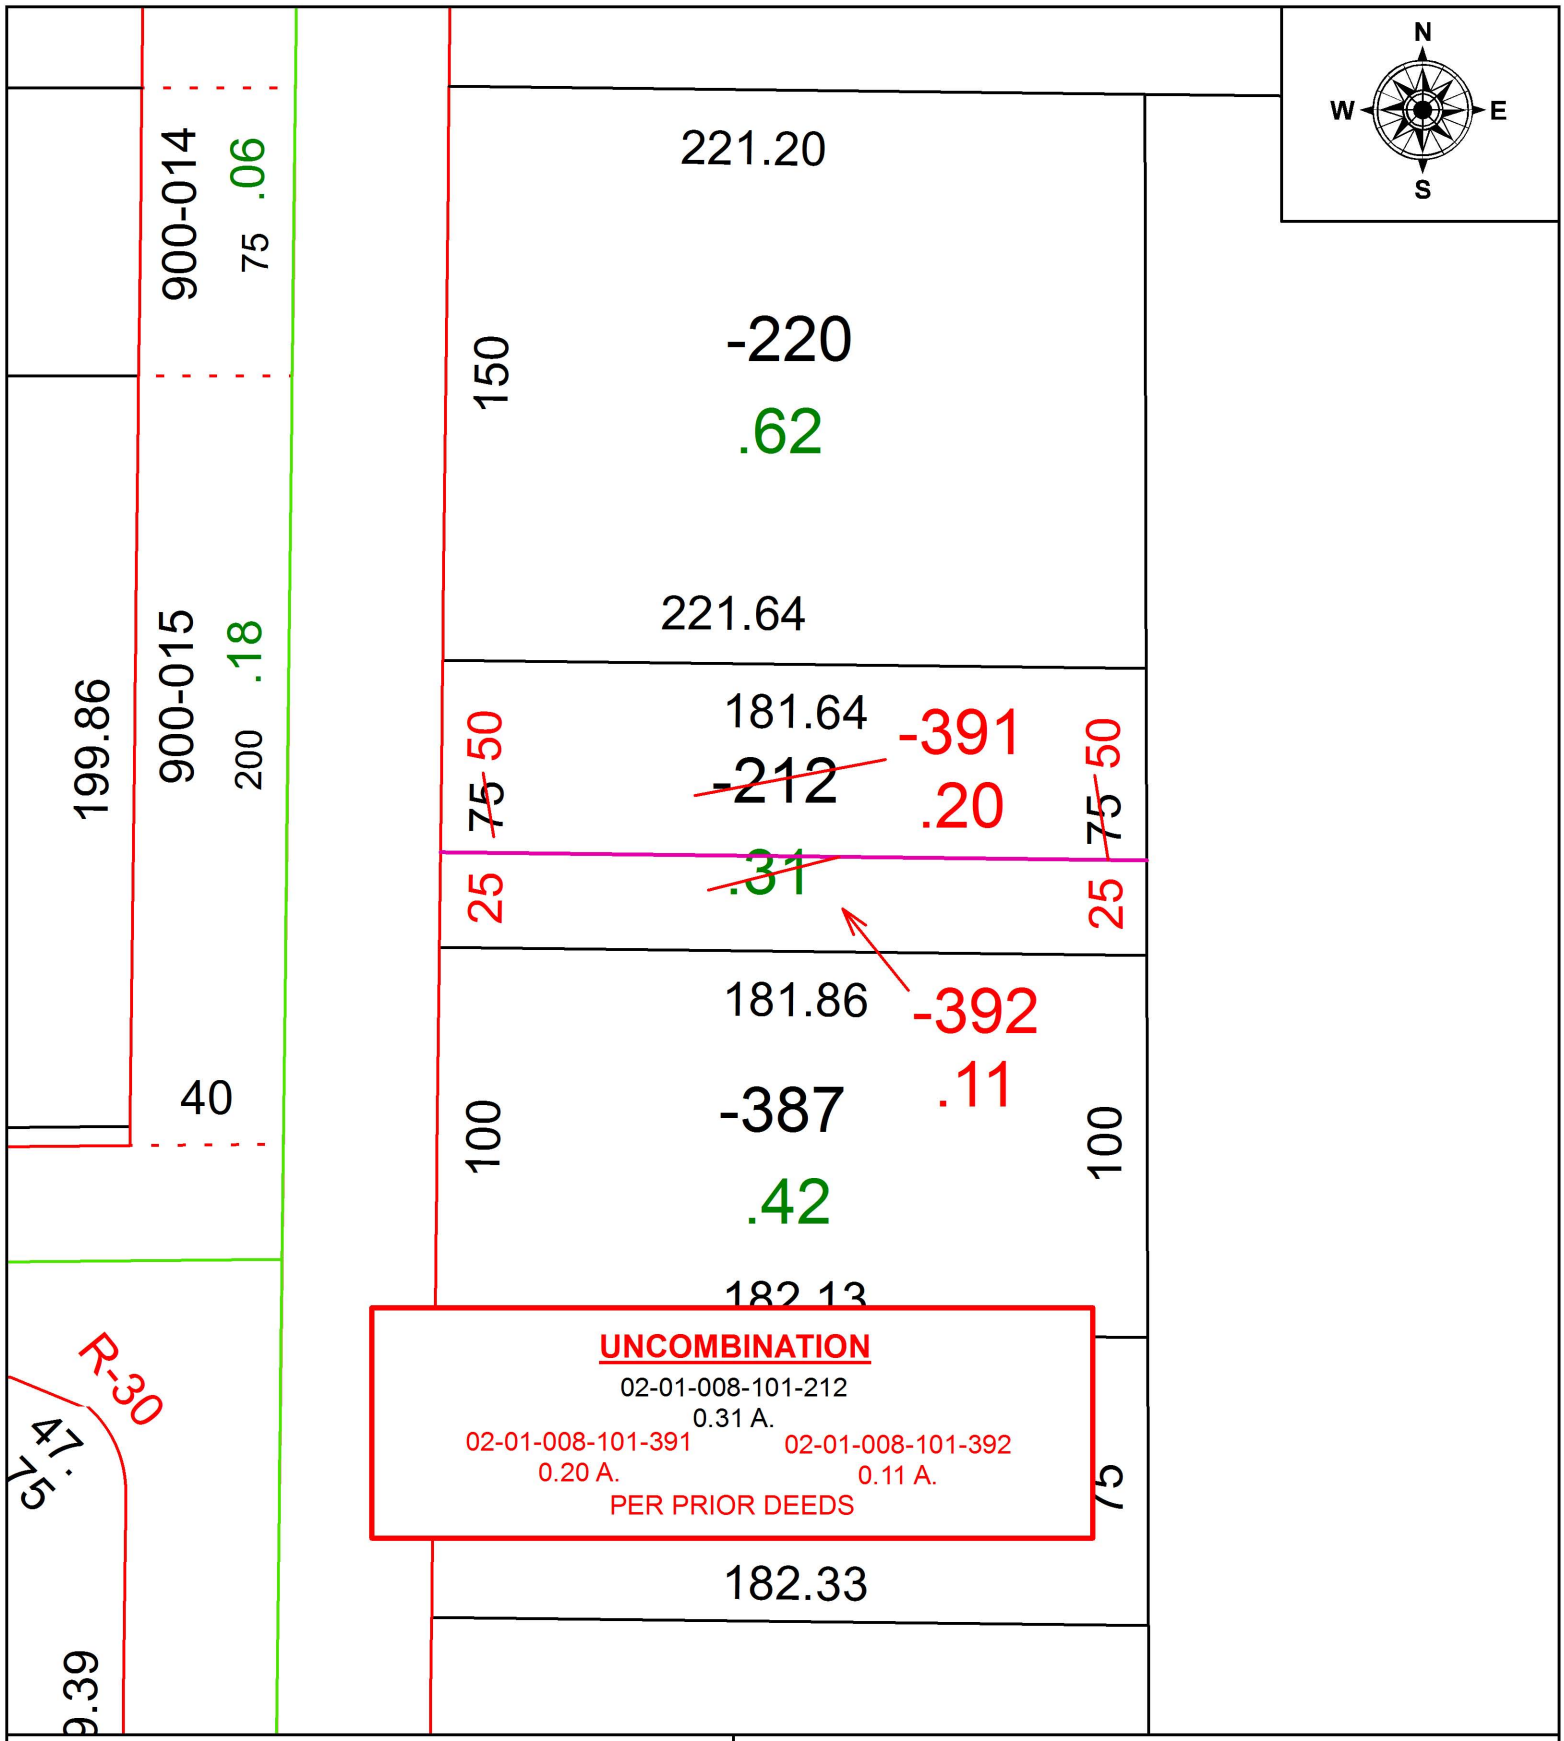

UNCOMBINATION
02-01-008-101-212
0.31 A.
02-01-008-101-391
0.20 A.
02-01-008-101-392
0.11 A.
PER PRIOR DEEDS

SPLITS/DEEDS PROCESSED
LORAIN COUNTY TAX MAP DEPARTMENT
226 MIDDLE AVE. ELYRIA, OH

SURVEYED BY: N/A
CLOSURE: N/A
MAP PAGE(S): 2-01-008
APPOVED BY: RRM **DATE:** 8-30-18
SCALE: 1" = 50 **PRIOR INSTRUMENT:** DV 1349/372