PARENT PARCEL: 07-00-035-101-068

CHILD PARCEL: 07-00-035-101-077, -078

STARTING POINT: INTERSECTION OF C/L OF SUGAR RIDGE RD, AND C/L OF RACE RD.

19-03949

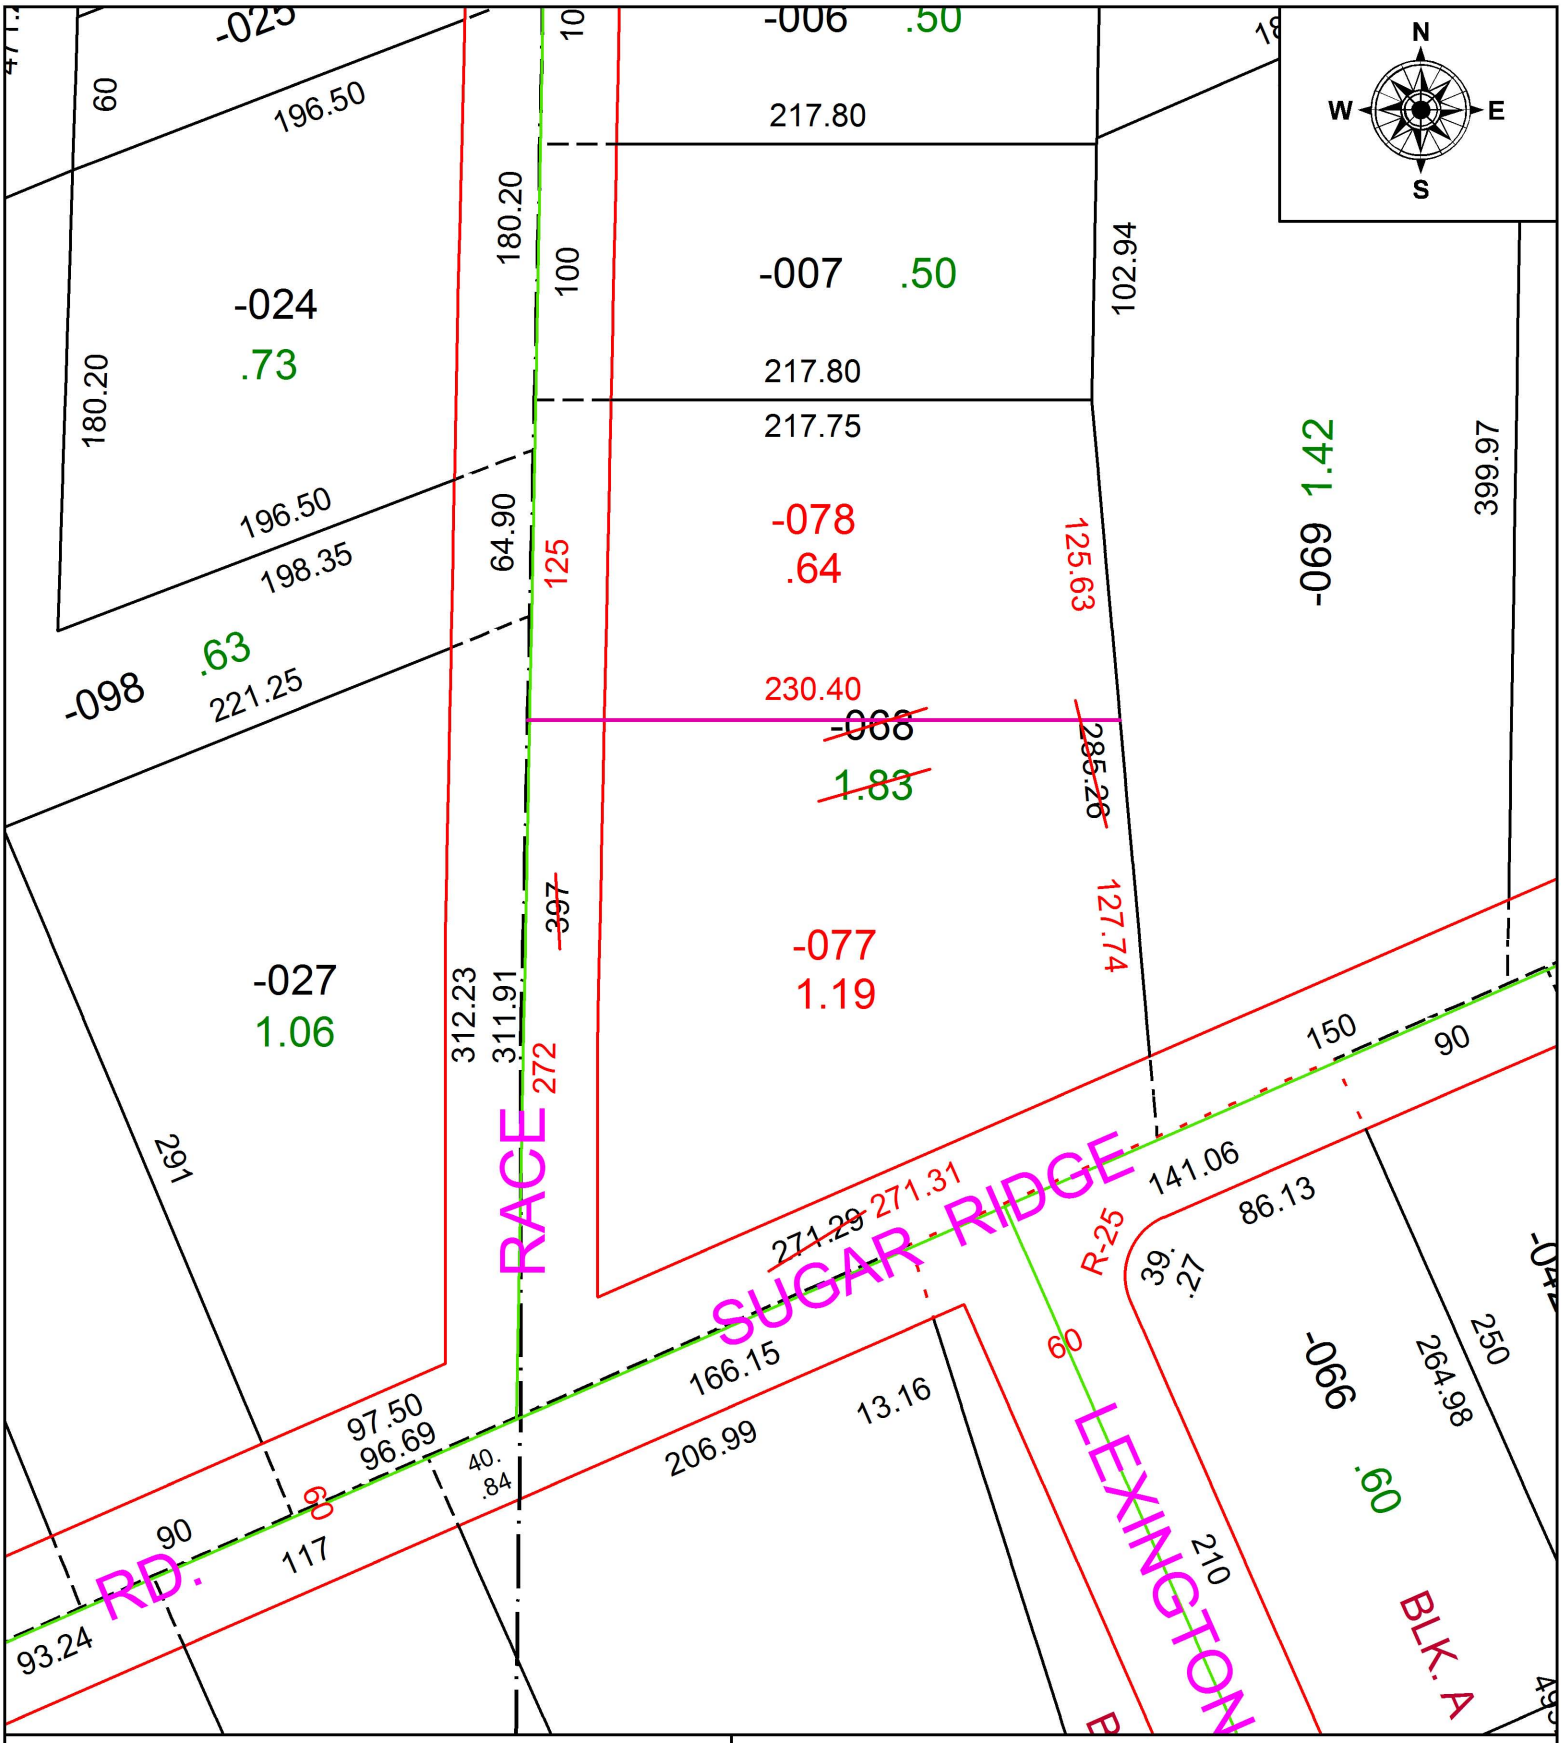

SPLITS/DEEDS PROCESSED

LORAIN COUNTY TAX MAP DEPARTMENT
226 MIDDLE AVE. ELYRIA, OH

SURVEYED BY: MICHAEL P. SPELLACY
CLOSURE: 1:258,786
MAP PAGE(S): 7-00-035
APPOVED BY: RRM **DATE:** 3-20-19
SCALE: 1" = 75 **PRIOR INSTRUMENT:** 20180694958