PARENT PARCEL: 12-00-089-000-016, -017

CHILD PARCEL: 12-00-089-000-026 THRU -030

STARTING POINT: NORTHEAST CORNER OF O.L.89

19-03953

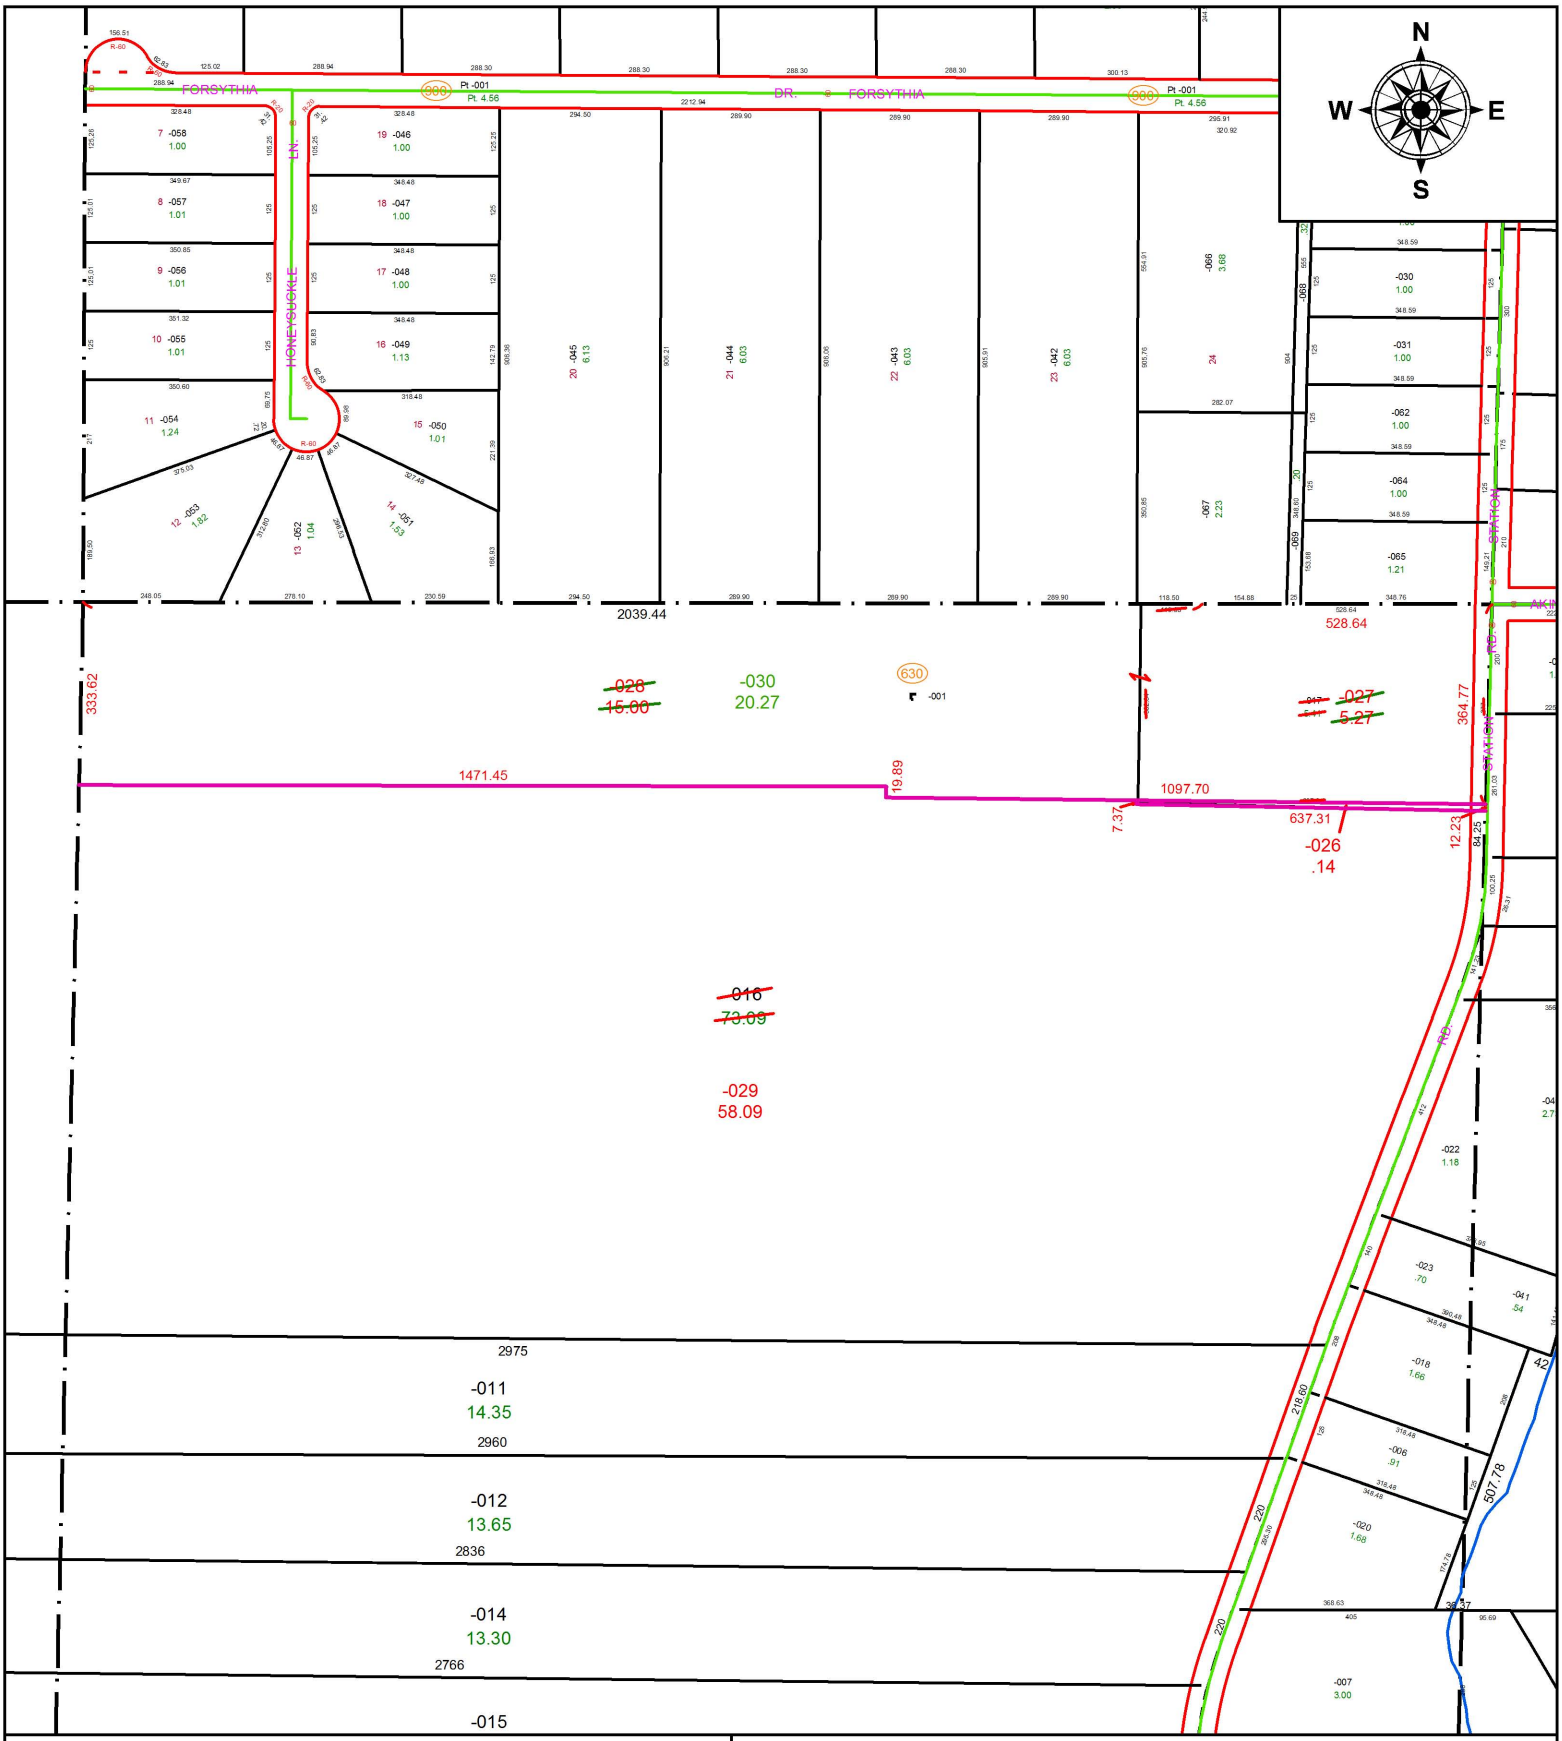

SPLITS/DEEDS PROCESSED

LORAIN COUNTY TAX MAP DEPARTMENT
226 MIDDLE AVE. ELYRIA, OH

SURVEYED BY: WILFREDO BARBOSA

CLOSURE: 1:152,506

MAP PAGE(S): 12-00-089

APPOVED BY: RRM **DATE:** 3-28-19

SCALE: 1" = 350 **PRIOR INSTRUMENT:** 19970478024