PARENT PARCEL: 06-25-003-103-001
CHILD PARCEL: XX-XX-XXX-XXX-XXX
STARTING POINT: INTERSECTION OF C/L OF UNIVERSITY AVE. AND C/L OF EAST RIVER RD.

18-03955-D

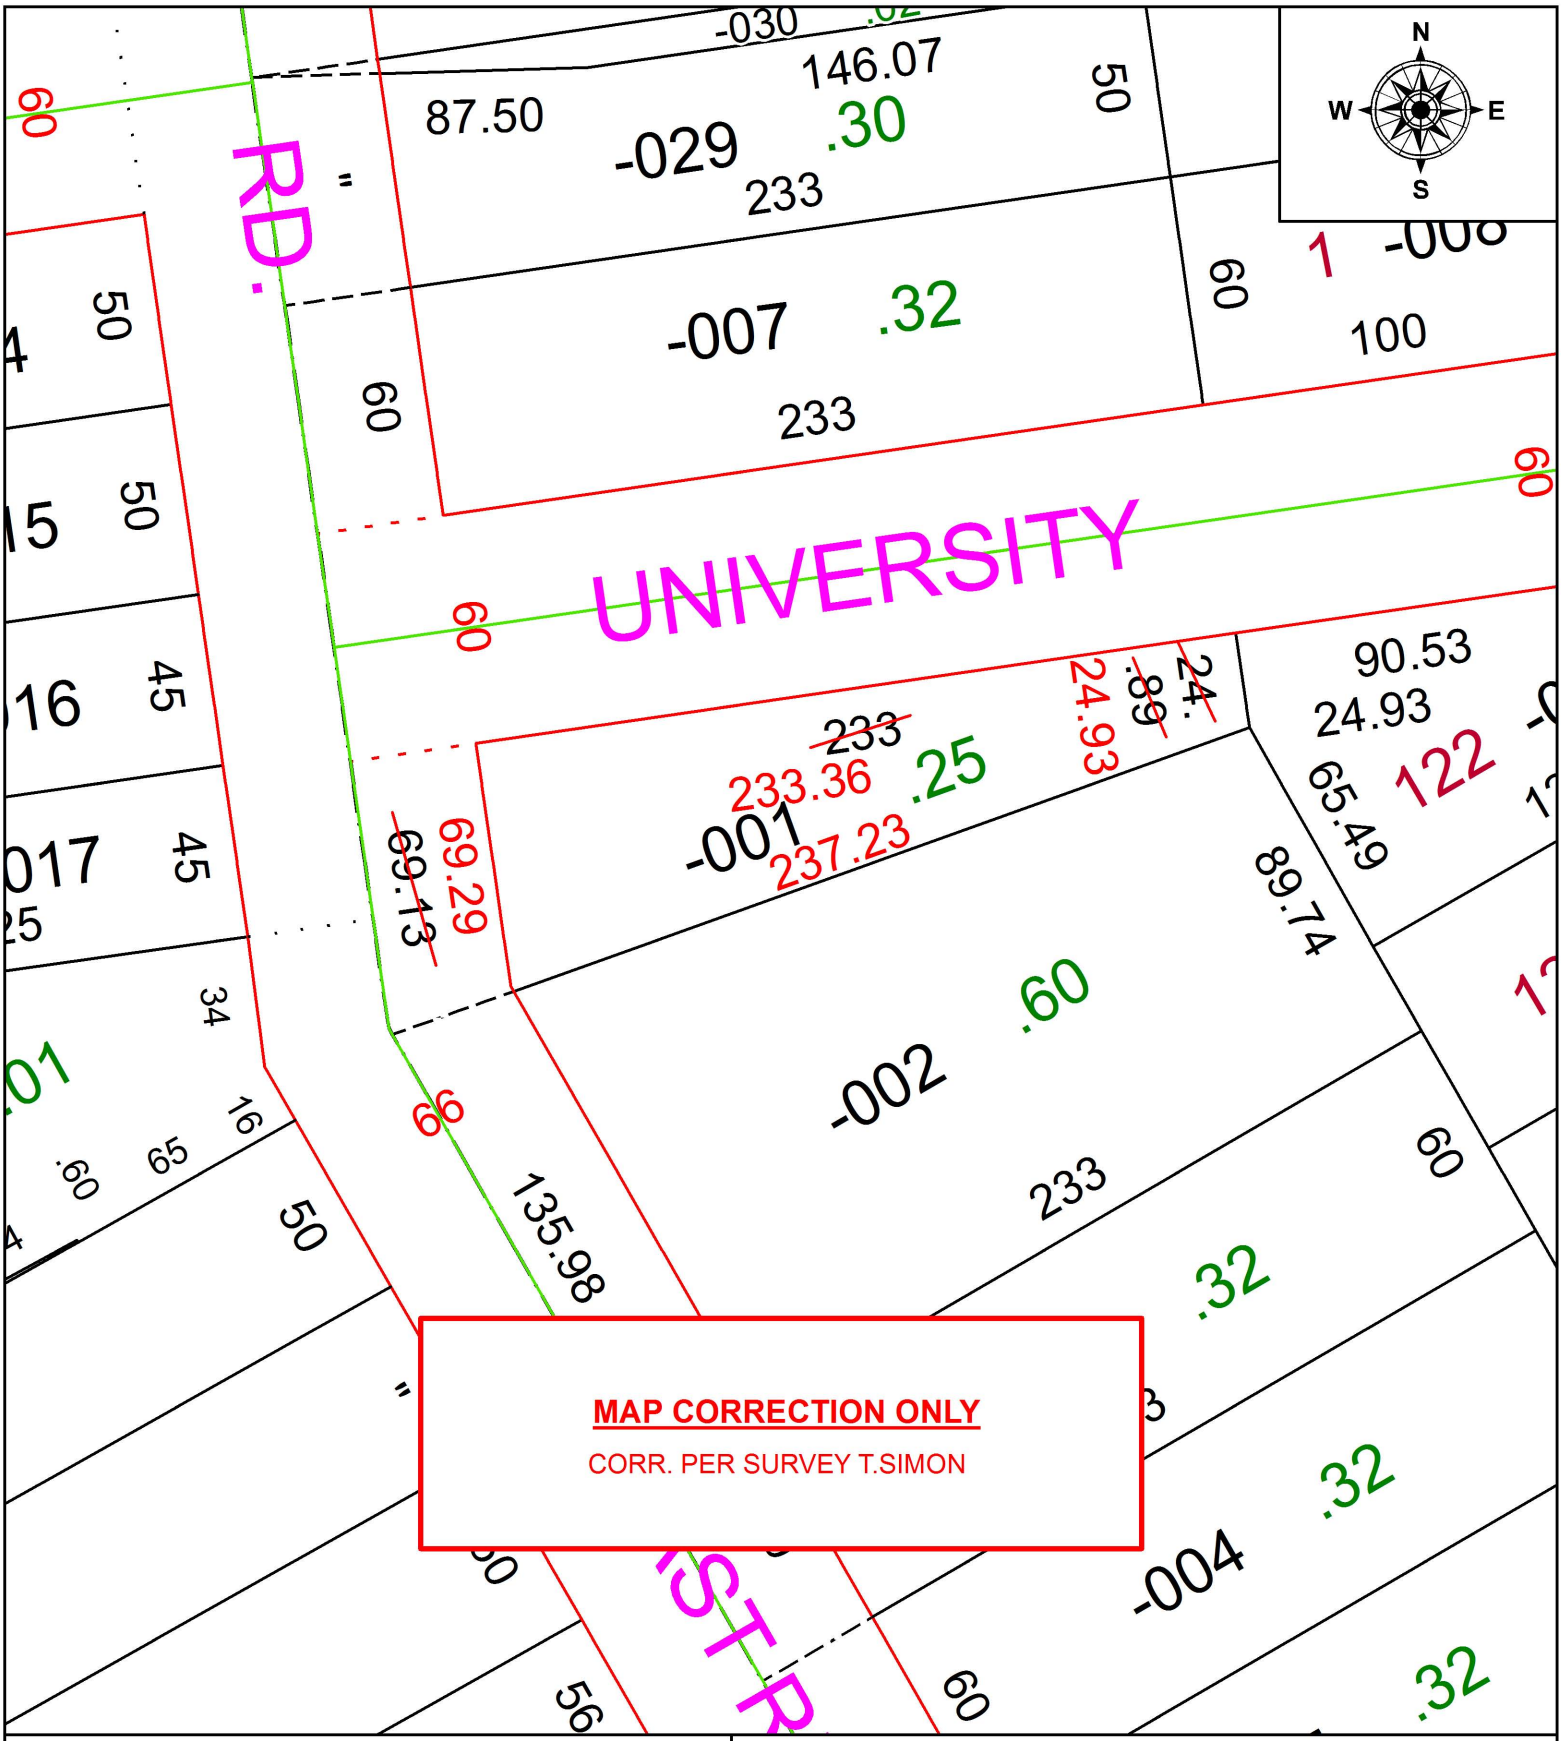

SPLITS/DEEDS PROCESSED
LORAIN COUNTY TAX MAP DEPARTMENT
226 MIDDLE AVE. ELYRIA, OH

SURVEYED BY: THOMAS A. SIMON
CLOSURE: 1: 951,430
MAP PAGE(S): 6-139
APPOVED BY: RRM **DATE:** 9-12-18
SCALE: 1" = 50 **PRIOR INSTRUMENT:** 20180678672