PARENT PARCEL: 11-00-020-000-005

CHILD PARCEL: 11-00-020-000-035, -036

STARTING POINT: SOUTHEAST CORNER OF O.L.20

19-03955

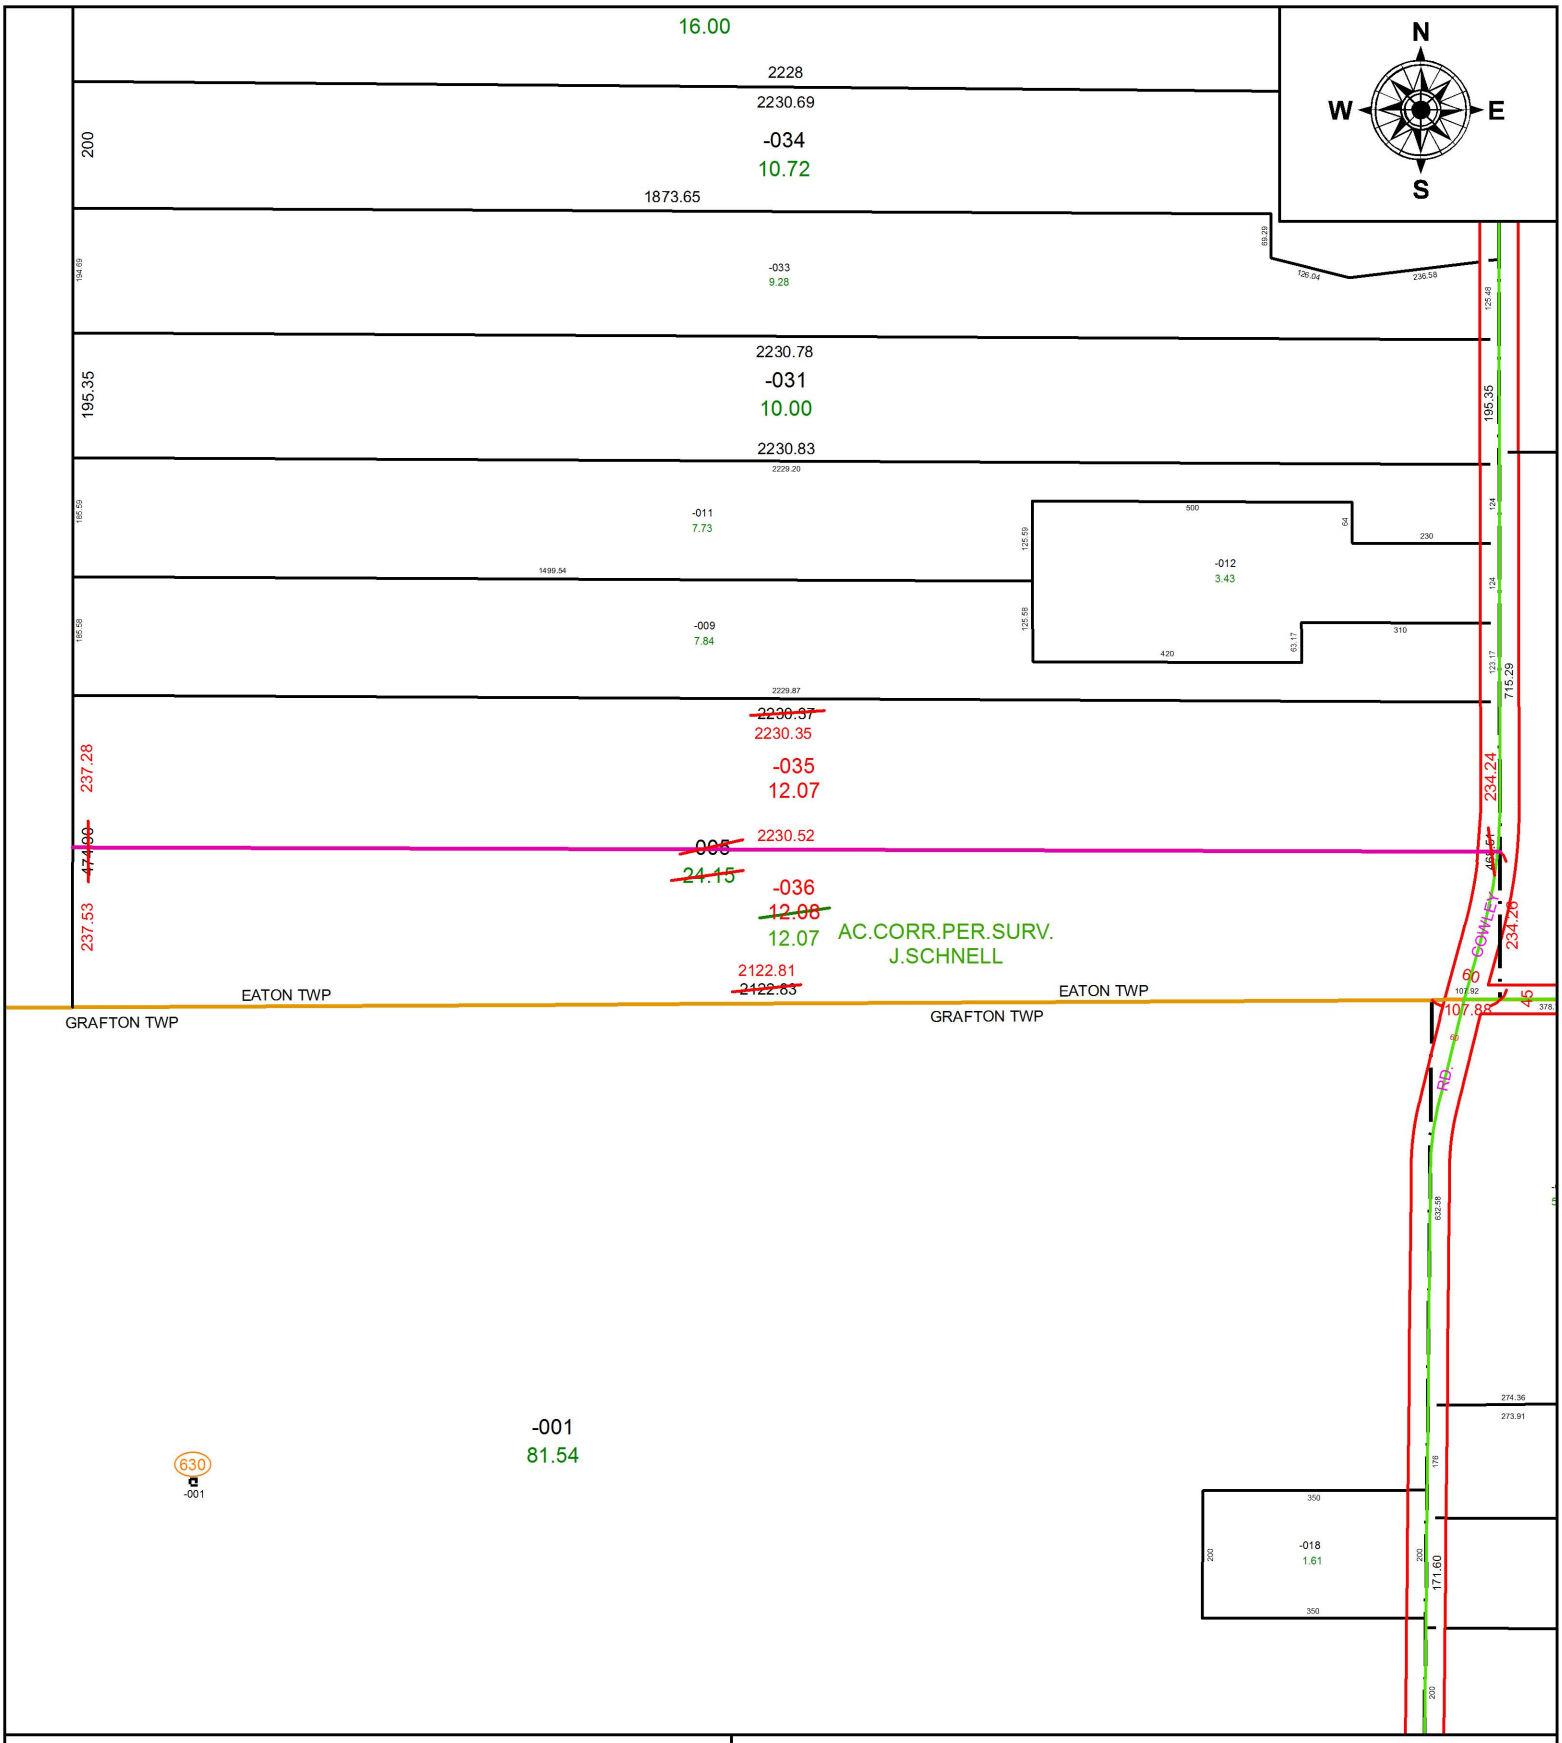

SPLITS/DEEDS PROCESSED

LORAIN COUNTY TAX MAP DEPARTMENT
226 MIDDLE AVE. ELYRIA, OH

SURVEYED BY: JARROD R. SCHNELL

CLOSURE: 1:409,900

MAP PAGE(S): 11-00-020

APPOVED BY: RRM **DATE:** 4-3-19

SCALE: 1" = 300 **PRIOR INSTRUMENT:** 20180670101