PARENT PARCEL: 01-00-060-000-025, 01-00-069-000-004, 01-00-070-000-001

CHILD PARCEL: XX-XX-XXX-XXX-XXX

STARTING POINT: INTERSECTION OF C/L OF MIDDLE RIDGE RD. AND EAST LINE OF O.L.60

18-03956-A

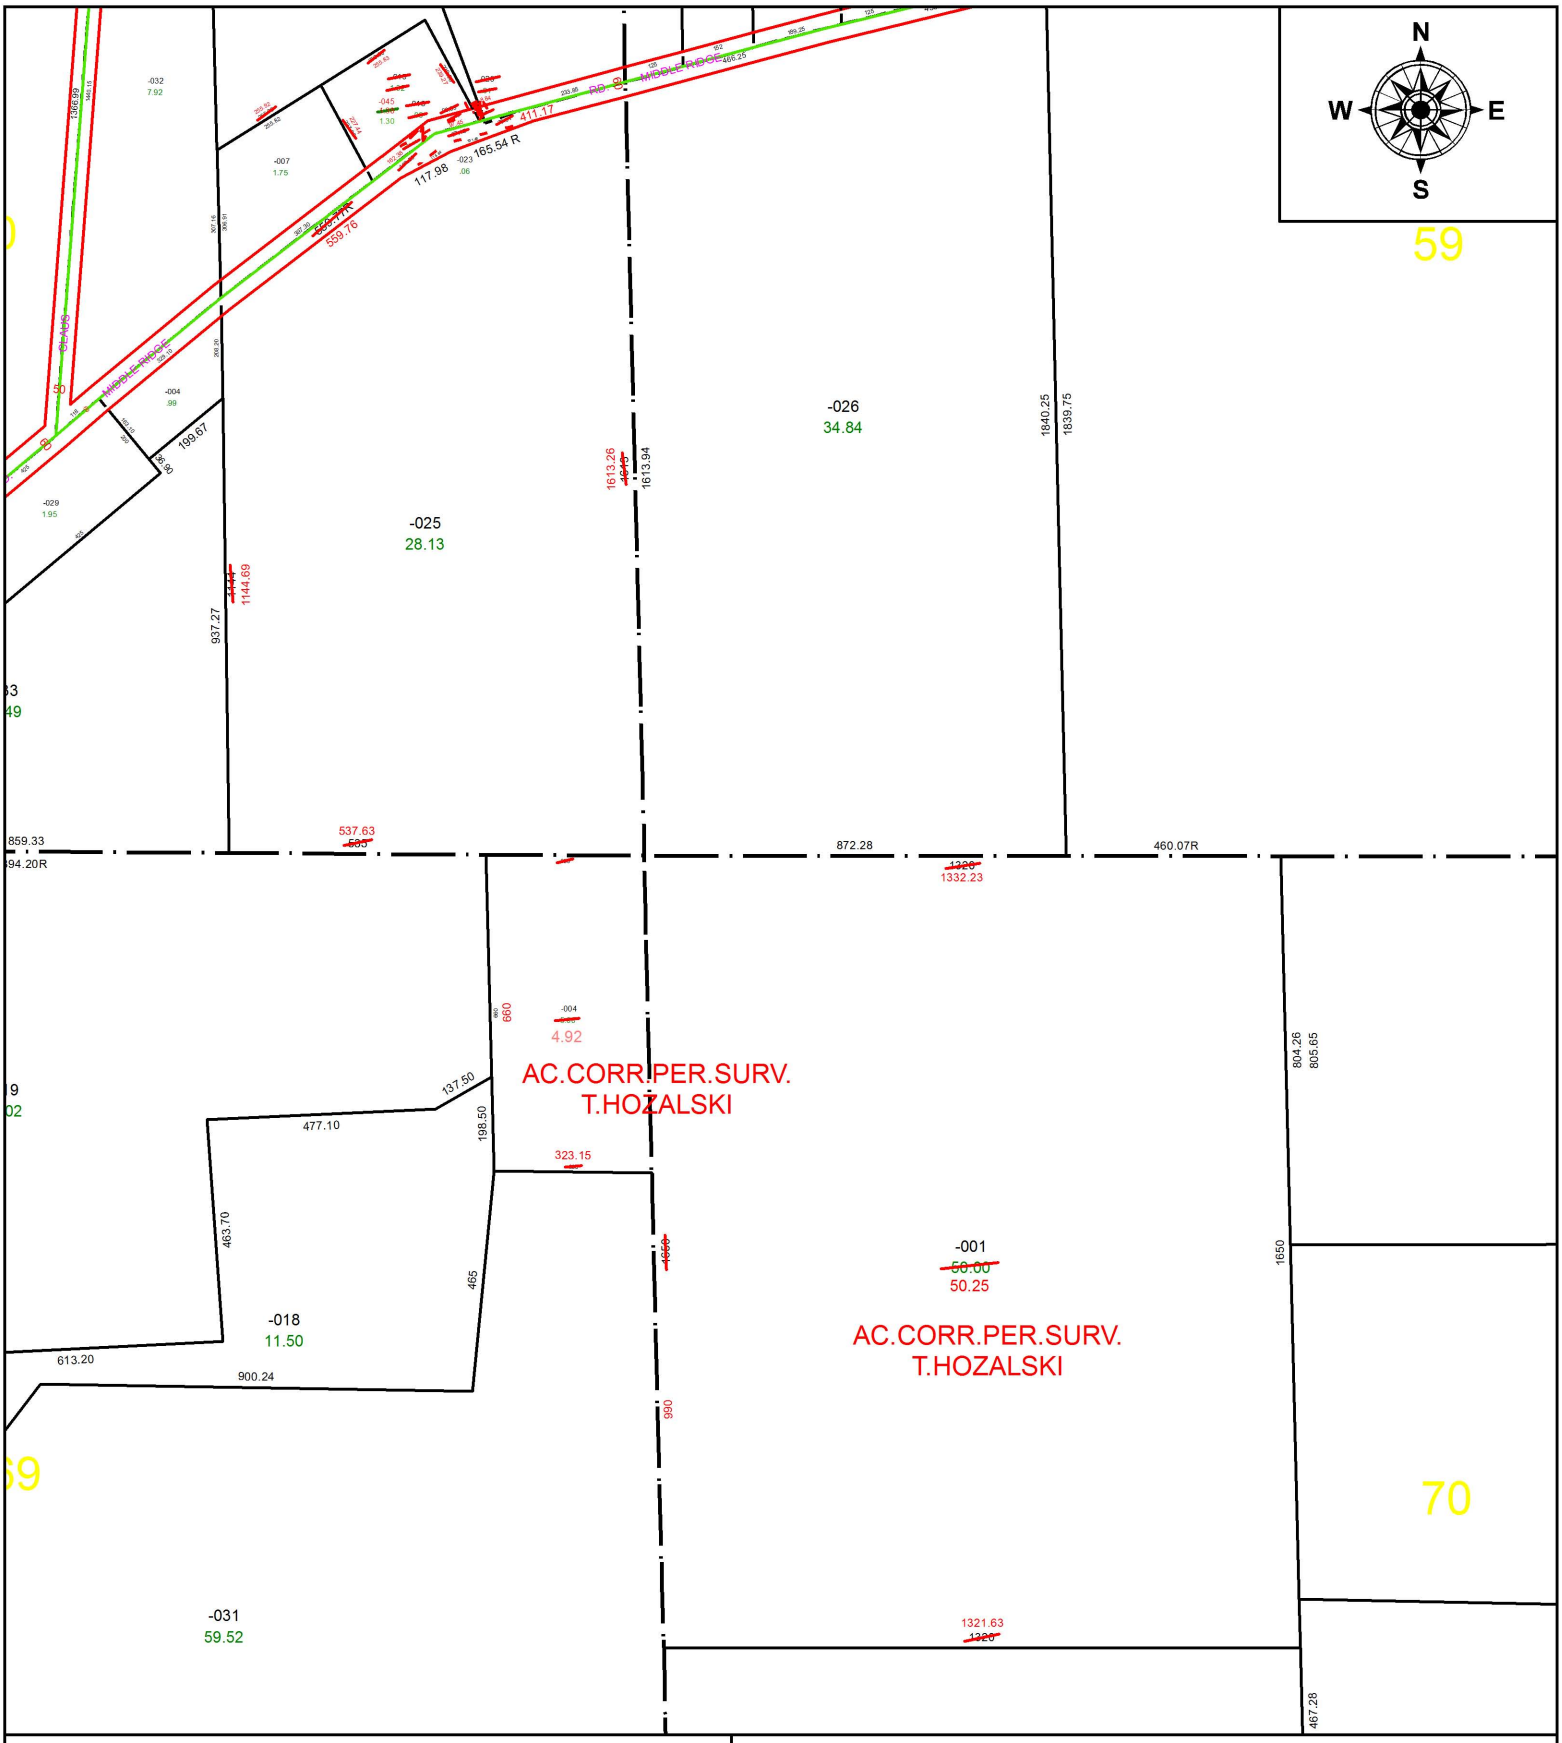

SPLITS/DEEDS PROCESSED

LORAIN COUNTY TAX MAP DEPARTMENT
226 MIDDLE AVE. ELYRIA, OH

SURVEYED BY: TIMOTHY D. HOZALSKI
CLOSURE: 1: 827,220
MAP PAGE(S): 1-K
APPOVED BY: RRM **DATE:** 9-7-18
SCALE: 1" = 400 **PRIOR INSTRUMENT:** 20140526081