PARENT PARCEL: 06-23-008-101-008, -009

CHILD PARCEL:

STARTING POINT:

18-03957-A

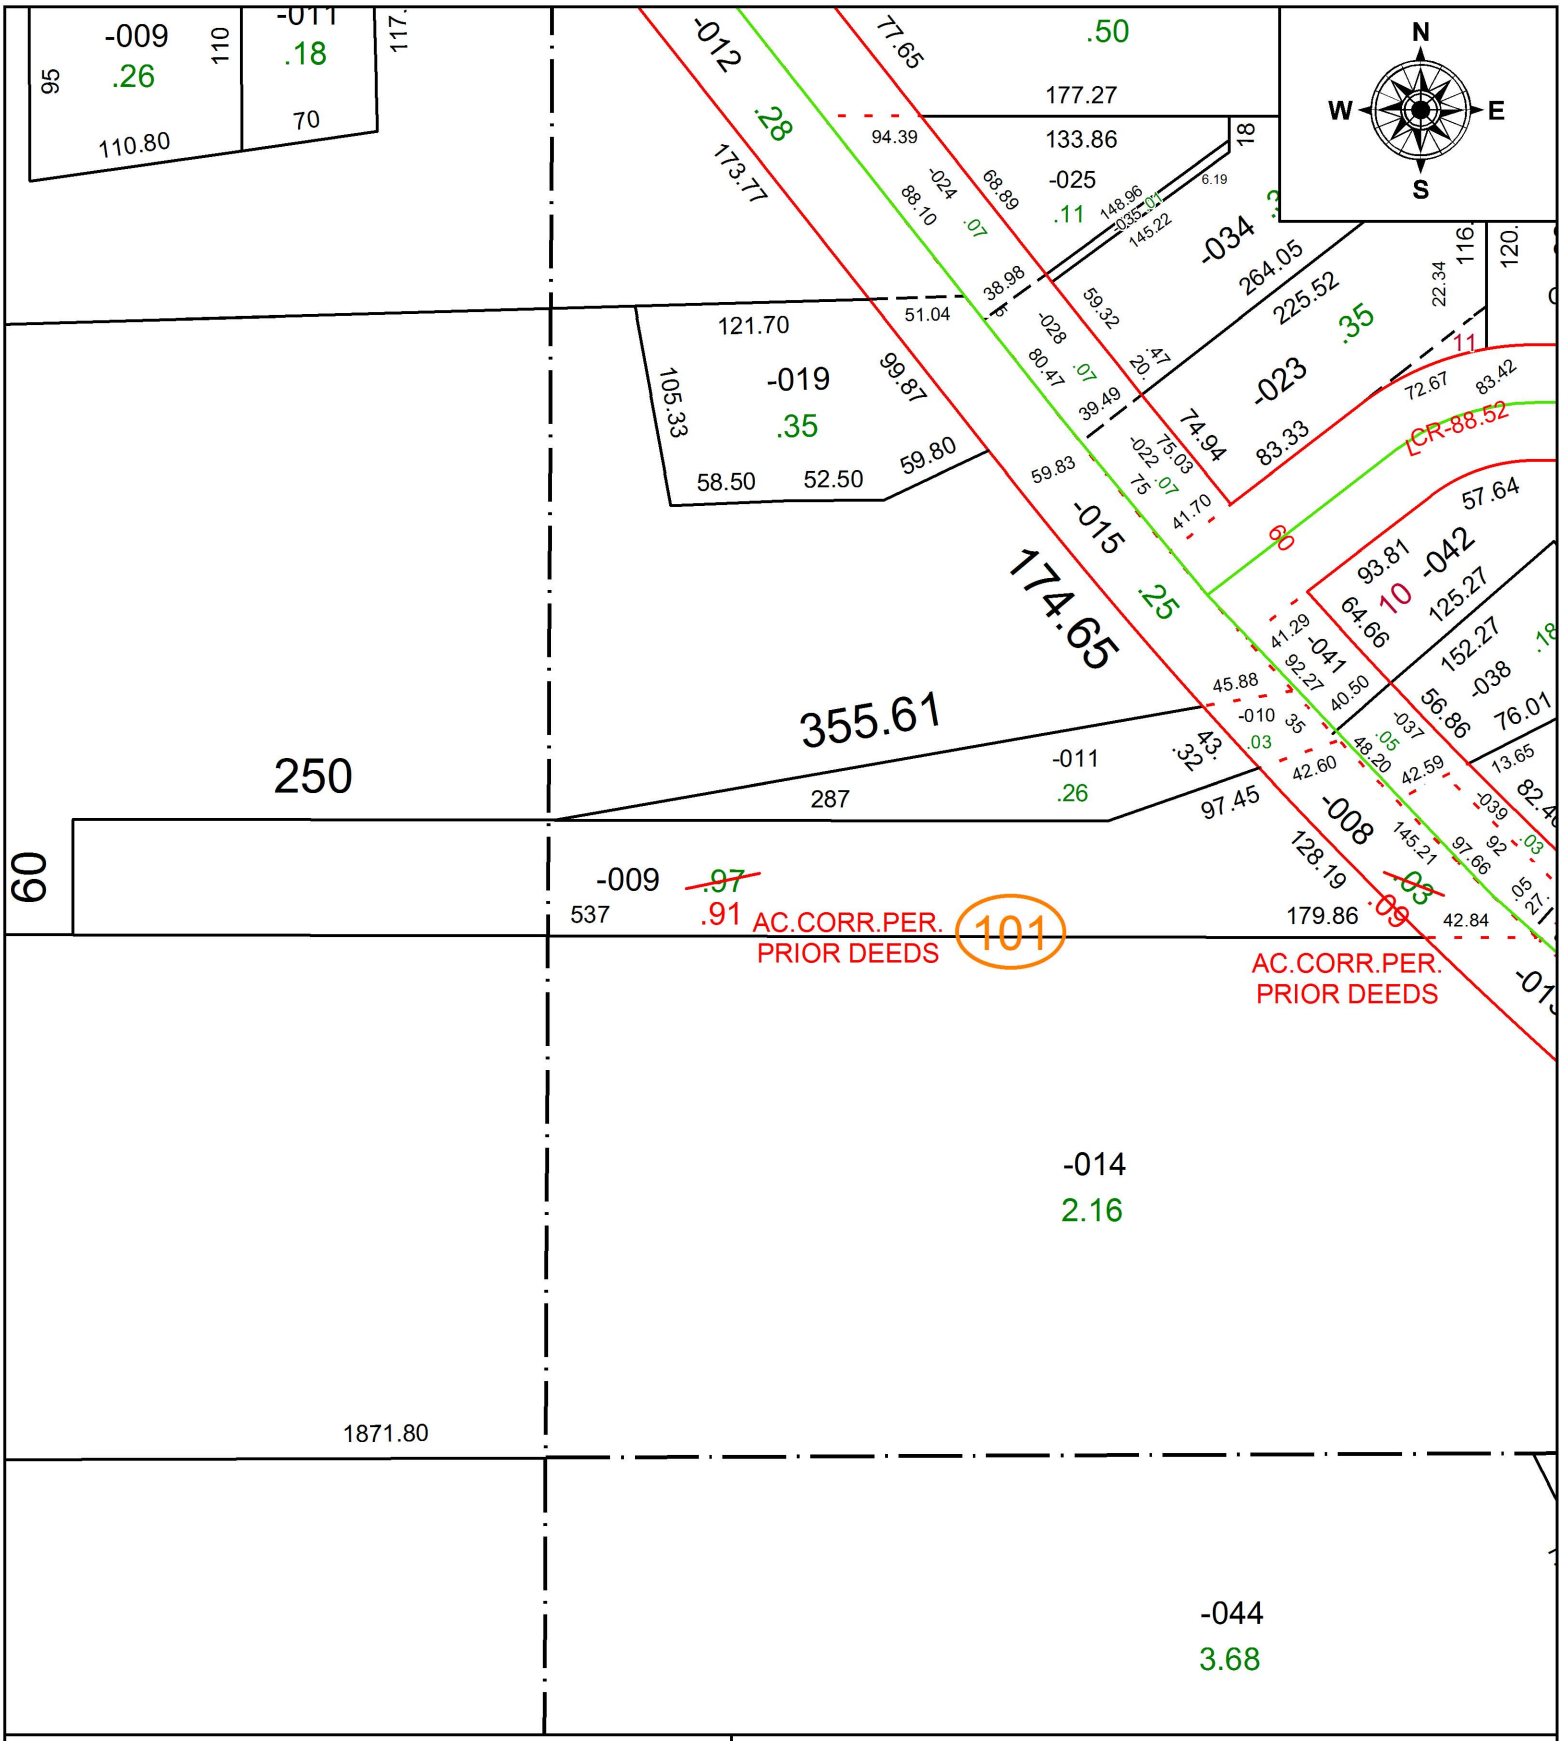

SPLITS/DEEDS PROCESSED

LORAIN COUNTY TAX MAP DEPARTMENT
226 MIDDLE AVE. ELYRIA, OH

SURVEYED BY: N/A
CLOSURE: N/A
MAP PAGE(S): 6-24
APPOVED BY: RRM **DATE:** 9-13-18
SCALE: 1" = 100 **PRIOR INSTRUMENT:** DV 1258/331