PARENT PARCEL: 02-01-003-113-010 & -011

CHILD PARCEL: DEPTH CORRECTION -010 & -011 PER INST. # 203-0898251

STARTING POINT: 02-01-003-113-010 FROM 50 X 81.1 TO 50 X 81.17 & 02-01-003-113-011 FROM 50 X 73 TO 50 X 73.33

18-03959-C

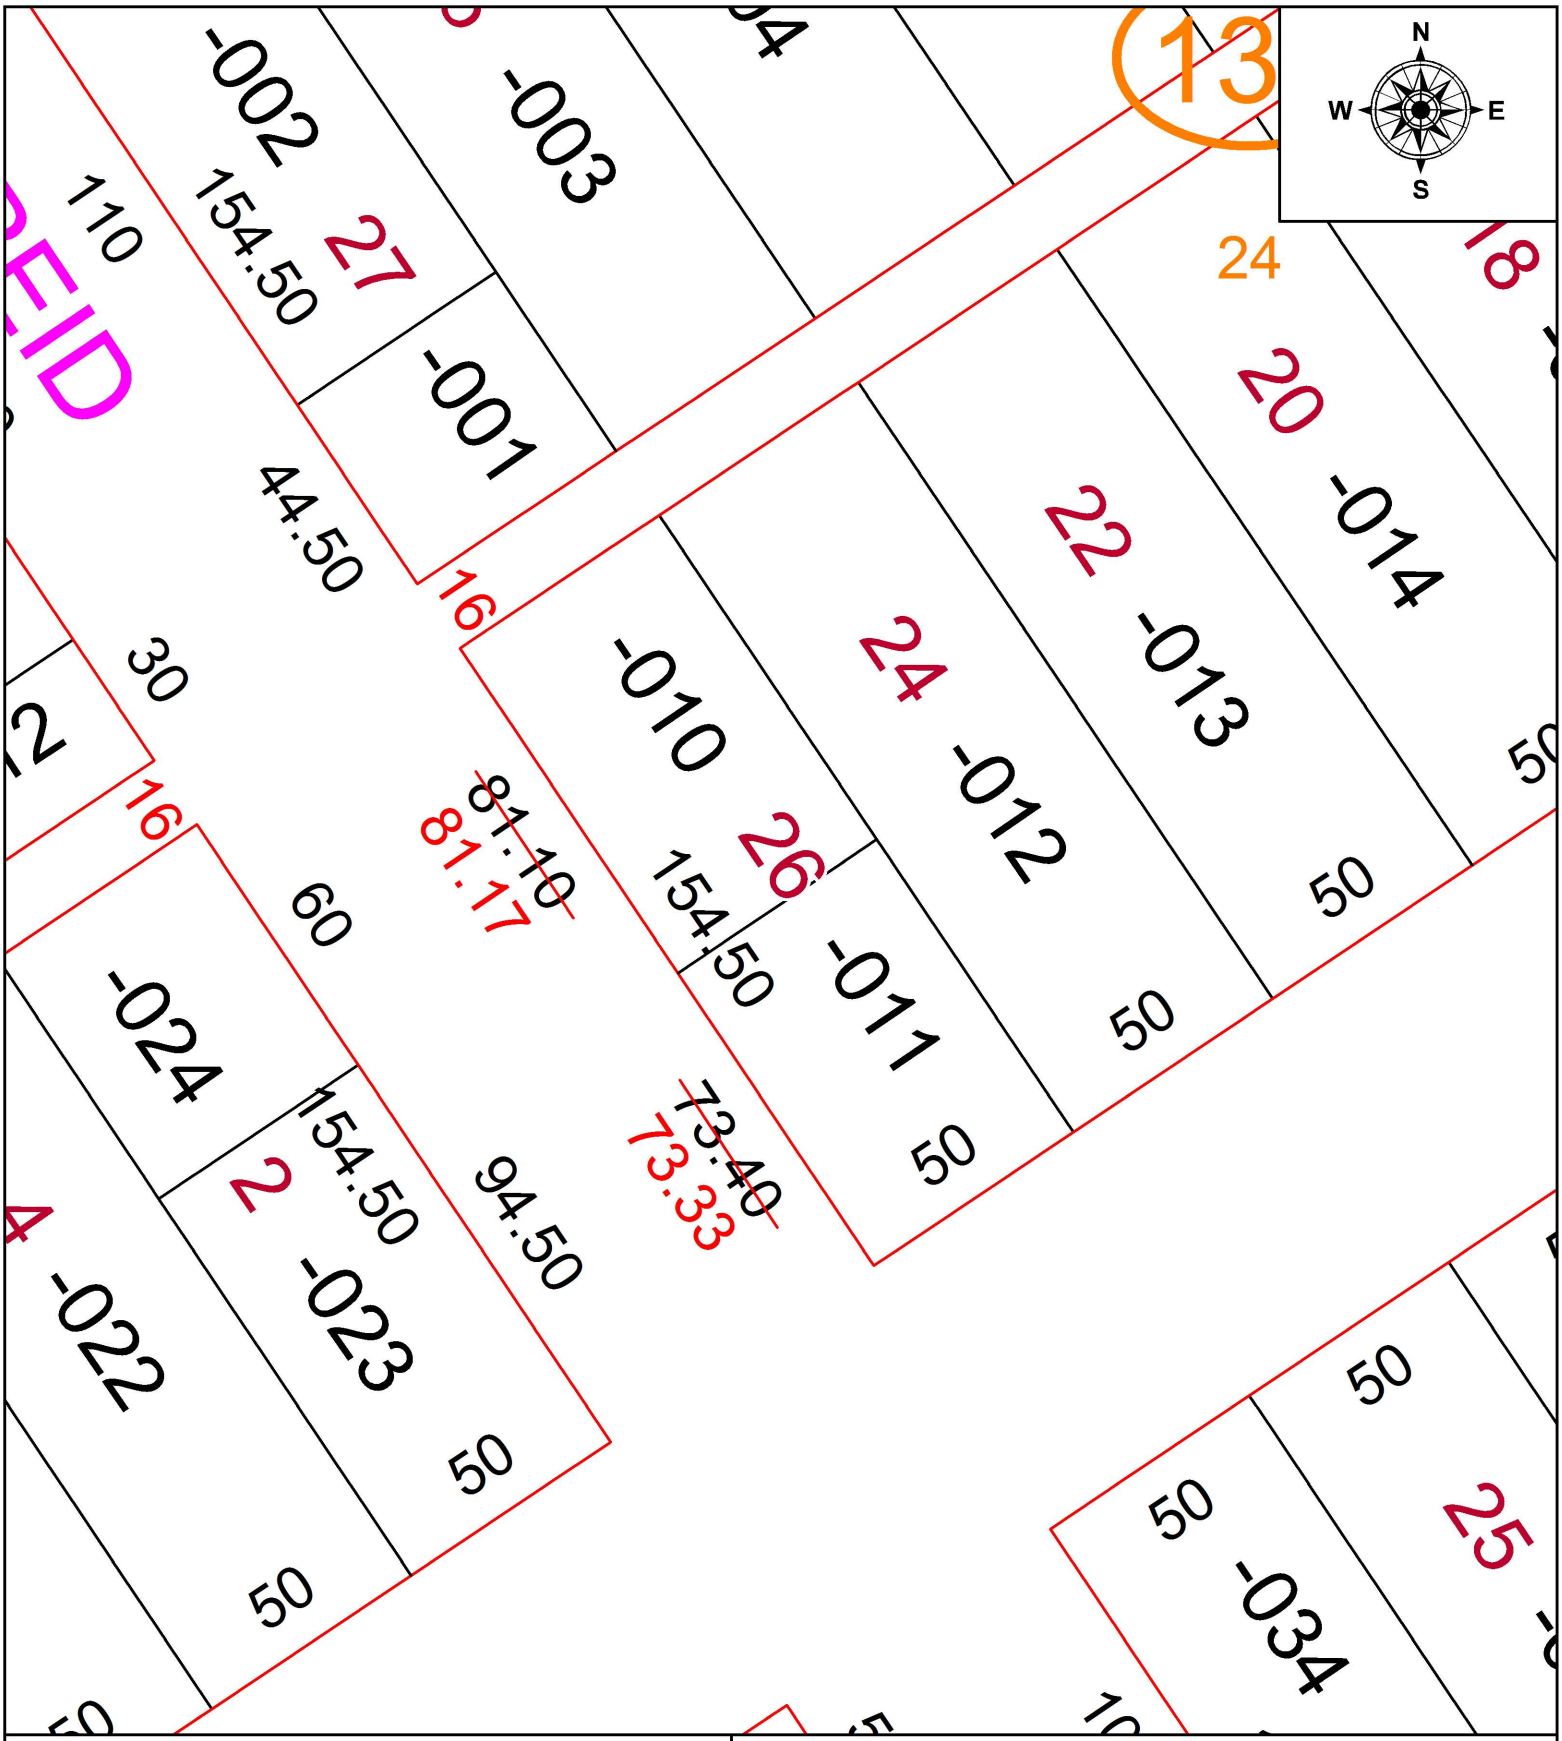

SPLITS/DEEDS PROCESSED

LORAIN COUNTY TAX MAP DEPARTMENT
226 MIDDLE AVE. ELYRIA, OH

SURVEYED BY: NA
CLOSURE: NA
MAP PAGE(S): 02-01-003
APPOVED BY: TJS **DATE:** 9/25/18
SCALE: 1" = 40' **PRIOR INSTRUMENT:** 2003-0898251