PARENT PARCEL: 09-00-048-000-011

CHILD PARCEL: 09-00-048-000-012, -013

STARTING POINT: NORTHWEST CORNER OF O.L.48

19-03959

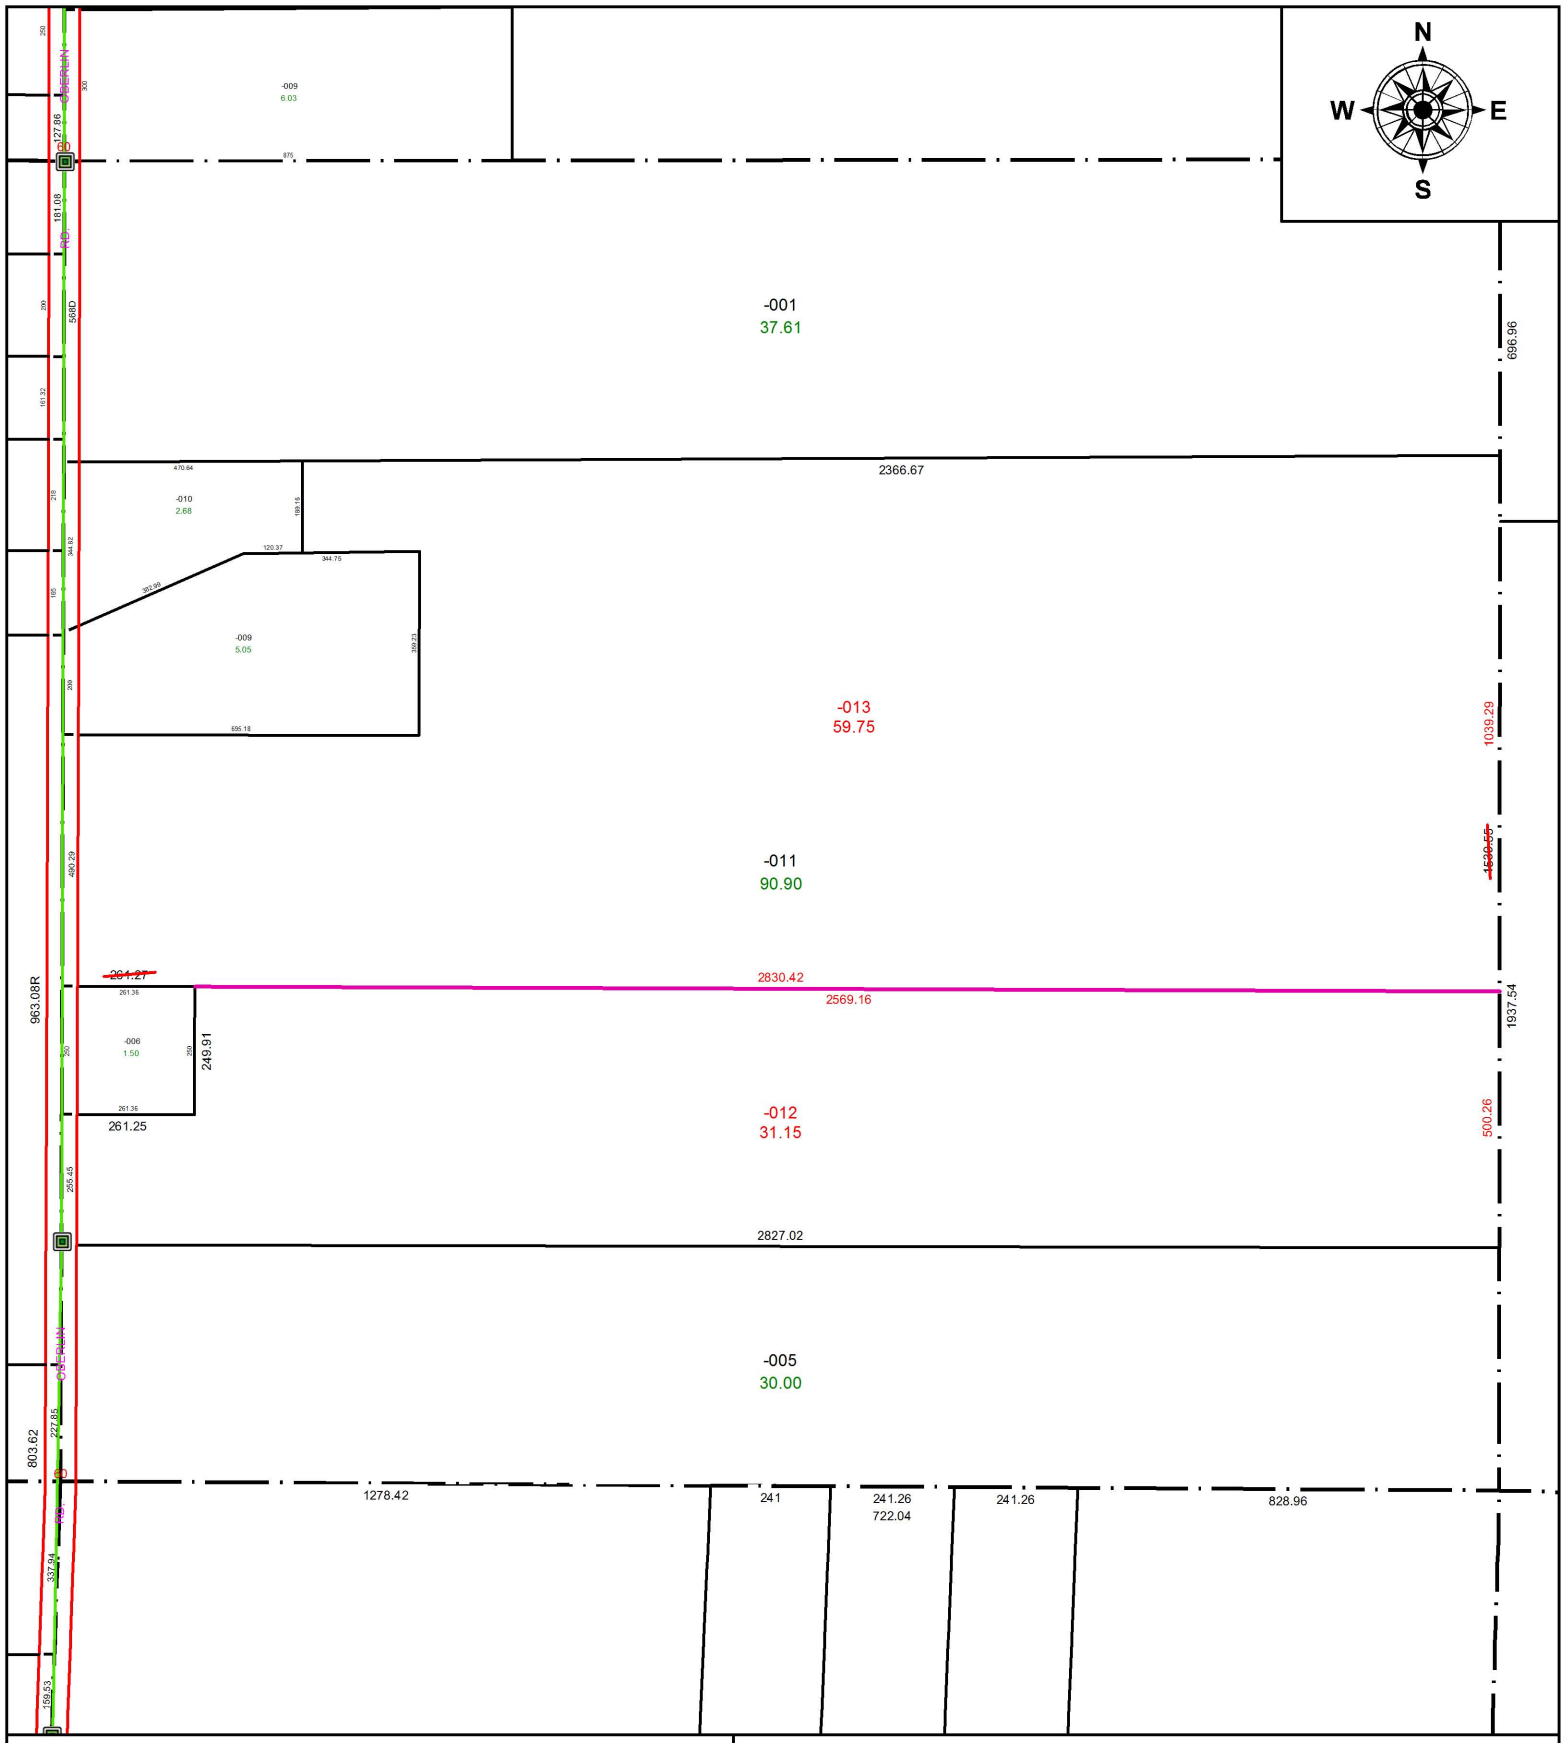

SPLITS/DEEDS PROCESSED

LORAIN COUNTY TAX MAP DEPARTMENT
226 MIDDLE AVE. ELYRIA, OH

SURVEYED BY: RICHARD D. CARLSON
CLOSURE: 1:1,084,391
MAP PAGE(S): 9-00-048
APPOVED BY: RRM **DATE:** 4-18-19
SCALE: 1" = 375 **PRIOR INSTRUMENT:** 20170621874