PARENT PARCEL: 20-05-002-000-013, -017, 20-05-003-000-008, -012

CHILD PARCEL: XX-XX-XXX-XXX-XXX

STARTING POINT: INTERSECTION OF C/L OF QUARRY RD. AND C/L OF BURSLEY RD.

18-03961-C

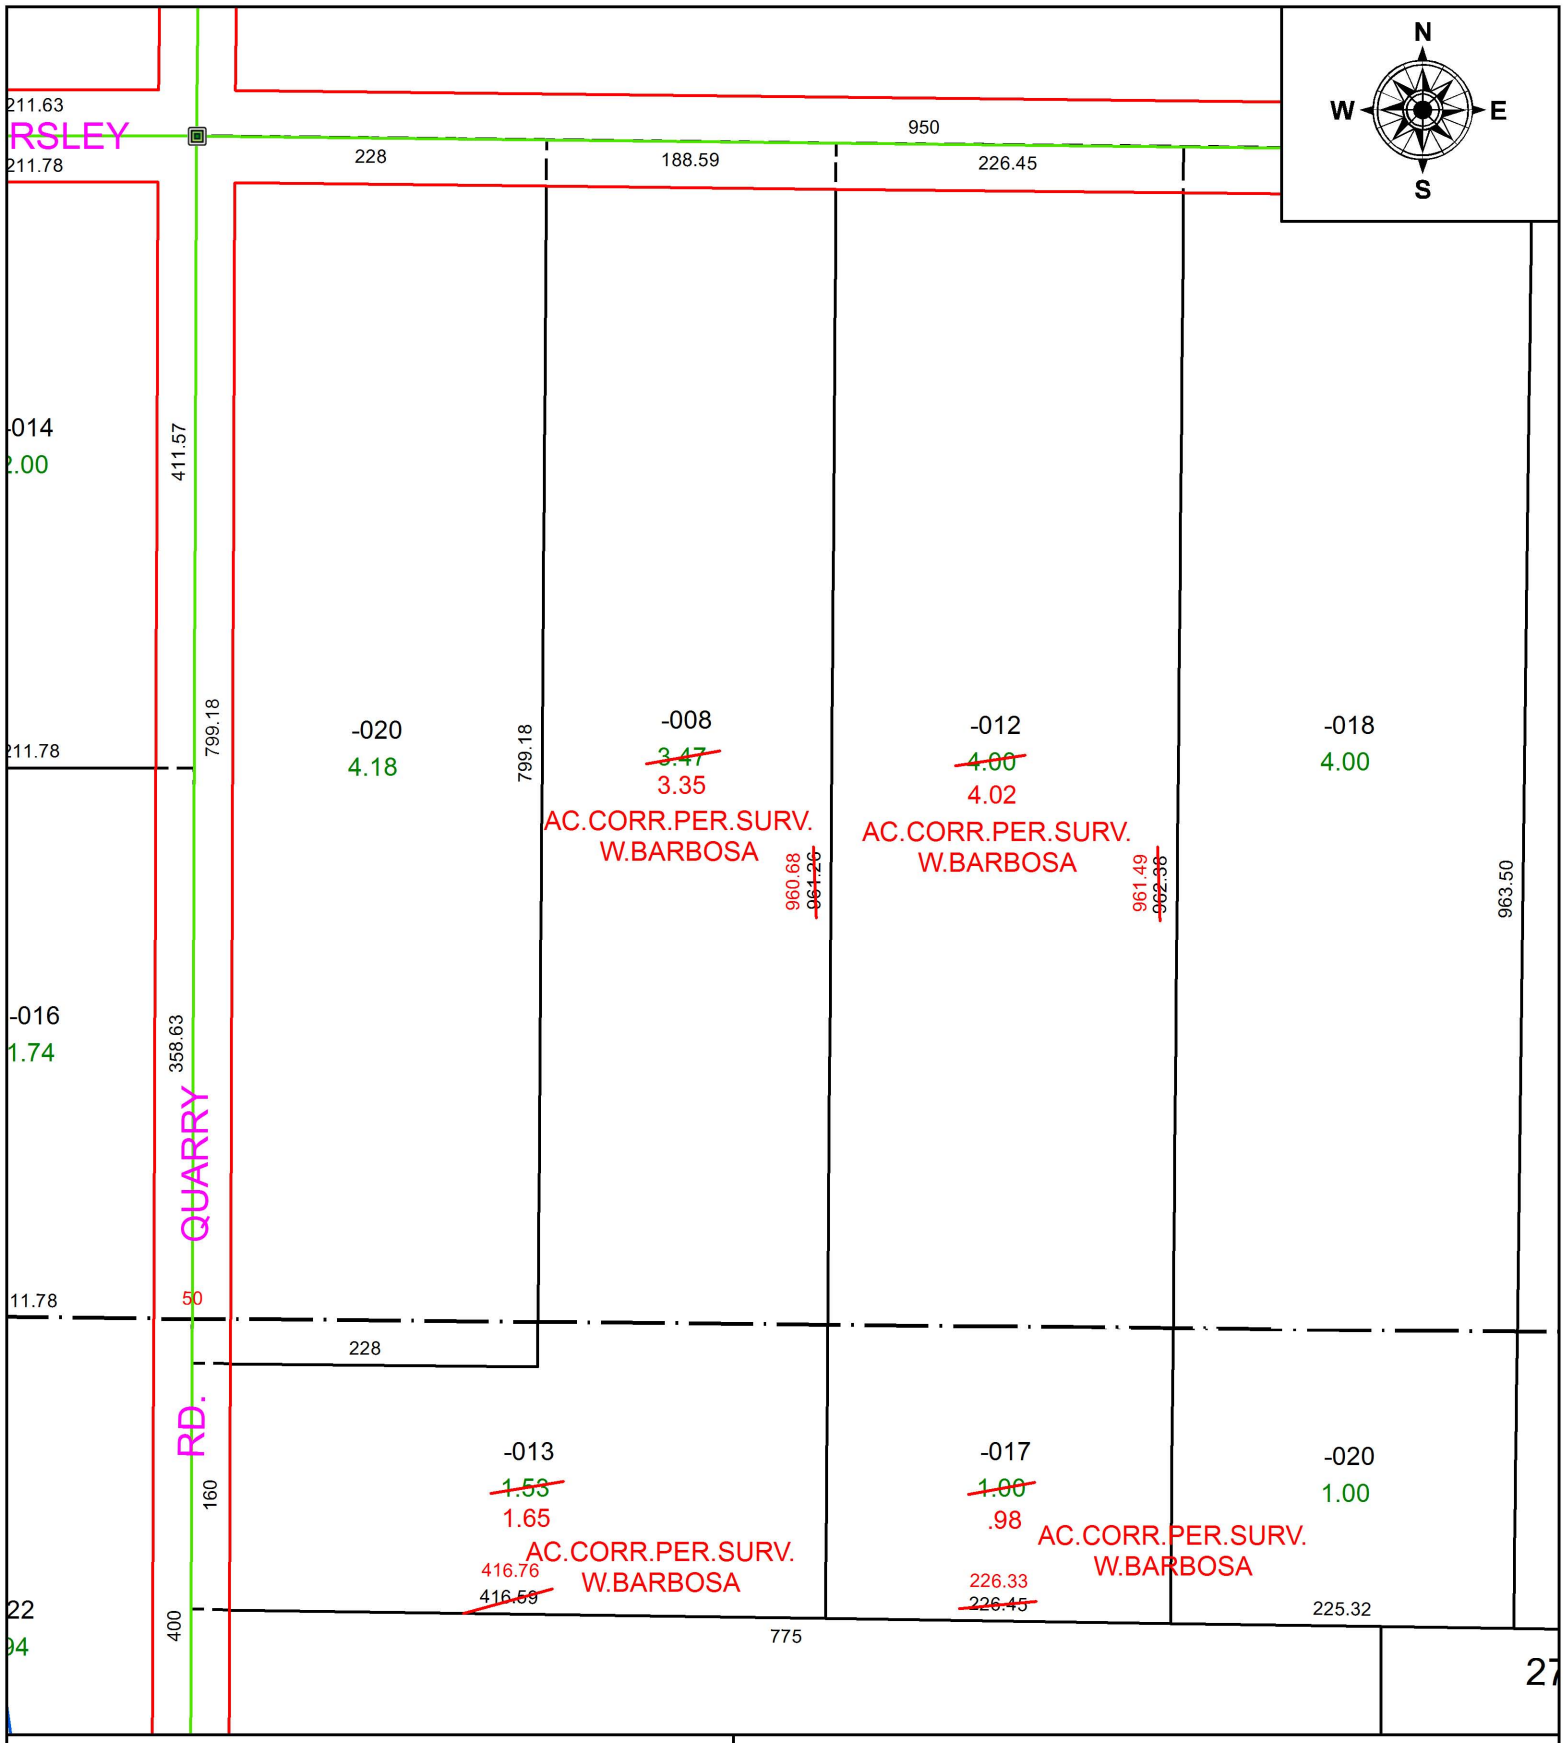

SPLITS/DEEDS PROCESSED

LORAIN COUNTY TAX MAP DEPARTMENT
226 MIDDLE AVE. ELYRIA, OH

SURVEYED BY: WILFREDO BARBOSA
CLOSURE: 1: 1,281,739
MAP PAGE(S): 20-D
APPOVED BY: RRM **DATE:** 10-3-18
SCALE: 1" = 125 **PRIOR INSTRUMENT:** 20170616488