PARENT PARCEL: 19-01-023-000-001

CHILD PARCEL: 19-01-023-000-004, -005

STARTING POINT: INTERSECTION OF NORTH LINE OF O.L. 23 AND C/L OF S.R. 301

19-03961

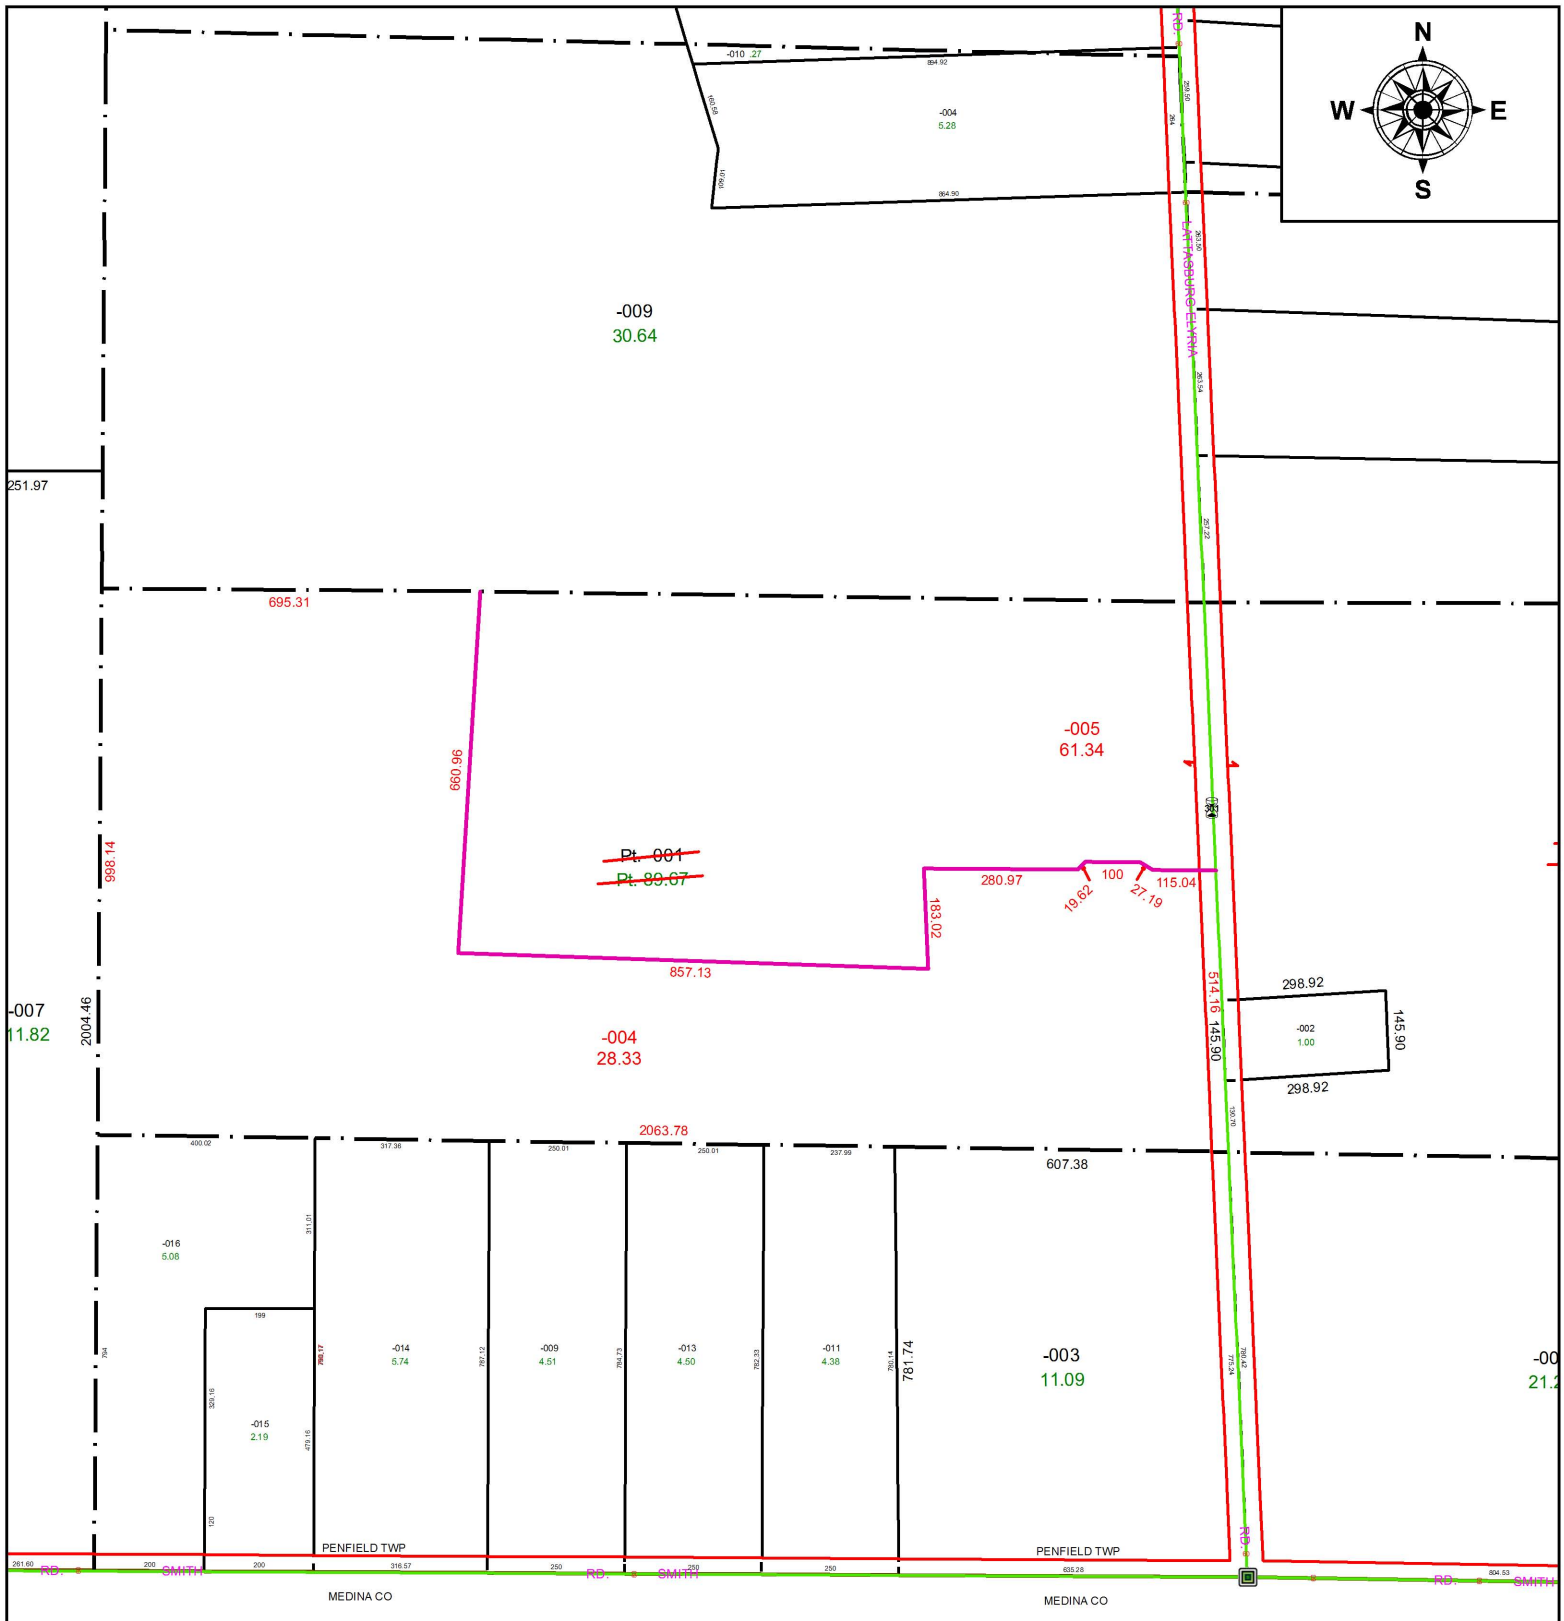

SPLITS/DEEDS PROCESSED

LORAIN COUNTY TAX MAP DEPARTMENT
226 MIDDLE AVE. ELYRIA, OH

SURVEYED BY: TIMOTHY D. HOZALSKI
CLOSURE: 1: 644,232
MAP PAGE(S): 19-01-023
APPOVED BY: RRM **DATE:** 4-29-19
SCALE: 1" = 350 **PRIOR INSTRUMENT:** 20180685126