PARENT PARCEL: 01-00-004-120-062
CHILD PARCEL: 01-00-004-120-063, -064
STARTING POINT: INTERSECTION OF C/L OF SUNNYSIDE RD. AND C/L OF ROANOKE DR..

19-03964

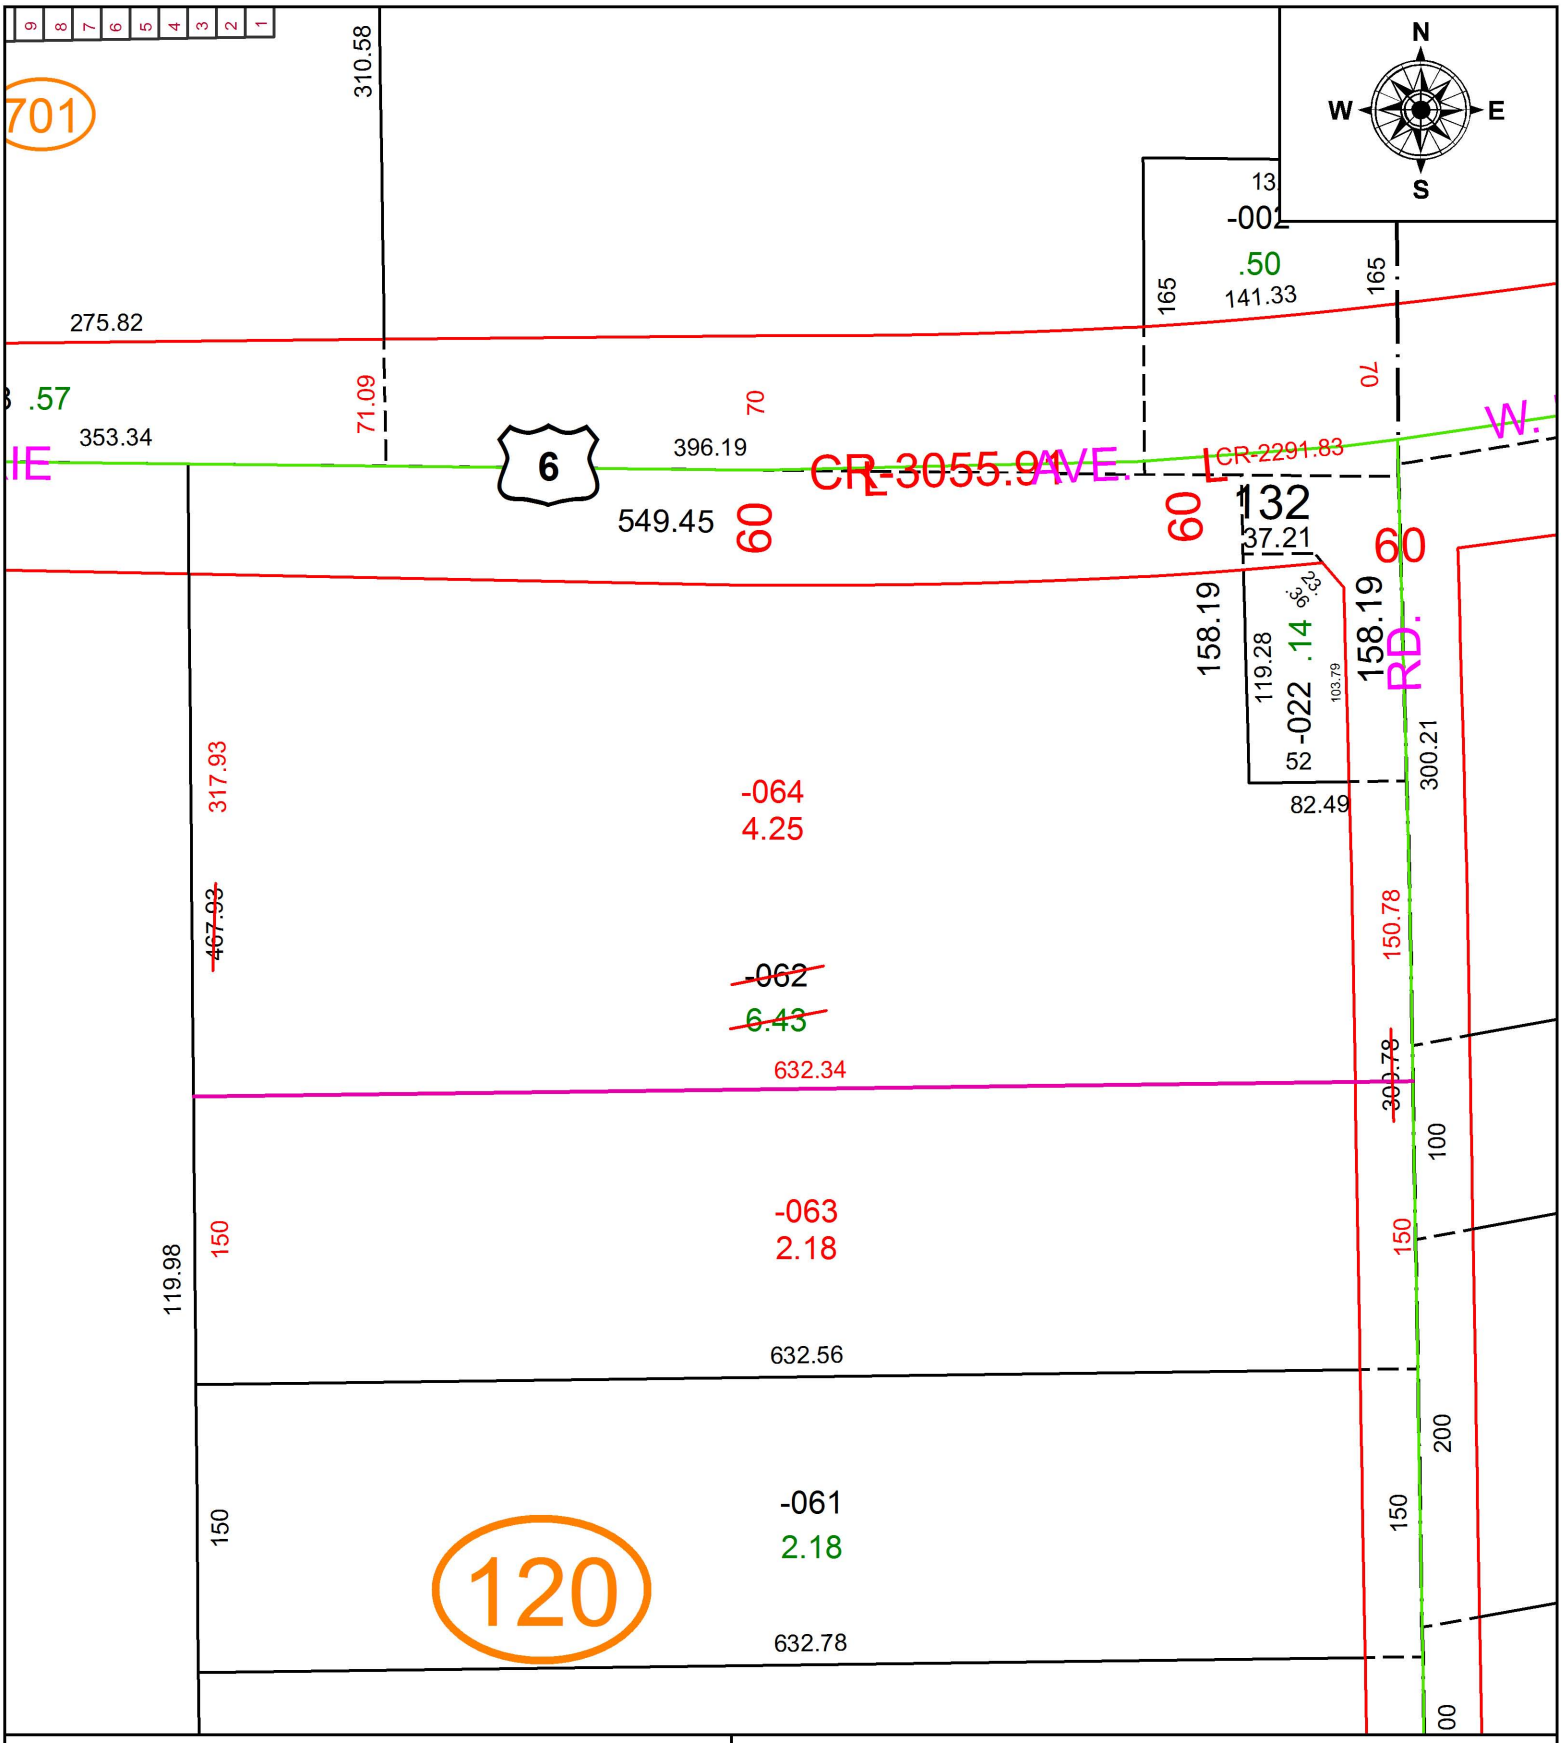

SPLITS/DEEDS PROCESSED
LORAIN COUNTY TAX MAP DEPARTMENT
226 MIDDLE AVE. ELYRIA, OH

SURVEYED BY: ALEX E. MARKS
CLOSURE: 1: 850,133
MAP PAGE(S): 1-00-004
APPOVED BY: RRM **DATE:** 4-29-19
SCALE: 1" = 100 **PRIOR INSTRUMENT:** 20180684222