PARENT PARCEL: ADD TO DUPLICATE & DEPTH CORR.

CHILD PARCEL: 05-00-012-900-005

STARTING POINT: B. GREBE'S SUBDIVISION PLAT VOL. 8 PG. 17

18-03966-A

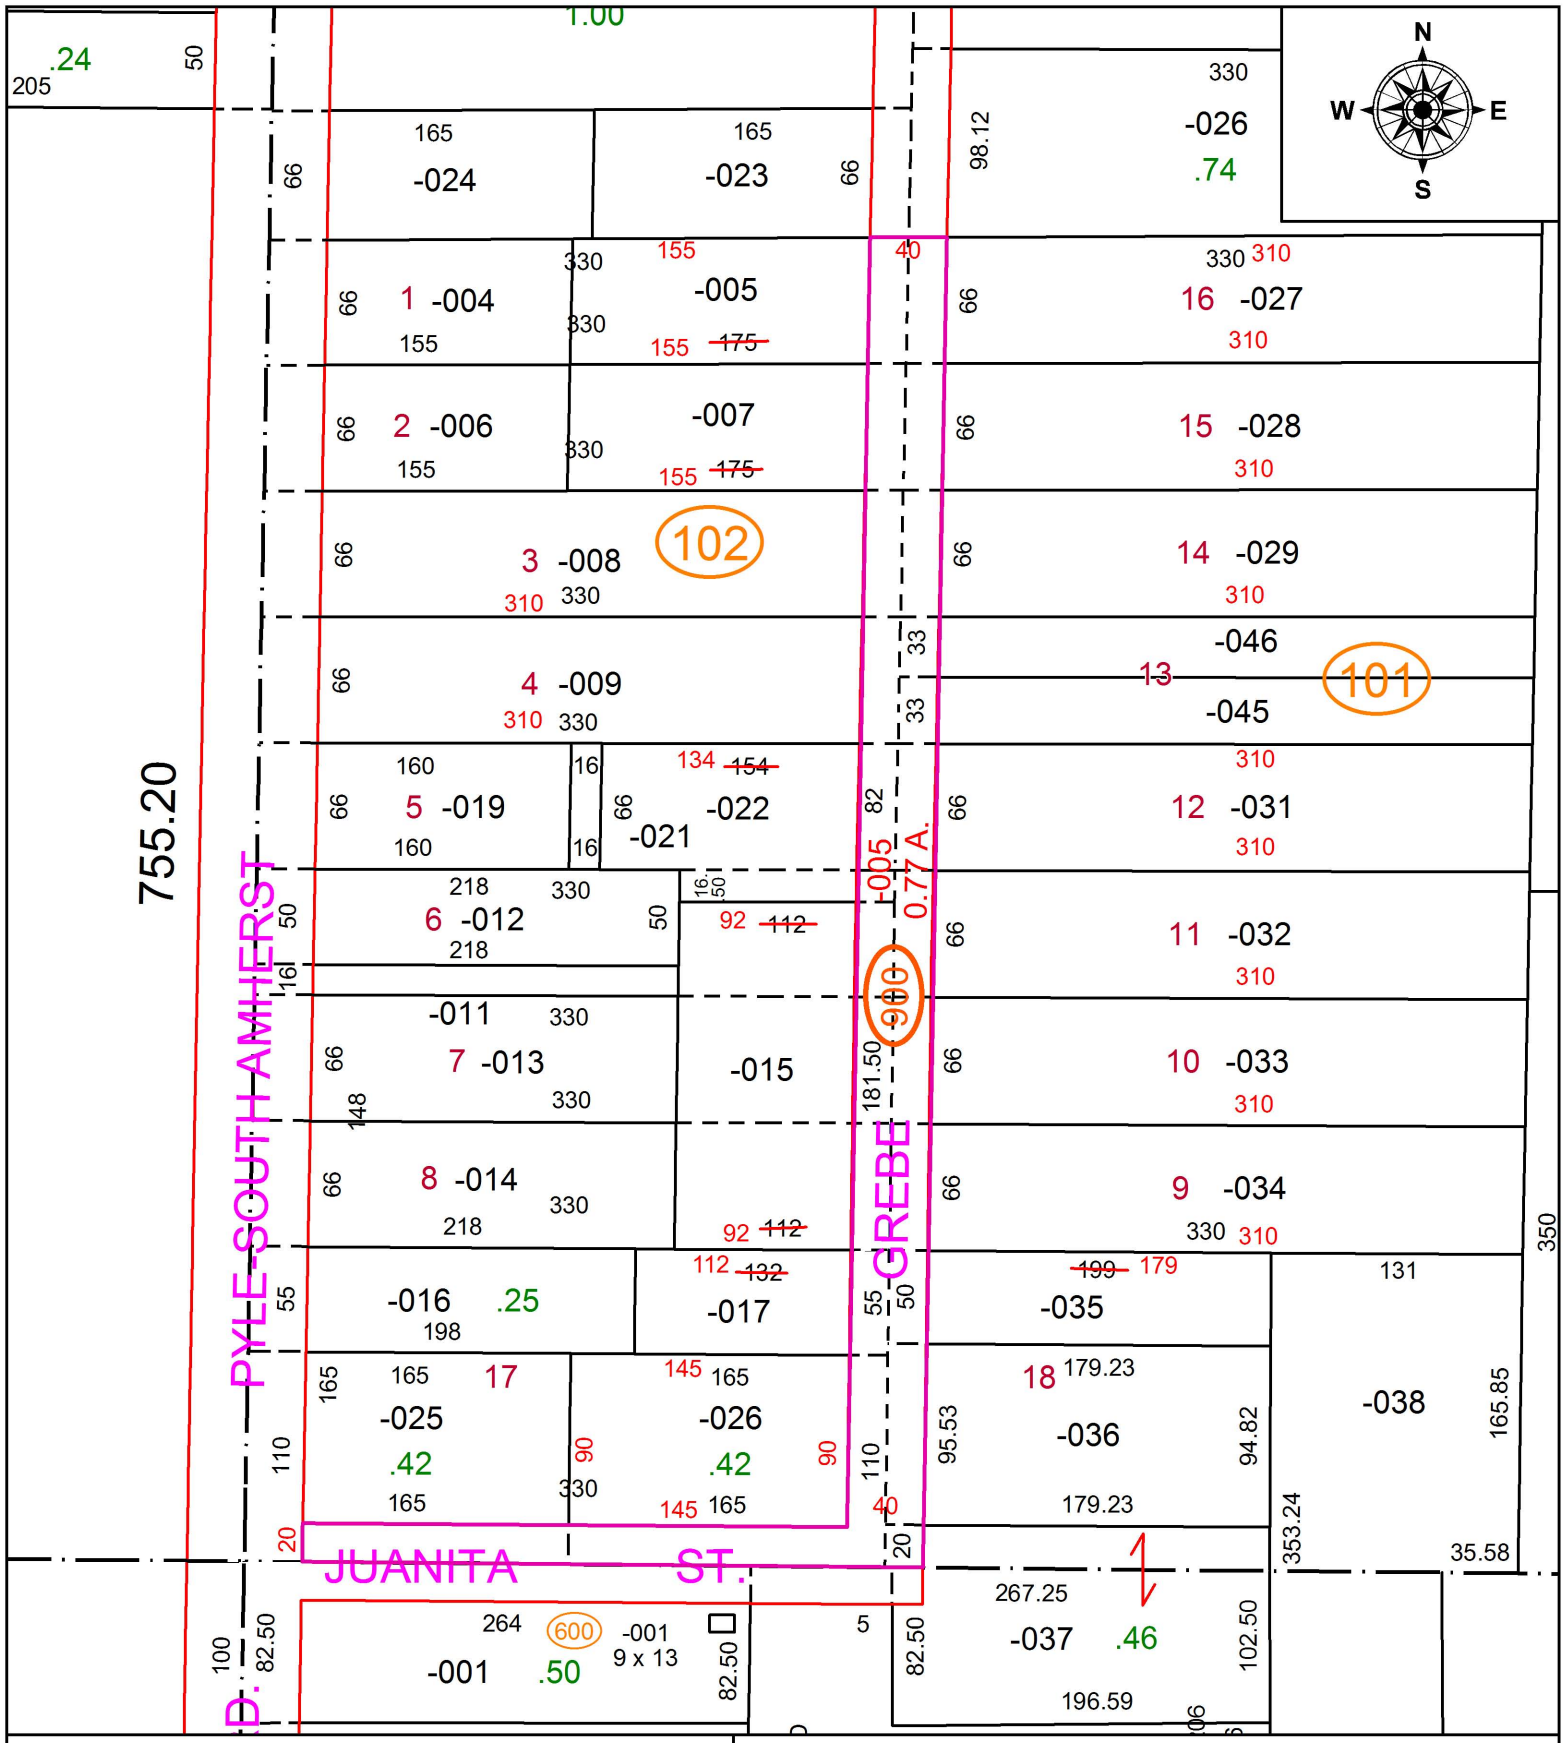

SPLITS/DEEDS PROCESSED

LORAIN COUNTY TAX MAP DEPARTMENT
226 MIDDLE AVE. ELYRIA, OH

SURVEYED BY: NA

CLOSURE: NA

MAP PAGE(S): 05-00-012

APPOVED BY: TJS **DATE:** 10/3/18

SCALE: 1" = 100' **PRIOR INSTRUMENT:** DV XXXX/XXXX