PARENT PARCEL: 07-00-013-000-026, -037

CHILD PARCEL:

STARTING POINT: INTERSECTION OF C/L OF ISLAND RD. AND C/L OF LORAIN RD.

18-03967-C

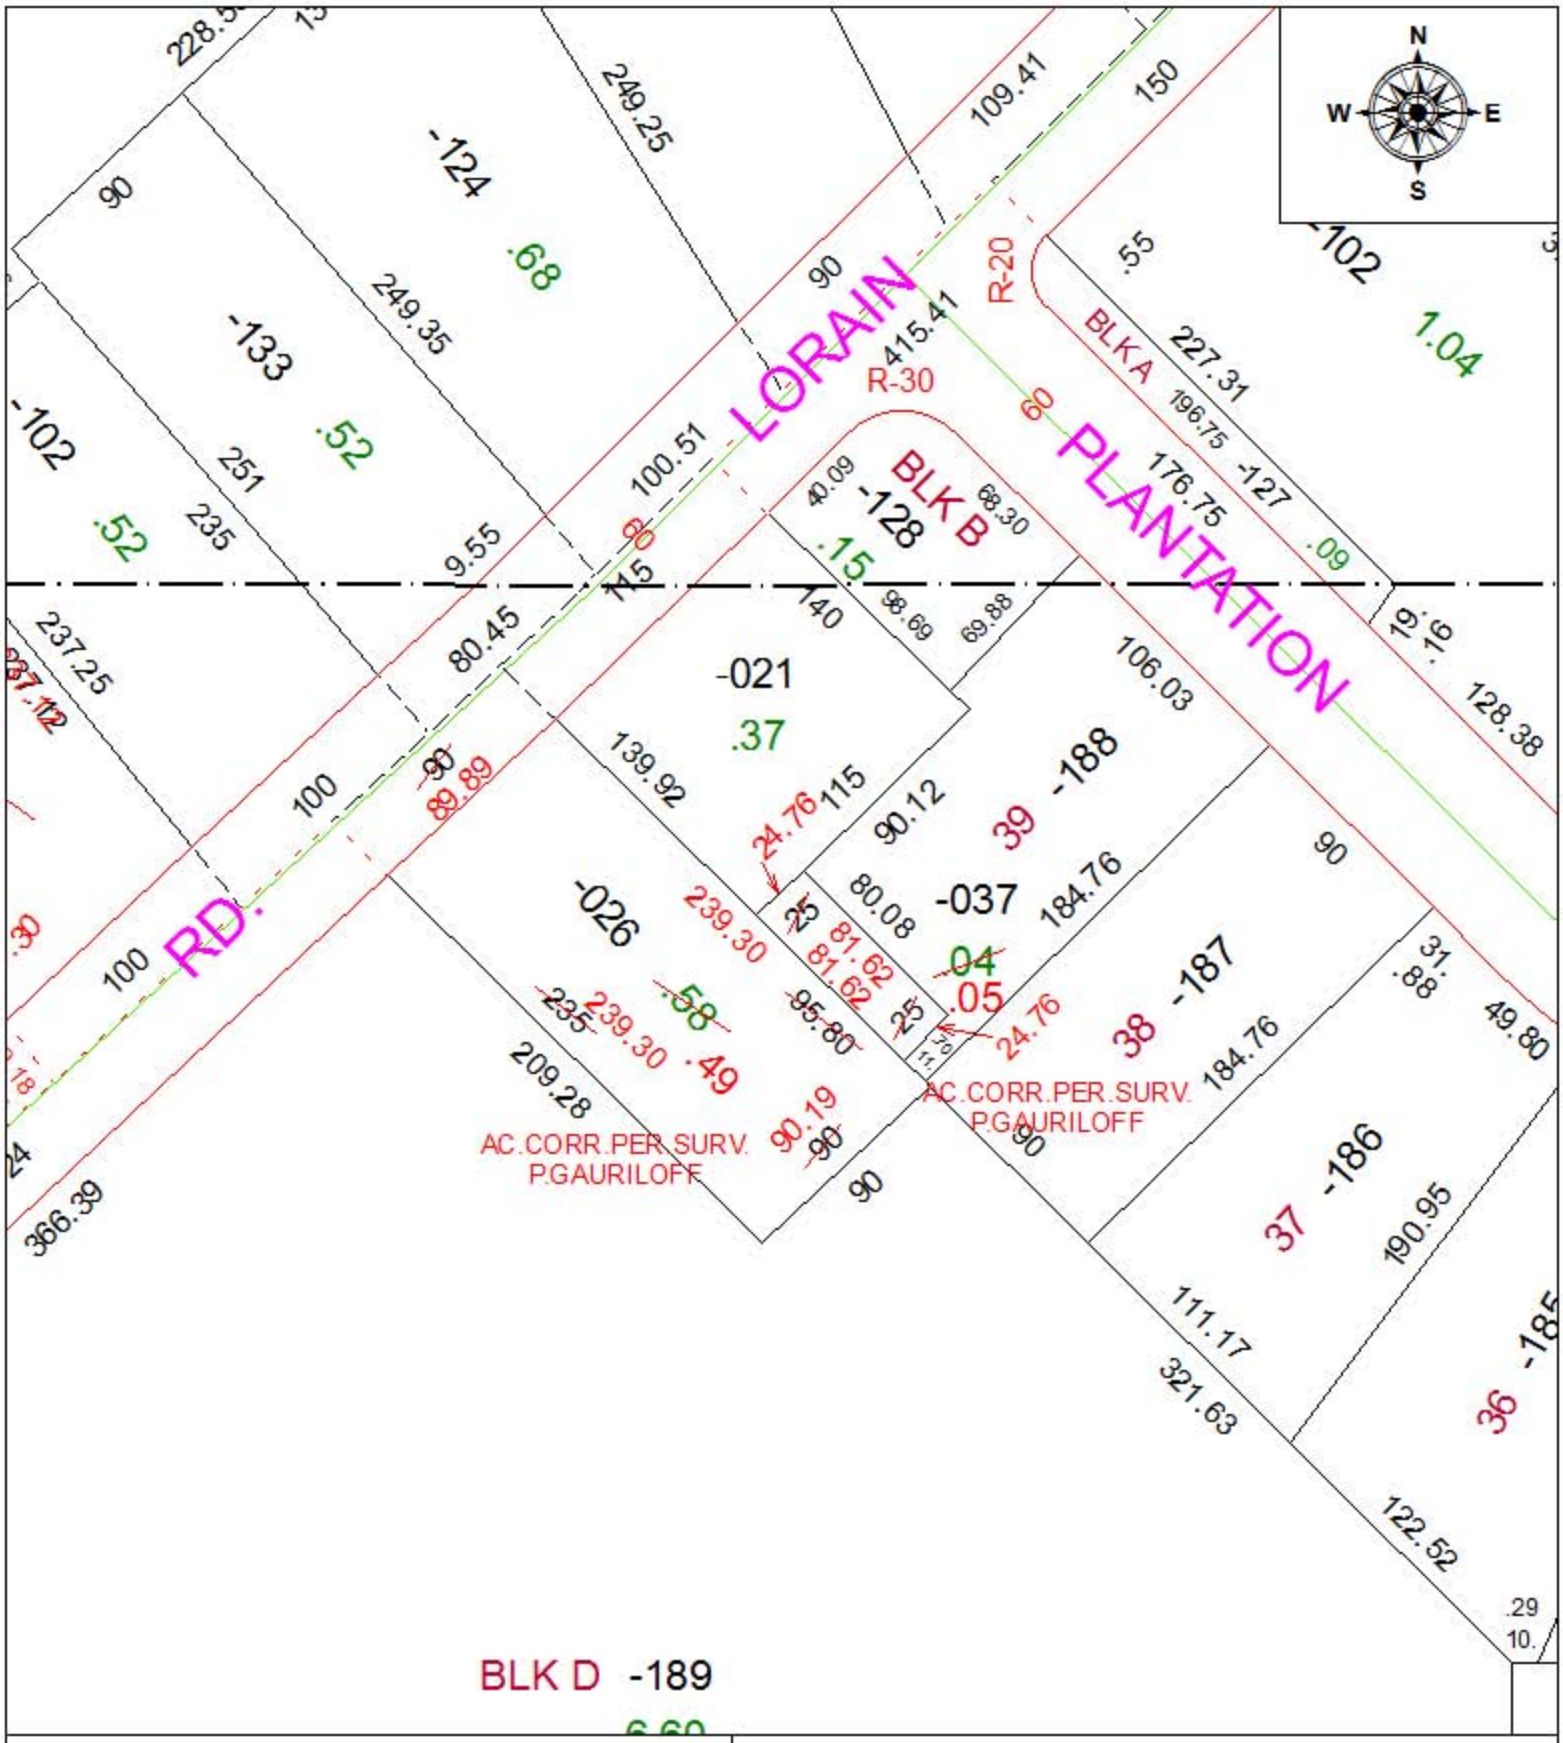

SPLITS/DEEDS PROCESSED

LORAIN COUNTY TAX MAP DEPARTMENT
226 MIDDLE AVE. ELYRIA, OH

SURVEYED BY: PETER JOHN GAURILOFF

CLOSURE: 1: 124,304

MAP PAGE(S): 7-00-013

APPOVED BY: RRM DATE: 10-3-18

SCALE: 1" = 75 PRIOR INSTRUMENT: 20160587371