PARENT PARCEL: 06-25-007-000-029, -031, -178

CHILD PARCEL: 06-25-007-000-272

STARTING POINT: INTERSECTION OF C/L OF ABBE RD. AND C/L OF EAST BROAD ST.

19-03967

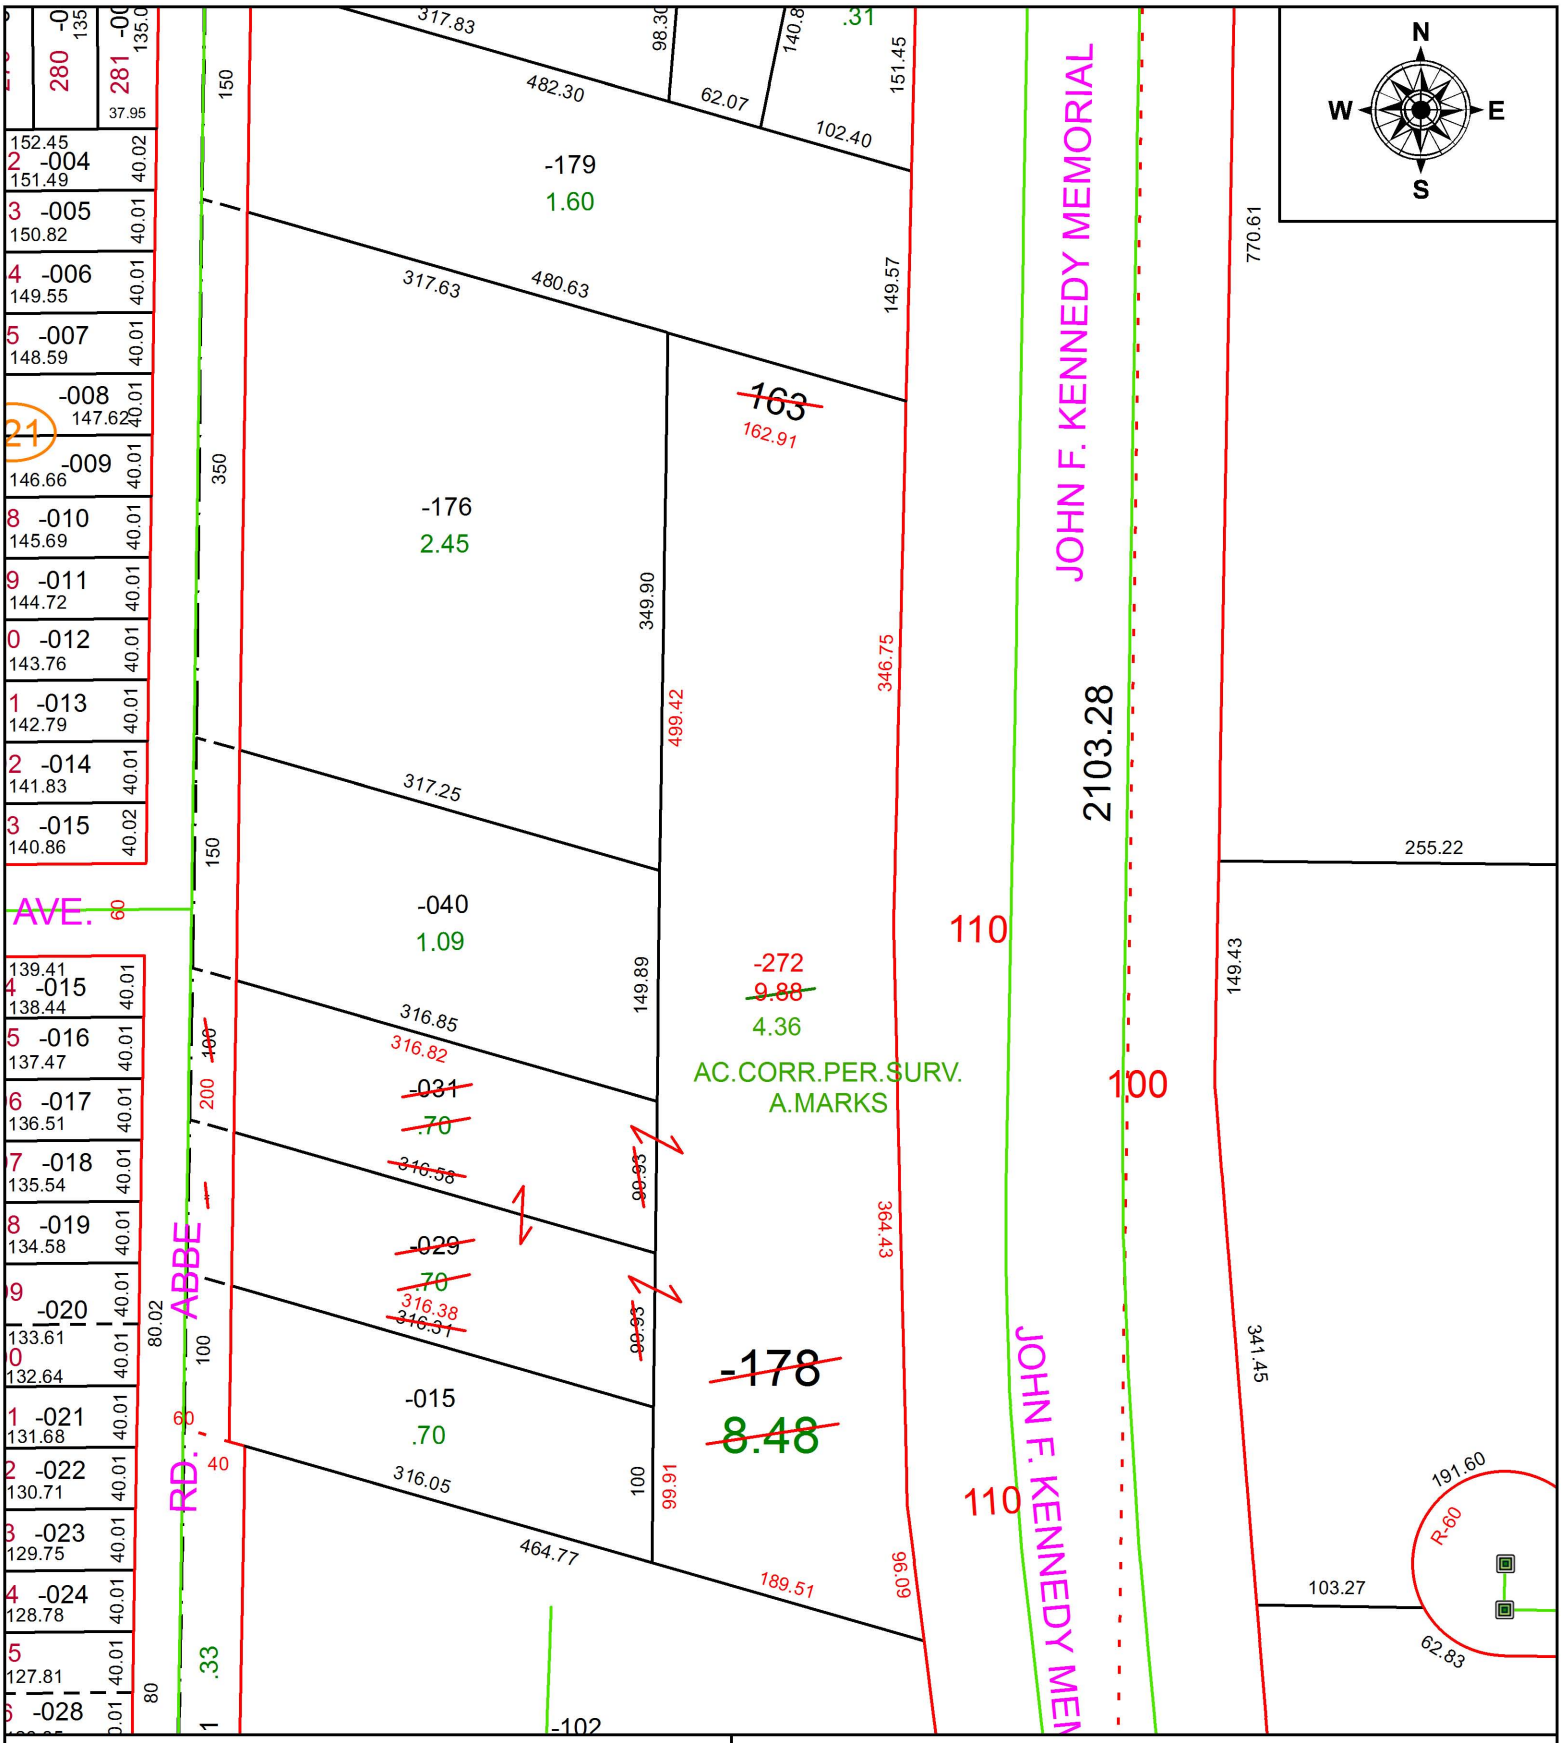

SPLITS/DEEDS PROCESSED

LORAIN COUNTY TAX MAP DEPARTMENT
226 MIDDLE AVE. ELYRIA, OH

SURVEYED BY: ALEX MARKS
CLOSURE: 1:178,469
MAP PAGE(S): 6-25-007
APPOVED BY: RRM **DATE:** 5-13-19
SCALE: 1" = 125 **PRIOR INSTRUMENT:** 20180662480