PARENT PARCEL: 04-00-015-103-060, -061

CHILD PARCEL:

STARTING POINT: INTERSECTION OF C/L OF CENTER RD. AND C/L OF DETROIT RD.

18-03968-C

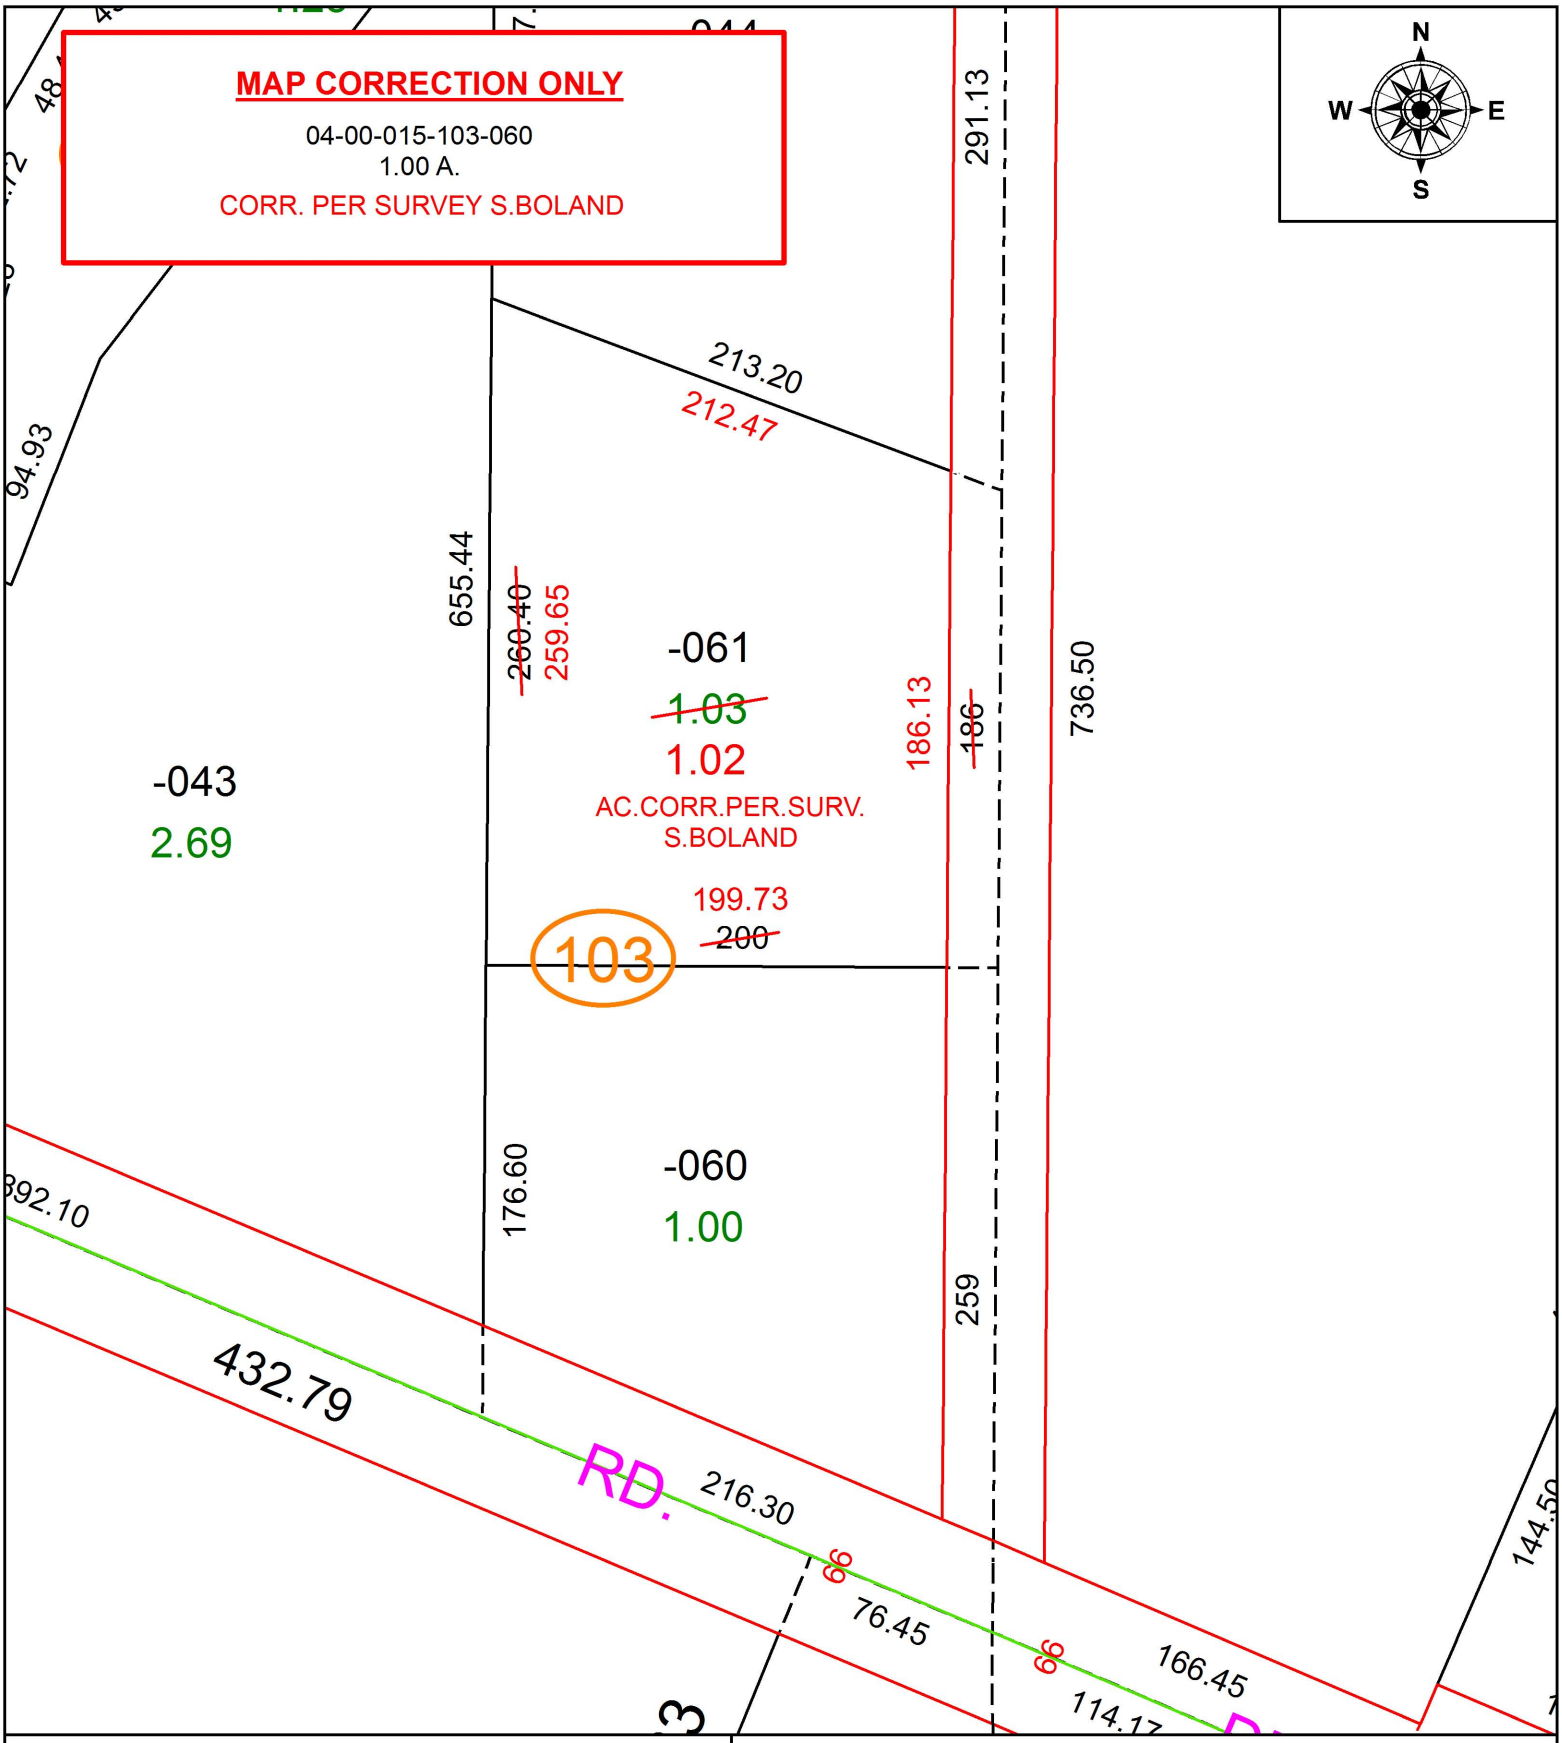

SPLITS/DEEDS PROCESSED

LORAIN COUNTY TAX MAP DEPARTMENT
226 MIDDLE AVE. ELYRIA, OH

SURVEYED BY: SEAN A. BOLAND
CLOSURE: 1: 333,003
MAP PAGE(S): 4-00-015
APPOVED BY: RRM **DATE:** 10-15-18
SCALE: 1" = 75 **PRIOR INSTRUMENT:** 20110383347