PARENT PARCEL: 05-00-065-000-005, -006
CHILD PARCEL: 05-00-065-000-043
STARTING POINT: INTERSECTION OF C/L OF PENNSYLVANIA R.R. AND C/L OF OBERLIN RD.

19-03969

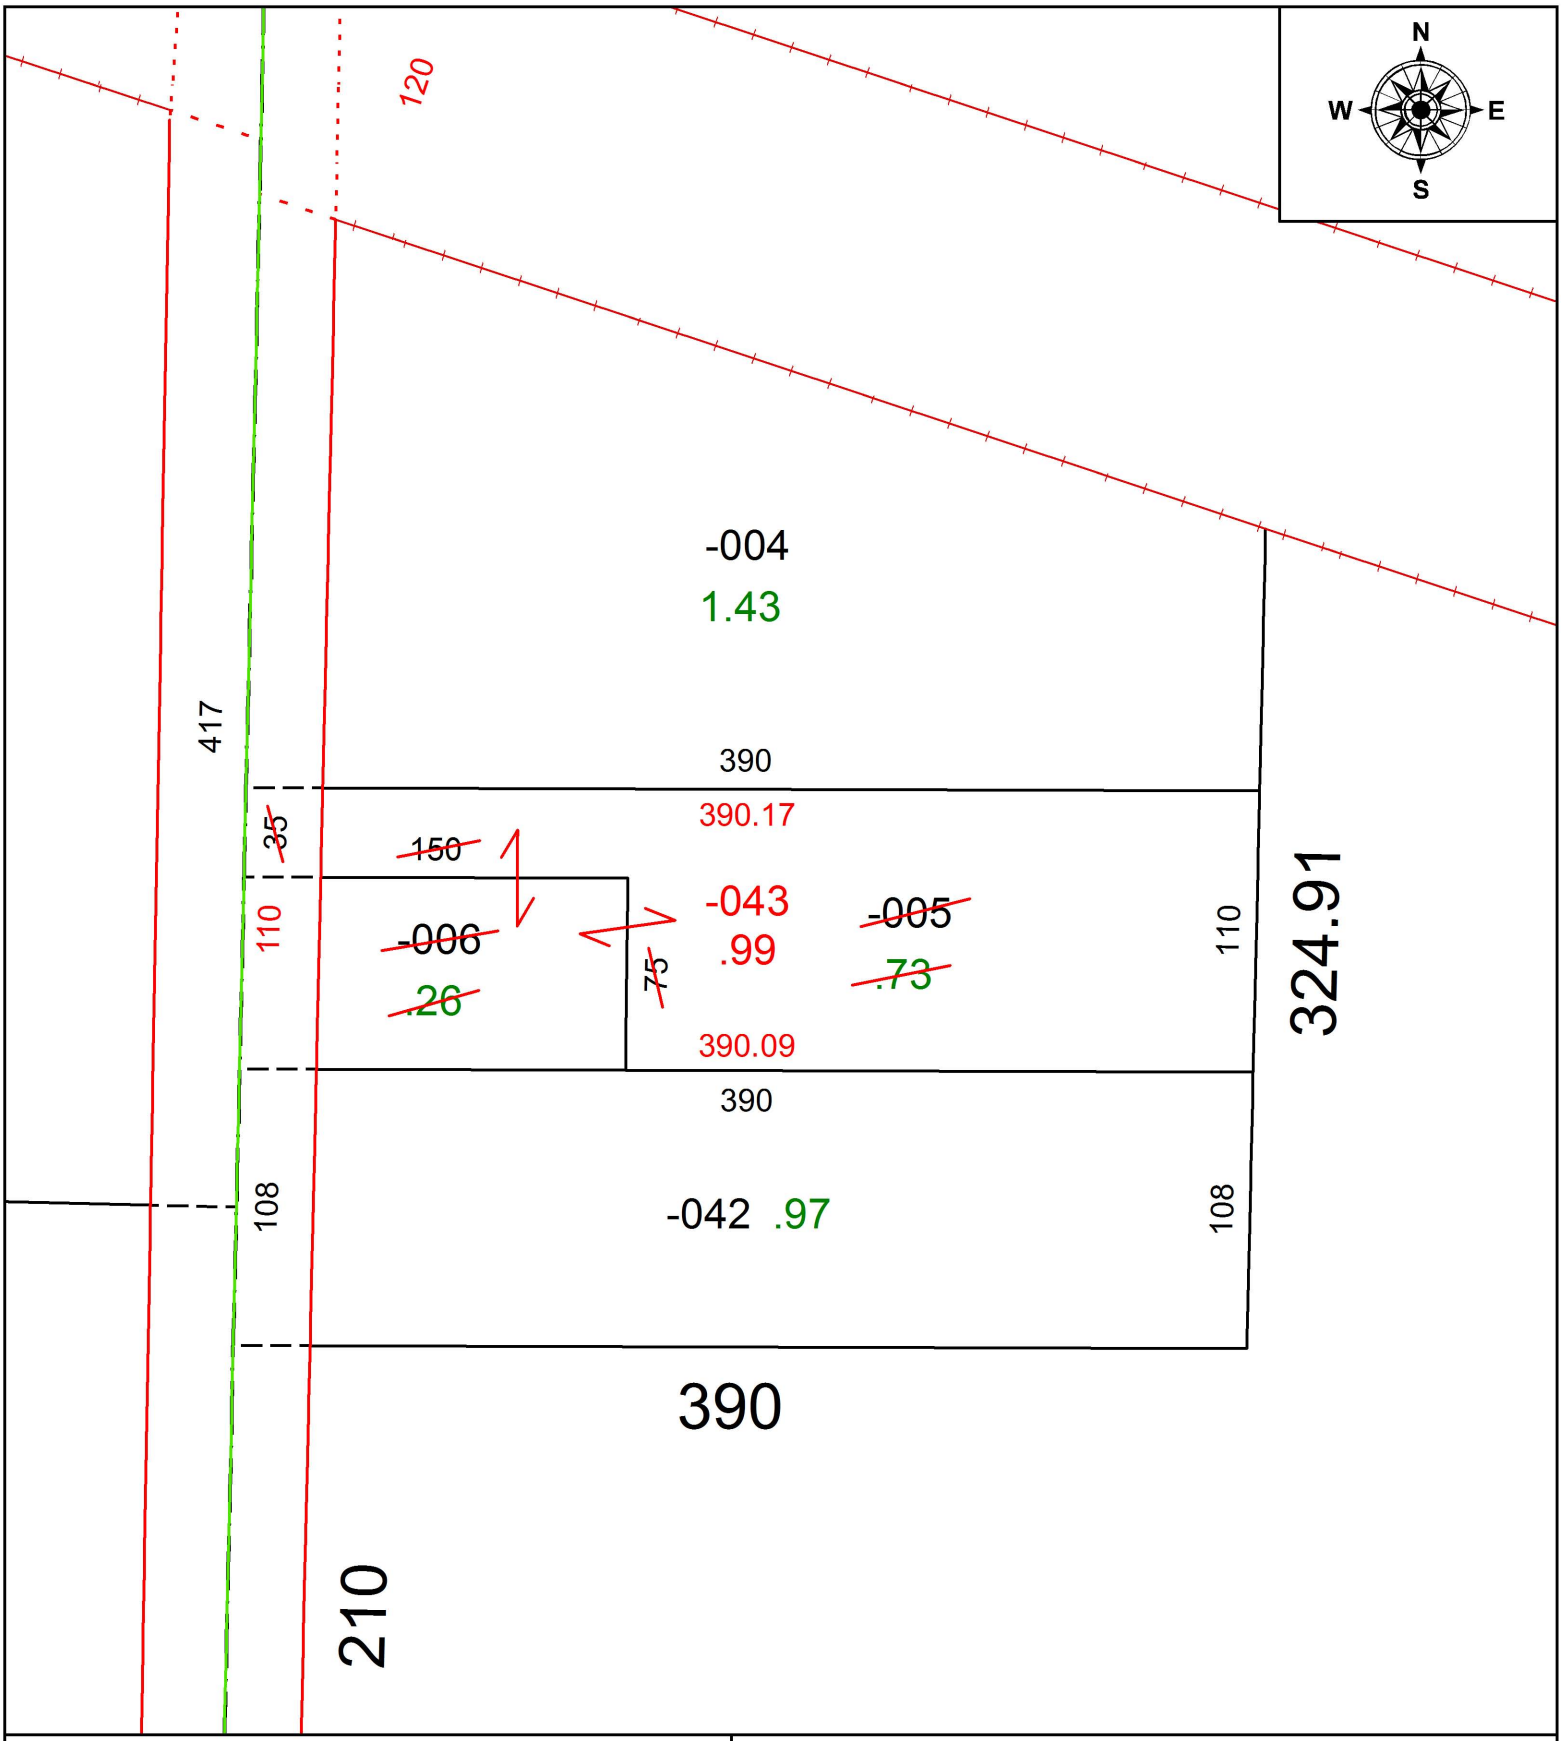

SPLITS/DEEDS PROCESSED
LORAIN COUNTY TAX MAP DEPARTMENT
226 MIDDLE AVE. ELYRIA, OH

SURVEYED BY: SCOTT J. CASEY
CLOSURE: 1:627,349
MAP PAGE(S): 5-00-065
APPOVED BY: RRM **DATE:** 5-10-19
SCALE: 1" = 75 **PRIOR INSTRUMENT:** 20190709459