PARENT PARCEL: 21-15-000-000-003, -004

CHILD PARCEL:

STARTING POINT: INTERSECTION OF C/L OF STEWART RD. AND WEST LINE OF TR. 15

18-03976-A

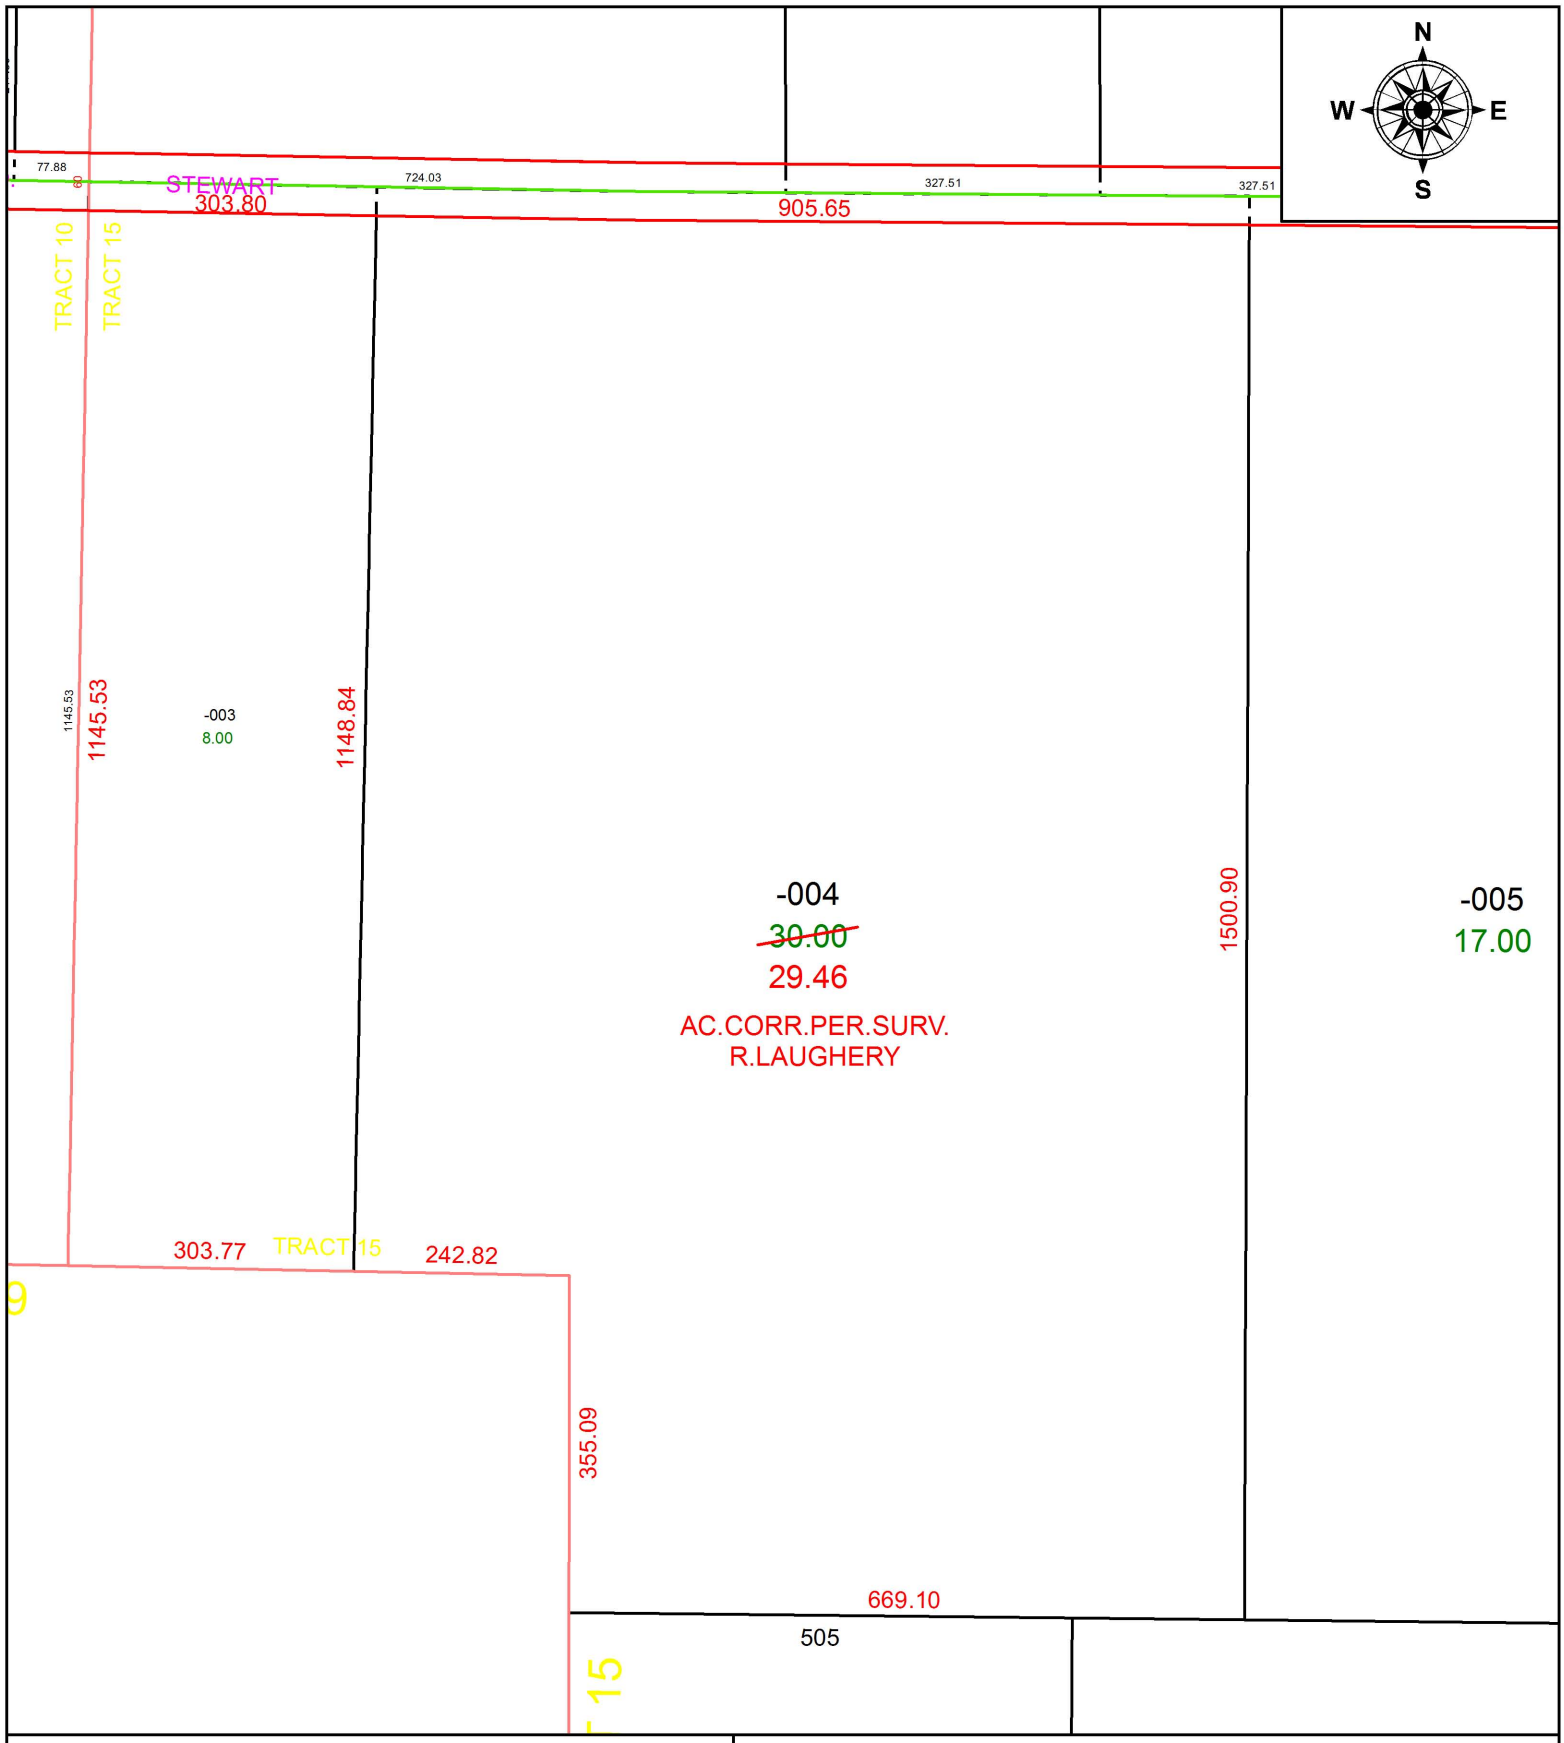

SPLITS/DEEDS PROCESSED

LORAIN COUNTY TAX MAP DEPARTMENT
226 MIDDLE AVE. ELYRIA, OH

SURVEYED BY: RONALD L. LAUGHERY
CLOSURE: 1: 1,176,683
MAP PAGE(S): 21-15-000
APPOVED BY: RRM **DATE:** 11-7-18
SCALE: 1" = 200 **PRIOR INSTRUMENT:** 20160604010