PARENT PARCEL: 04-00-011-107-003, -098

CHILD PARCEL: 04-00-011-107-249 THRU -251

STARTING POINT: INTERSECTION OF C/L OF LONG RD. AND C/L OF DETROIT RD.

19-03977

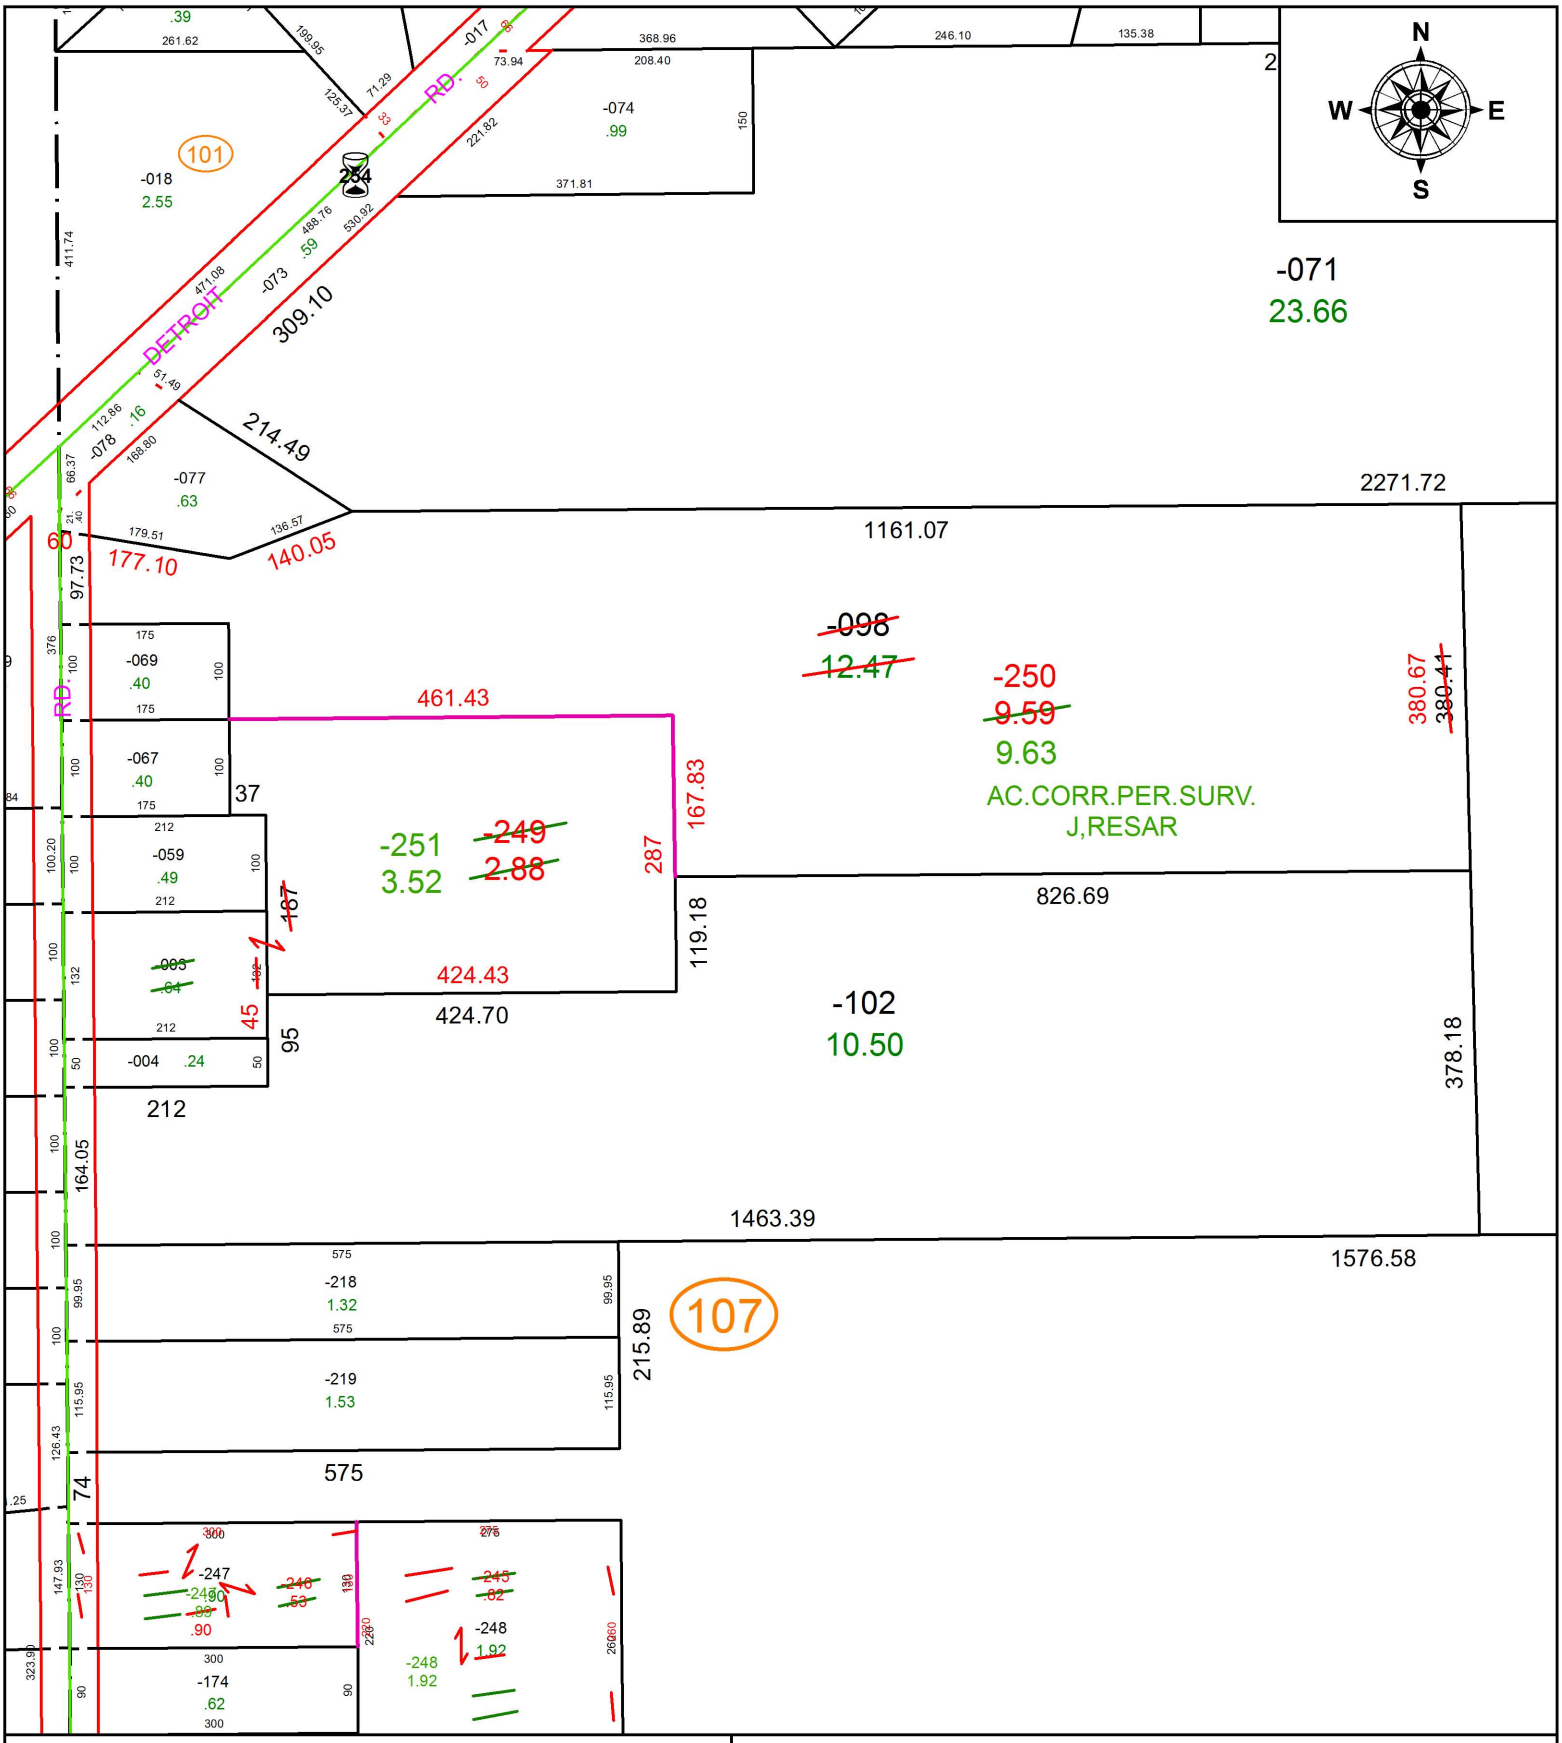

SPLITS/DEEDS PROCESSED

LORAIN COUNTY TAX MAP DEPARTMENT
226 MIDDLE AVE. ELYRIA, OH

SURVEYED BY: JAMES A. RESAR
CLOSURE: 1: 2,702,381
MAP PAGE(S): 4-00-011
APPOVED BY: RRM **DATE:** 6-3-19
SCALE: 1" = 200 **PRIOR INSTRUMENT:** 20020814444