PARENT PARCEL: 05-00-011-103-017

CHILD PARCEL:

STARTING POINT: INTERSECTION OF C/L OF E. MAIN ST. AND C/L OF VIVAN ST.

18-03979-D

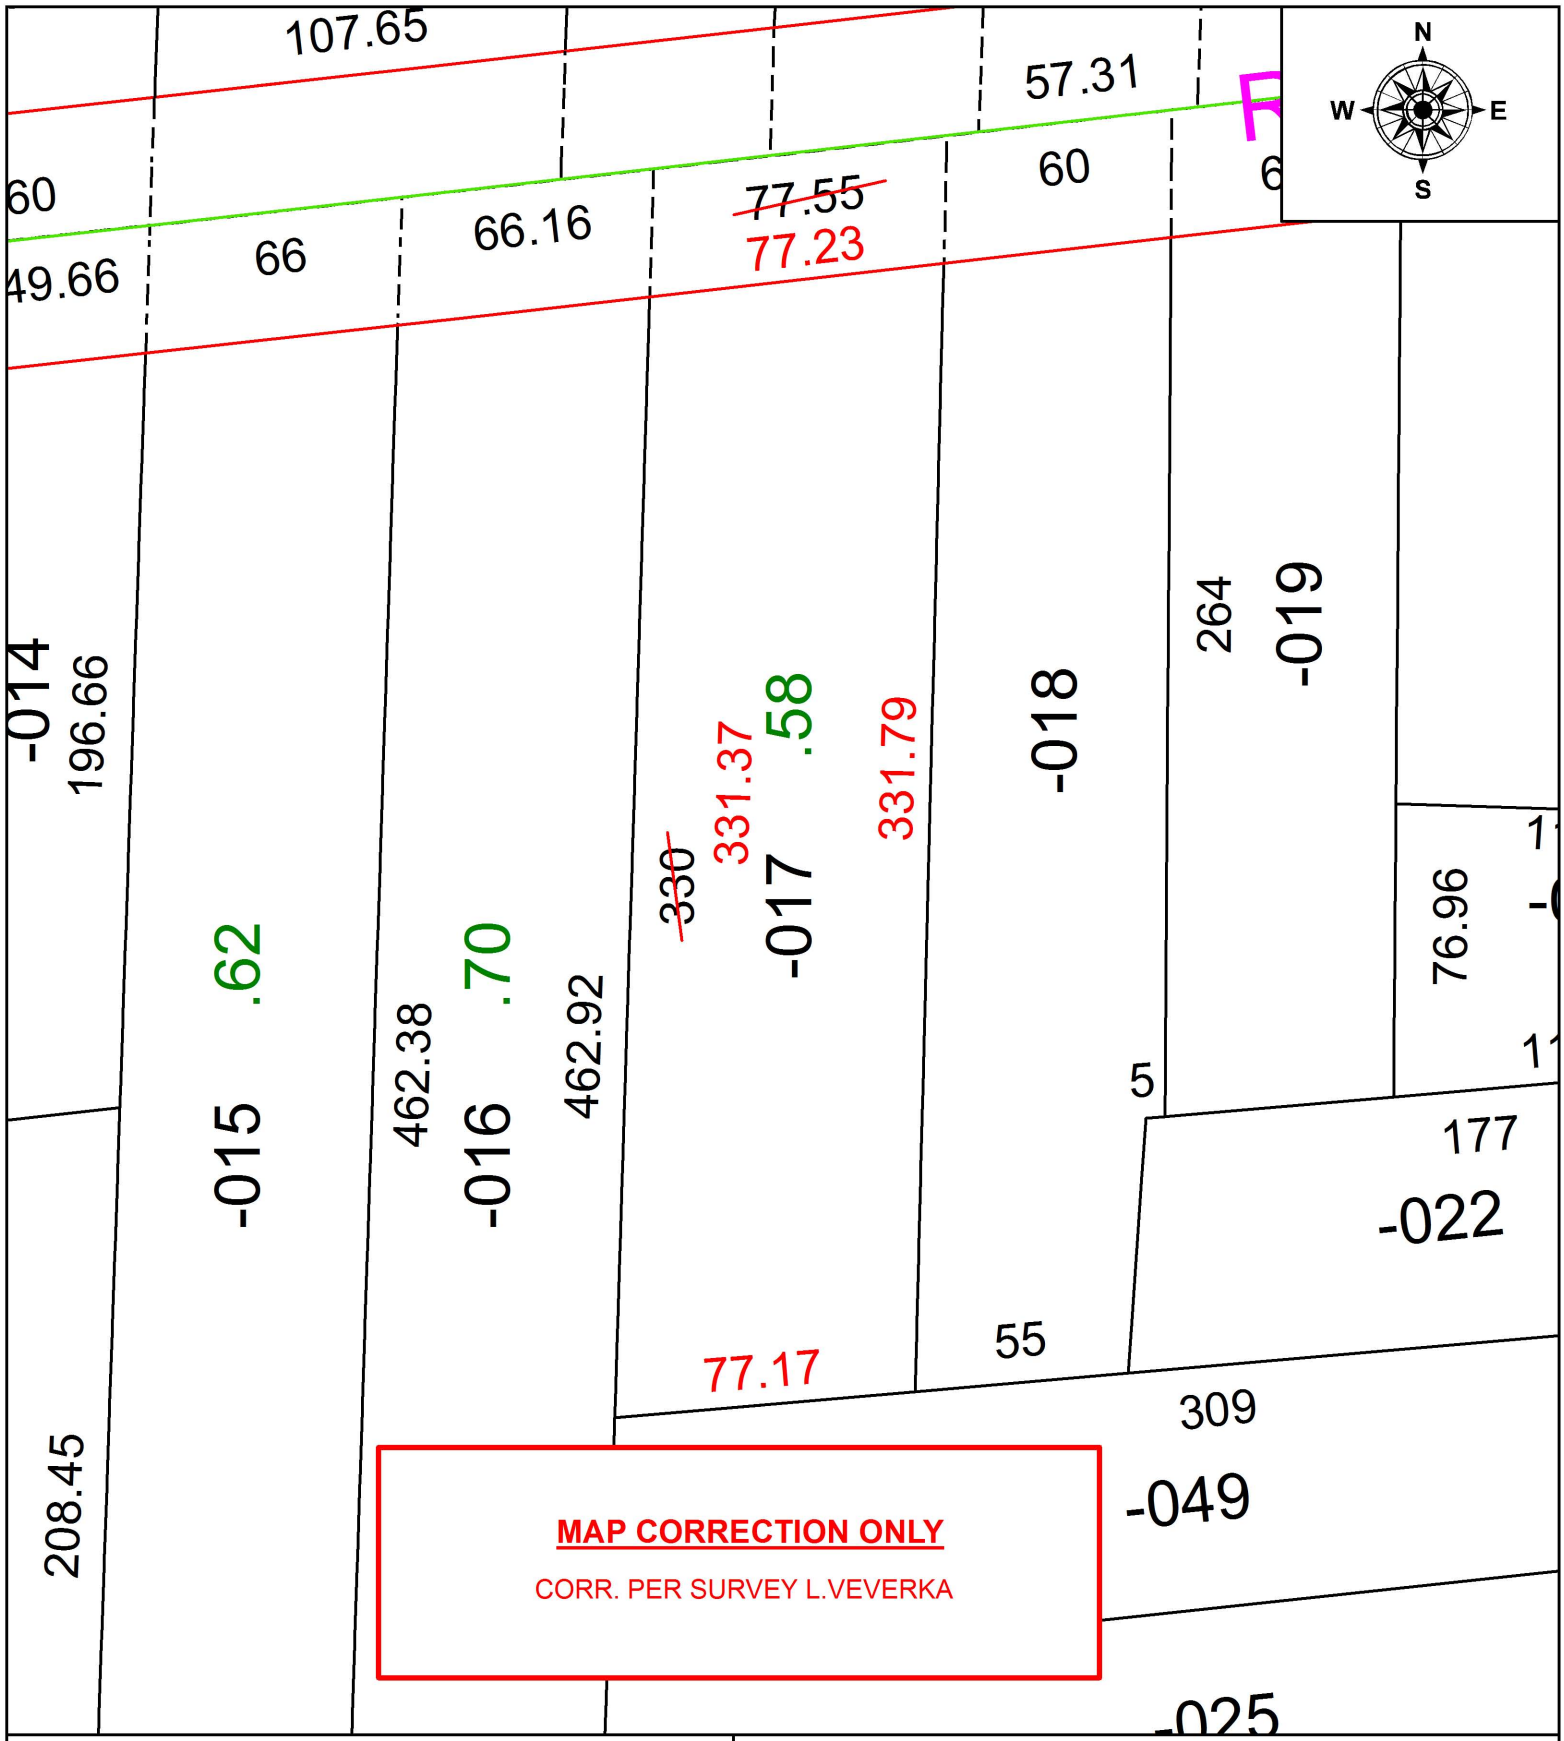

SPLITS/DEEDS PROCESSED

LORAIN COUNTY TAX MAP DEPARTMENT
226 MIDDLE AVE. ELYRIA, OH

SURVEYED BY: LOUISE A. VEVERKA
CLOSURE: 1: 116,814
MAP PAGE(S): 5-00-011
APPOVED BY: RRM **DATE:** 11-13-18
SCALE: 1" = 50 **PRIOR INSTRUMENT:** 20170615292