PARENT PARCEL: 18-00-021-103-028, -029, 18-00-021-104-014, -022

CHILD PARCEL:

STARTING POINT: INTERSECTION OF C/L OF HAMILTON ST. AND C/L OF NORTH MAIN ST.

19-03979

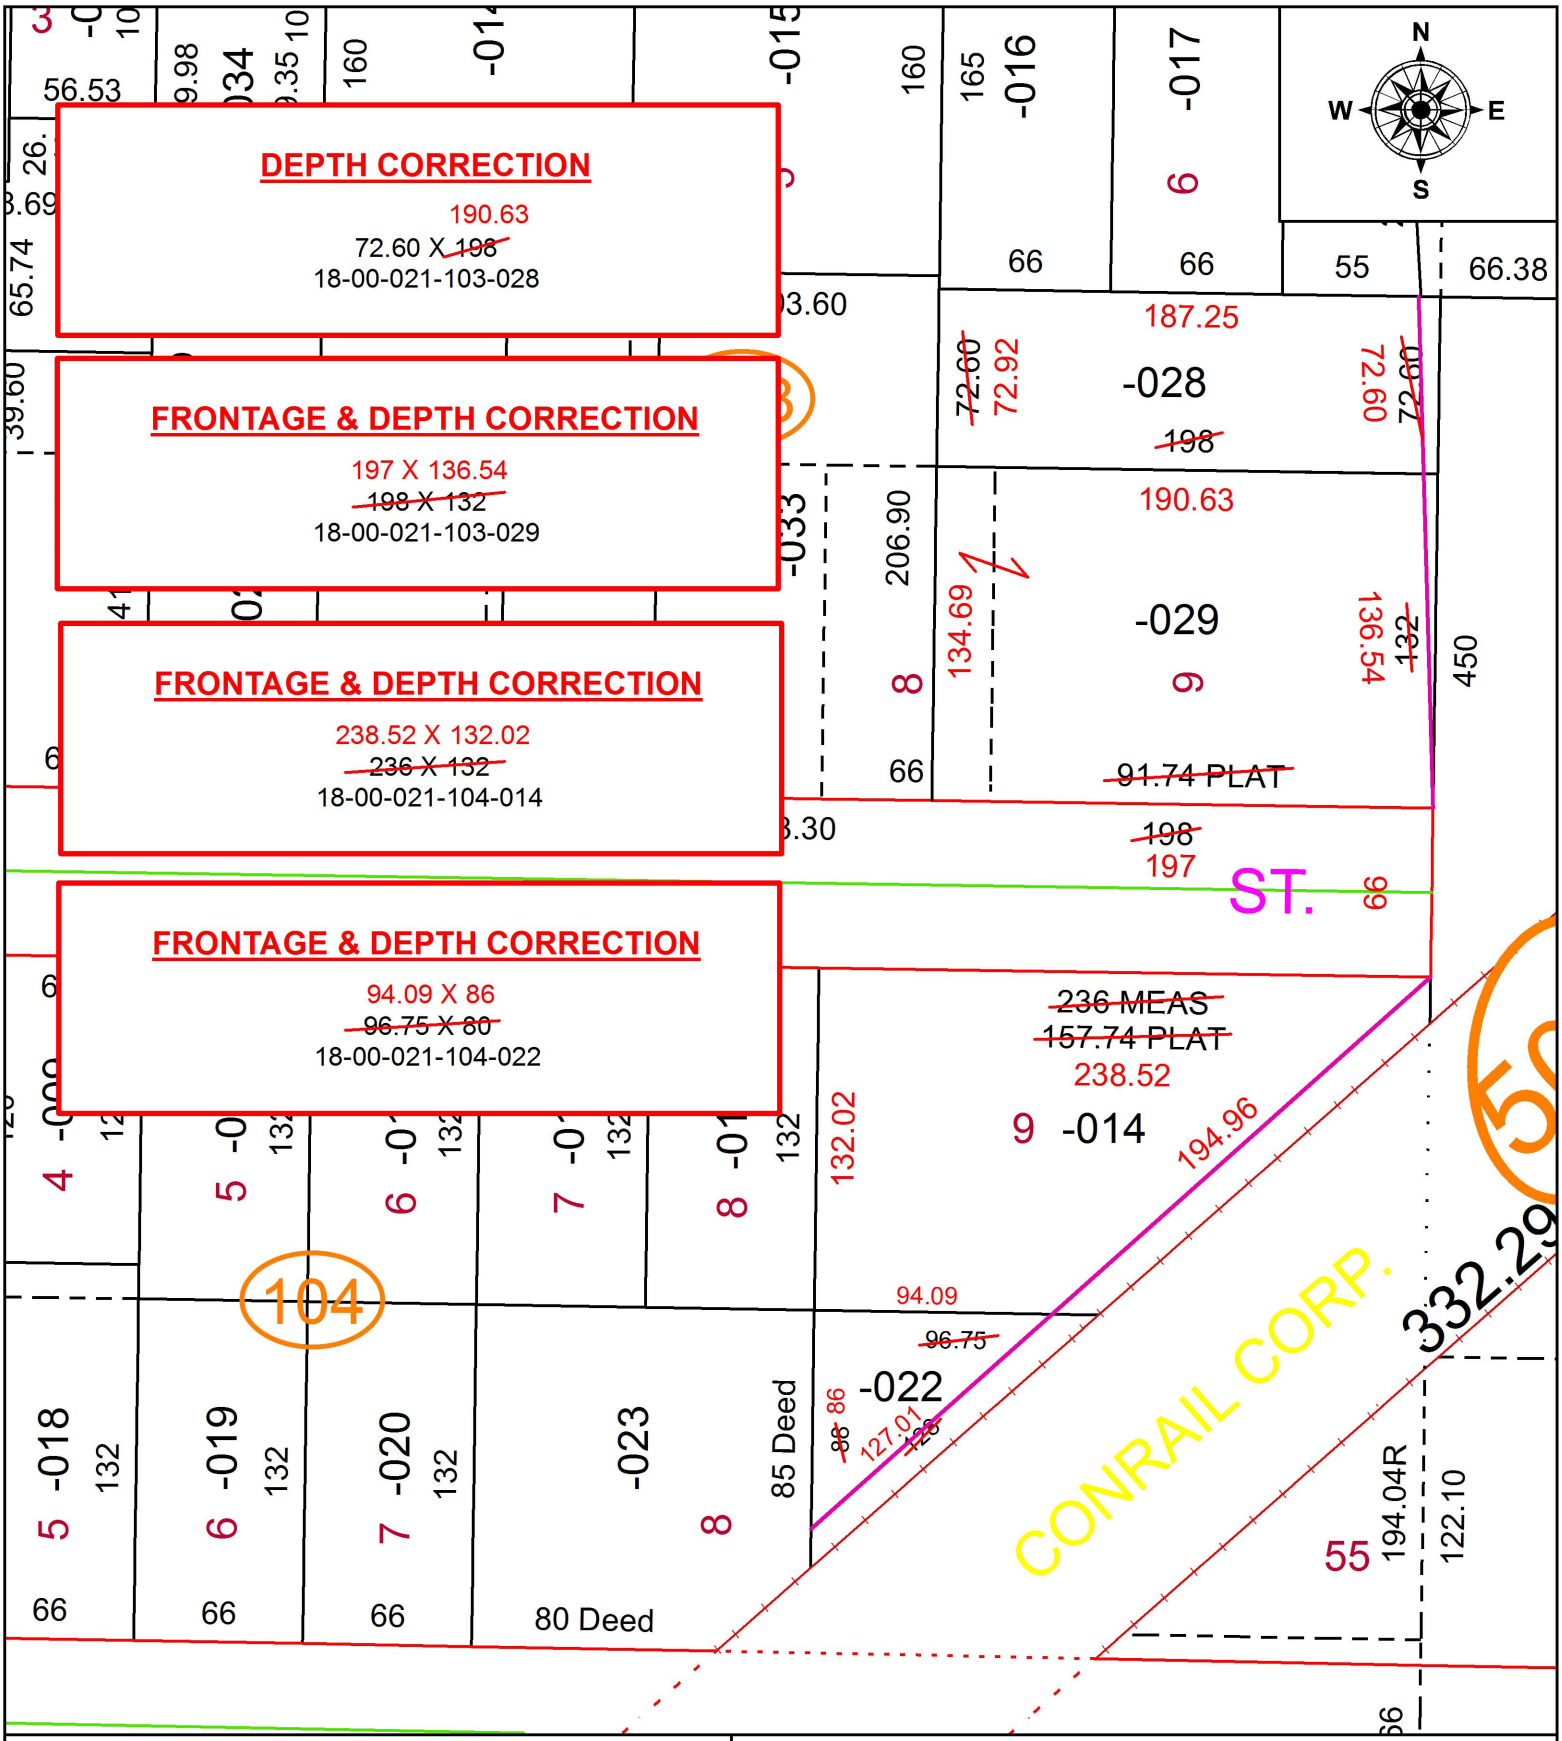

SPLITS/DEEDS PROCESSED

LORAIN COUNTY TAX MAP DEPARTMENT
226 MIDDLE AVE. ELYRIA, OH

SURVEYED BY: THOMAS A. SIMON
CLOSURE: 1: 230,392
MAP PAGE(S): 18-00-021
APPOVED BY: RRM **DATE:** 6-11-19
SCALE: 1" = 75 **PRIOR INSTRUMENT:** 20190708511