PARENT PARCEL: 09-00-004-101-037

CHILD PARCEL:

STARTING POINT: INTERSECTION OF C/L OF ANNIS RD. AND NORTH LINE OF O.L.4

18-03980-C

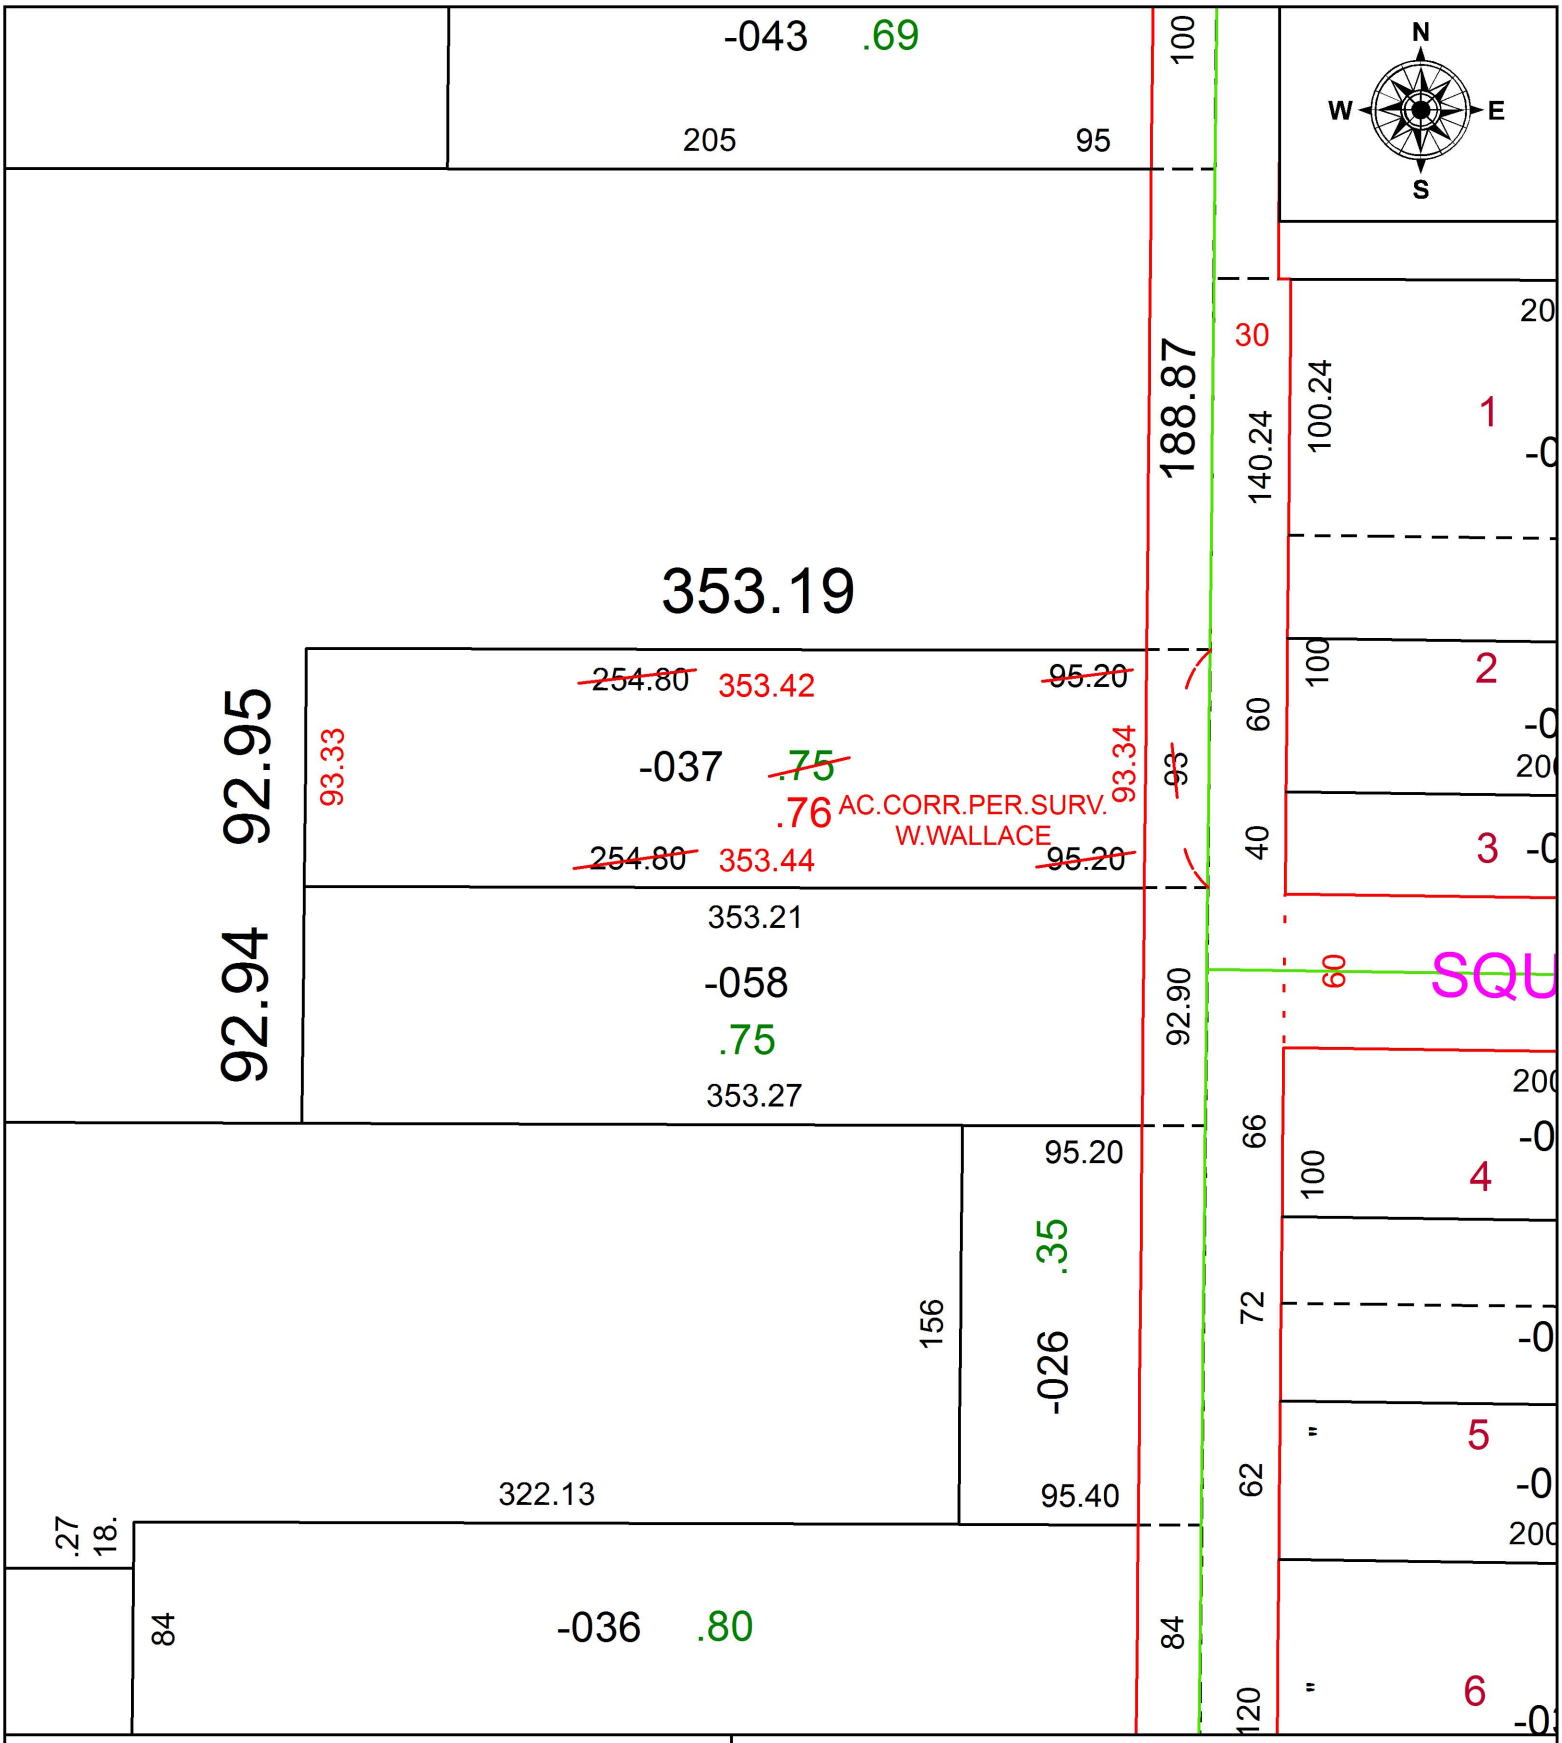

SPLITS/DEEDS PROCESSED

LORAIN COUNTY TAX MAP DEPARTMENT
226 MIDDLE AVE. ELYRIA, OH

SURVEYED BY: WILLIAM R. WALLACE
CLOSURE: 1: 87,109
MAP PAGE(S): 9-00-004
APPOVED BY: RRM **DATE:** 11-13-18
SCALE: 1" = 75 **PRIOR INSTRUMENT:** 20160612994