PARENT PARCEL: 12-00-041-000-007, -008

CHILD PARCEL: 12-00-041-000-046

STARTING POINT: INTERSECTION OF C/L OF FERNWOOD DR. AND C/L OF SPRAGUE RD.

19-03980

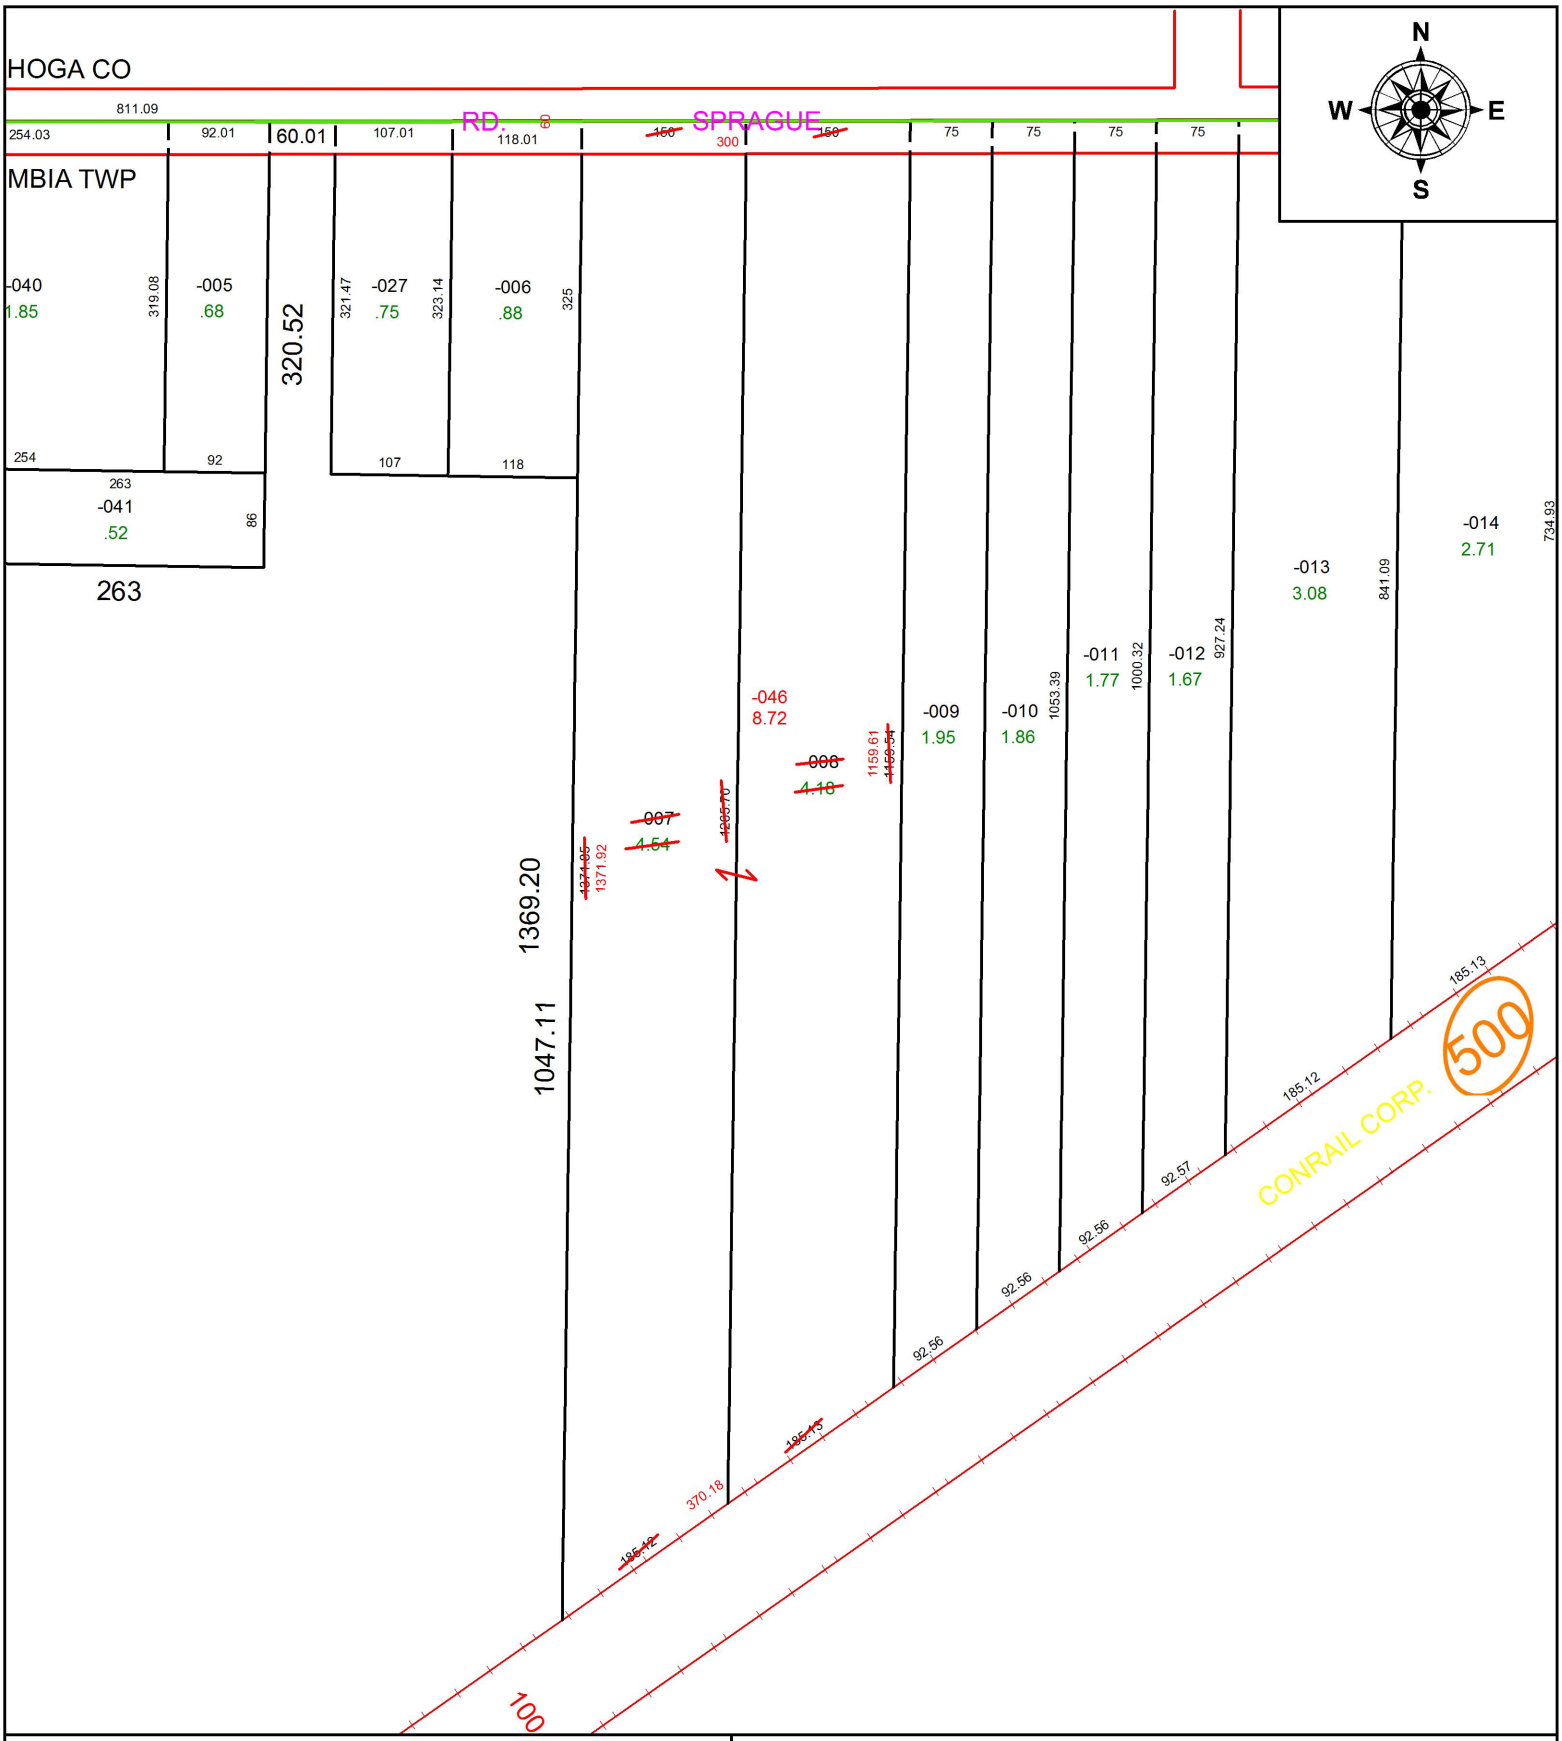

SPLITS/DEEDS PROCESSED

LORAIN COUNTY TAX MAP DEPARTMENT
226 MIDDLE AVE. ELYRIA, OH

SURVEYED BY: JOSHUA S. RIEDY
CLOSURE: 1:1,395,084
MAP PAGE(S): 12-00-041
APPOVED BY: RRM **DATE:** 6-12-19
SCALE: 1" = 175 **PRIOR INSTRUMENT:** 20170647198