PARENT PARCEL: 04-00-004-102-202

CHILD PARCEL:

STARTING POINT: INTERSECTION OF C/L OF CHESTER RD. AND C/L OF MOORE RD.

18-03984-D

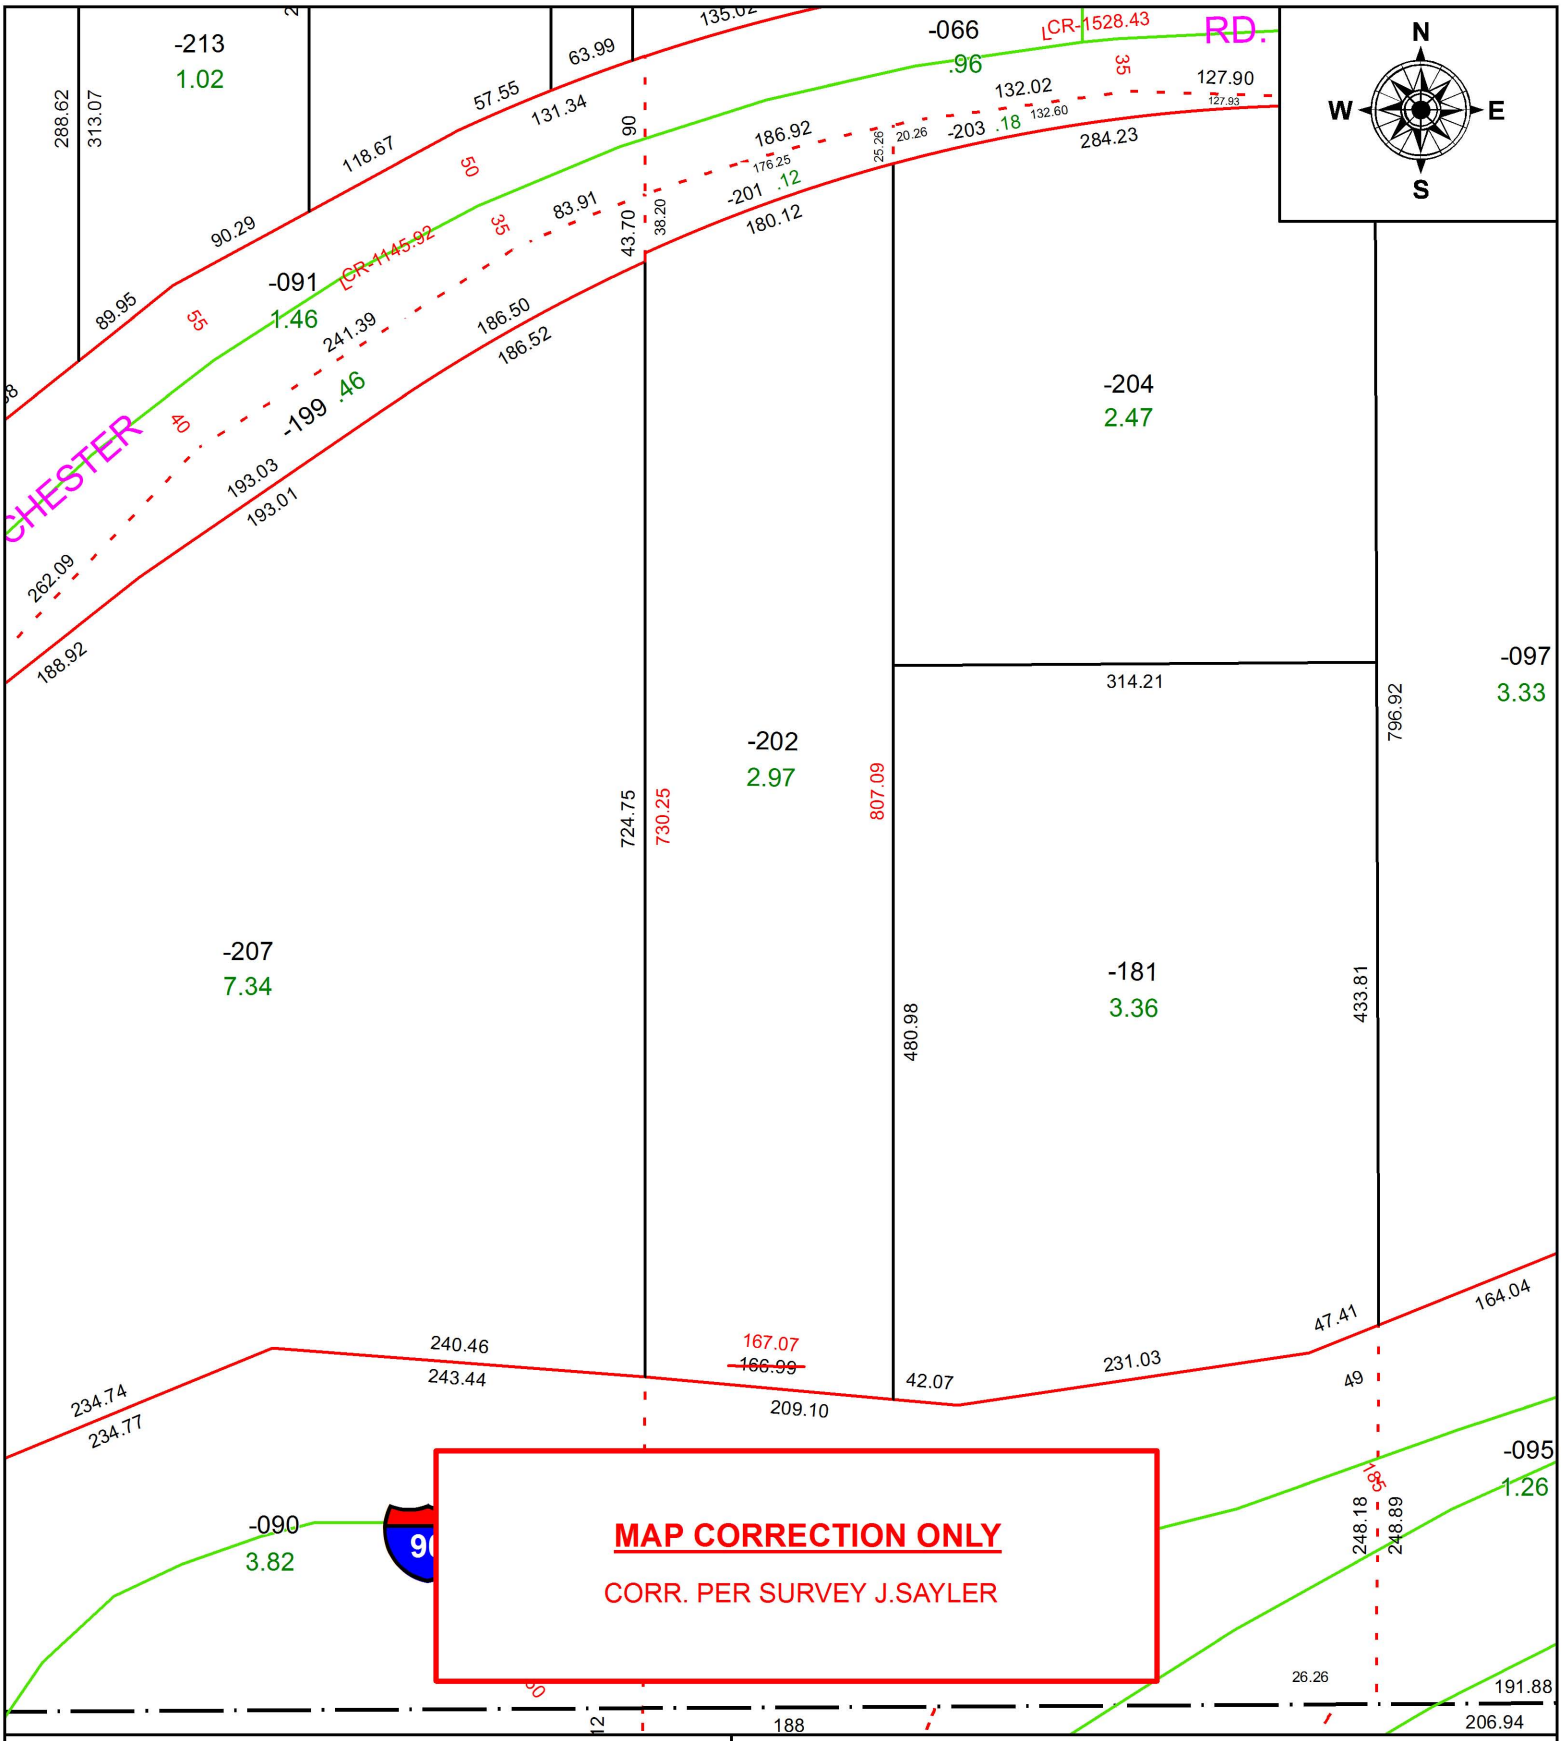

SPLITS/DEEDS PROCESSED

LORAIN COUNTY TAX MAP DEPARTMENT
226 MIDDLE AVE. ELYRIA, OH

SURVEYED BY: JAMES T. SAYLER
CLOSURE: 1: 326,974
MAP PAGE(S): 4-00-004
APPOVED BY: RRM **DATE:** 11-27-18
SCALE: 1" = 125 **PRIOR INSTRUMENT:** 20020857297