**PARENT PARCEL:** 07-00-012-103-007
**CHILD PARCEL:** 07-00-012-103-073, -074
**STARTING POINT:** SOUTHEAST CORNER OF S/L 200 IN FIELDS CORNER SUB. NO.4

# 19-03985

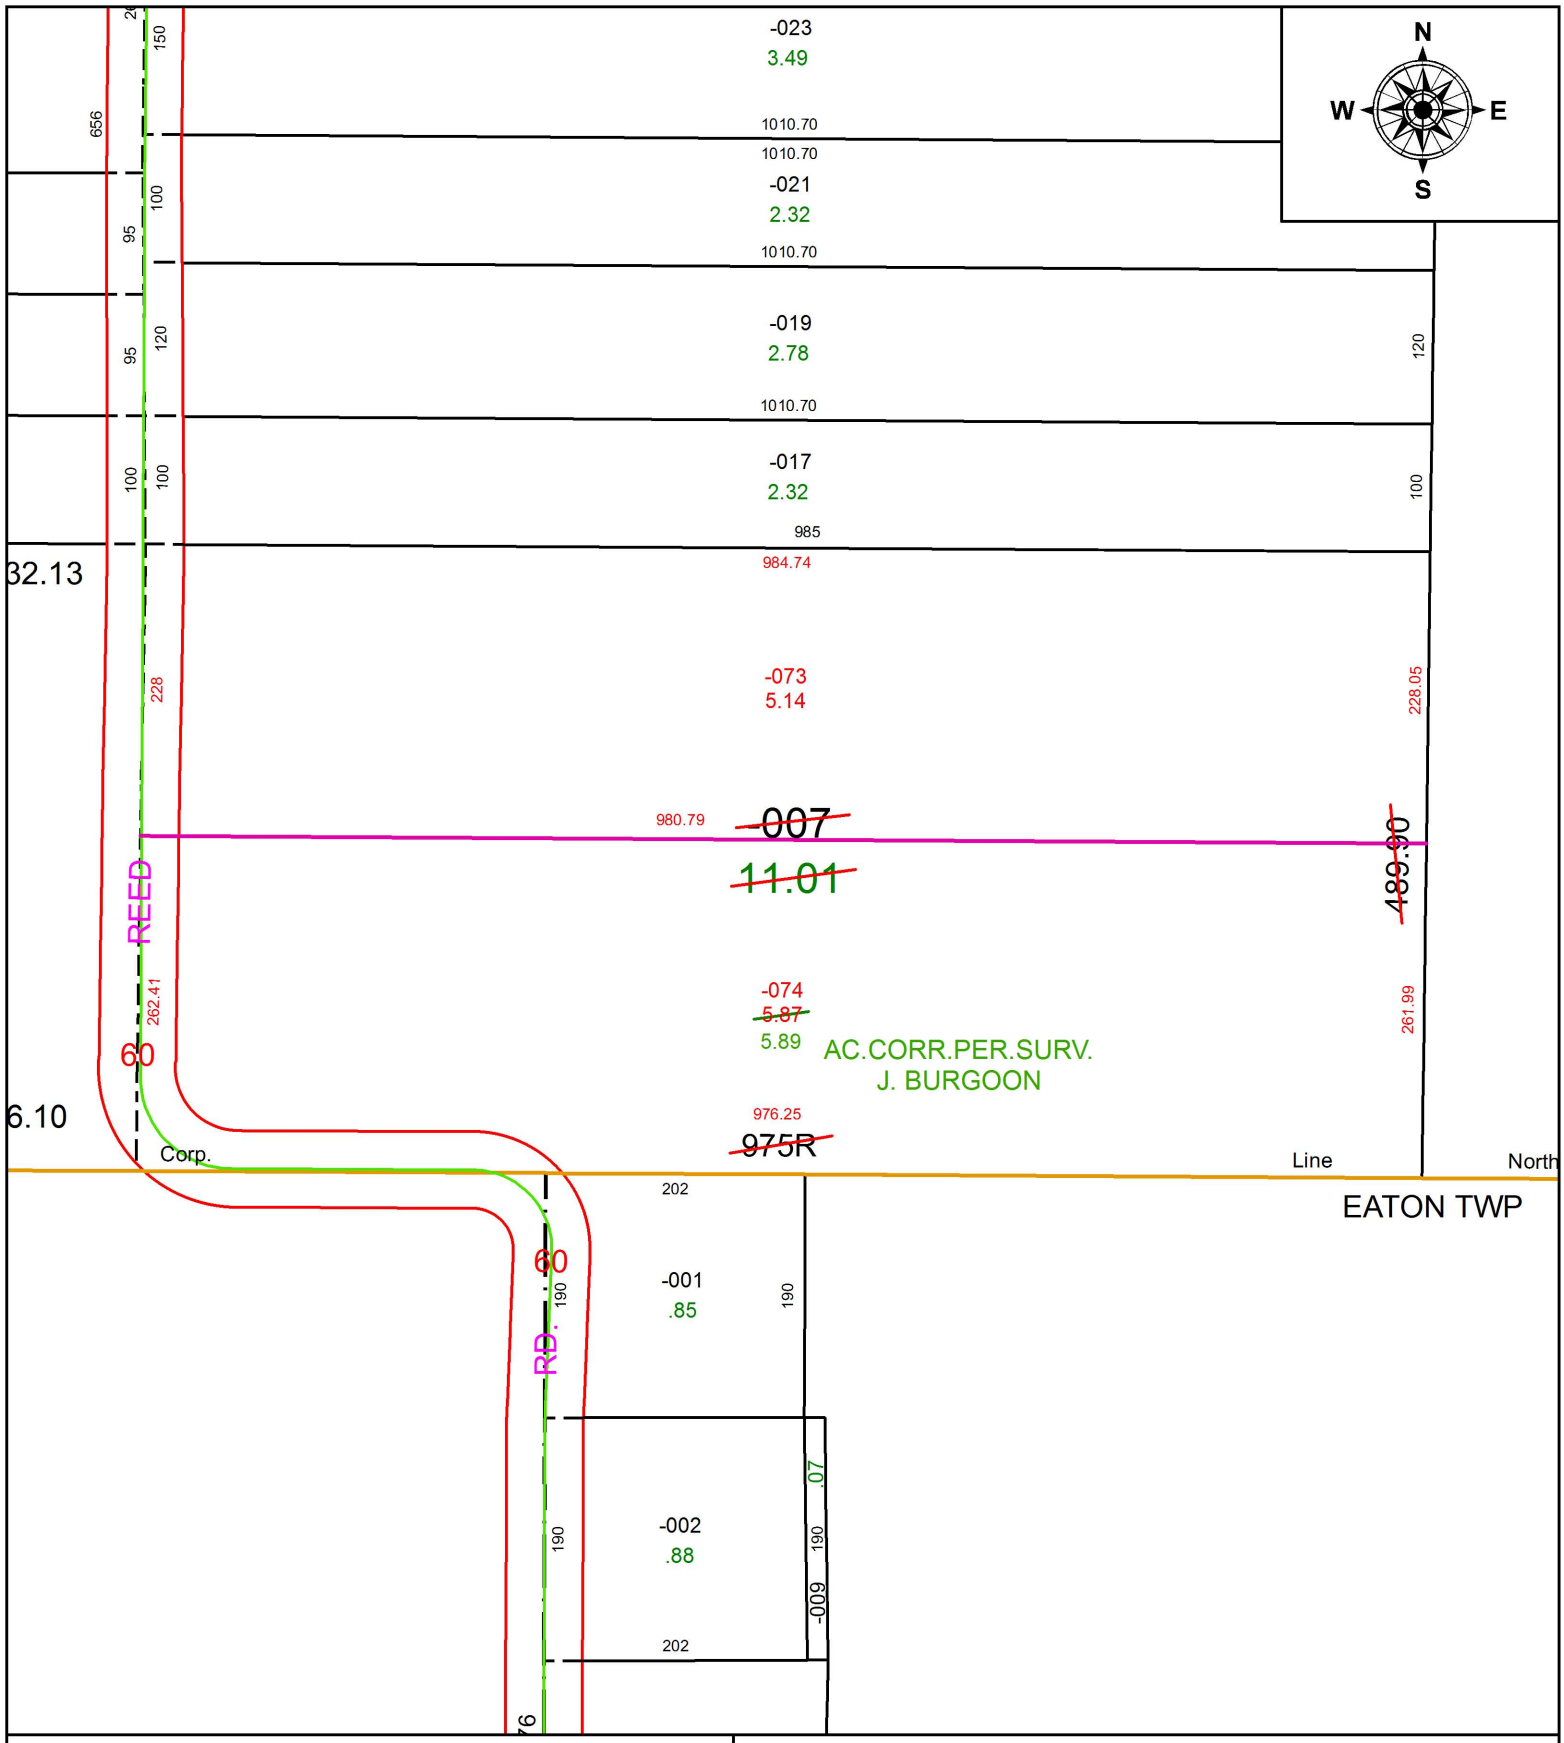


**SPLITS/DEEDS PROCESSED**
LORAIN COUNTY TAX MAP DEPARTMENT
226 MIDDLE AVE. ELYRIA, OH

**SURVEYED BY:** JOSEPH A. BURGOON
**CLOSURE:** 1:400,897
**MAP PAGE(S):** 7-00-012
**APPOVED BY:** RRM **DATE:** 6-26-19
**SCALE:** 1" = 150 **PRIOR INSTRUMENT:** 20190708273