PARENT PARCEL: 10-00-018-101-009

CHILD PARCEL:

STARTING POINT: SOUTHWEST CORNER OF SEC. 18

18-03986-D

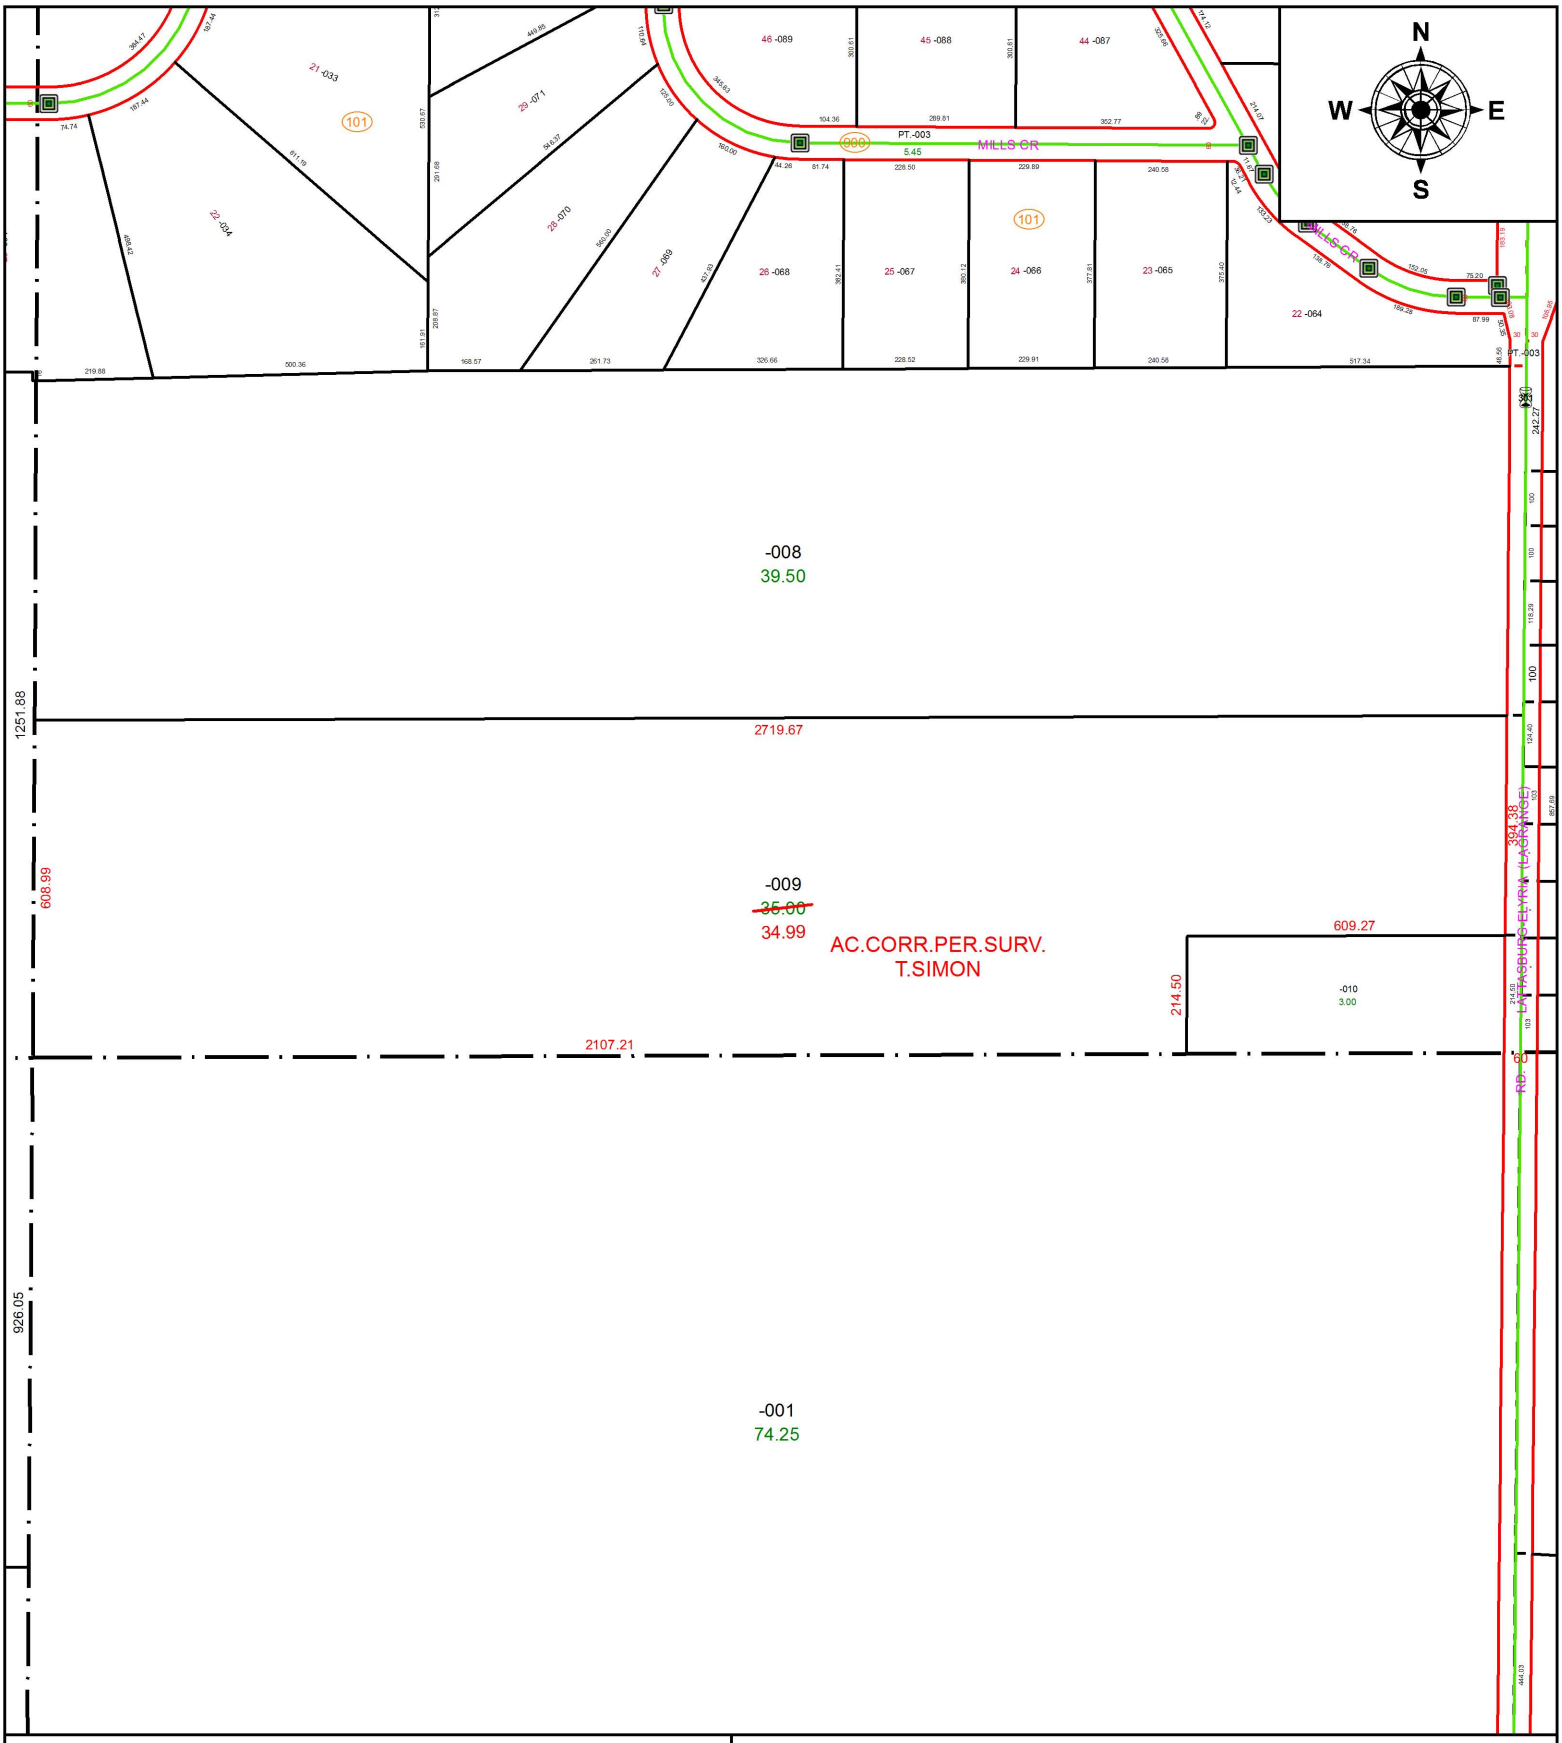

SPLITS/DEEDS PROCESSED

LORAIN COUNTY TAX MAP DEPARTMENT
226 MIDDLE AVE. ELYRIA, OH

SURVEYED BY: THOMAS A. SIMON
CLOSURE: 1: 755,676
MAP PAGE(S): 10-00-018
APPOVED BY: RRM **DATE:** 12-3-18
SCALE: 1" = 350 **PRIOR INSTRUMENT:** 20160571788