PARENT PARCEL: 06-24-028-101-005, -006, -007
CHILD PARCEL: 06-24-028-101-010
STARTING POINT: INTERSECTION OF NORTH LINE OF BELL AVE. AND WEST LINE OF KEYS DR.

19-03986

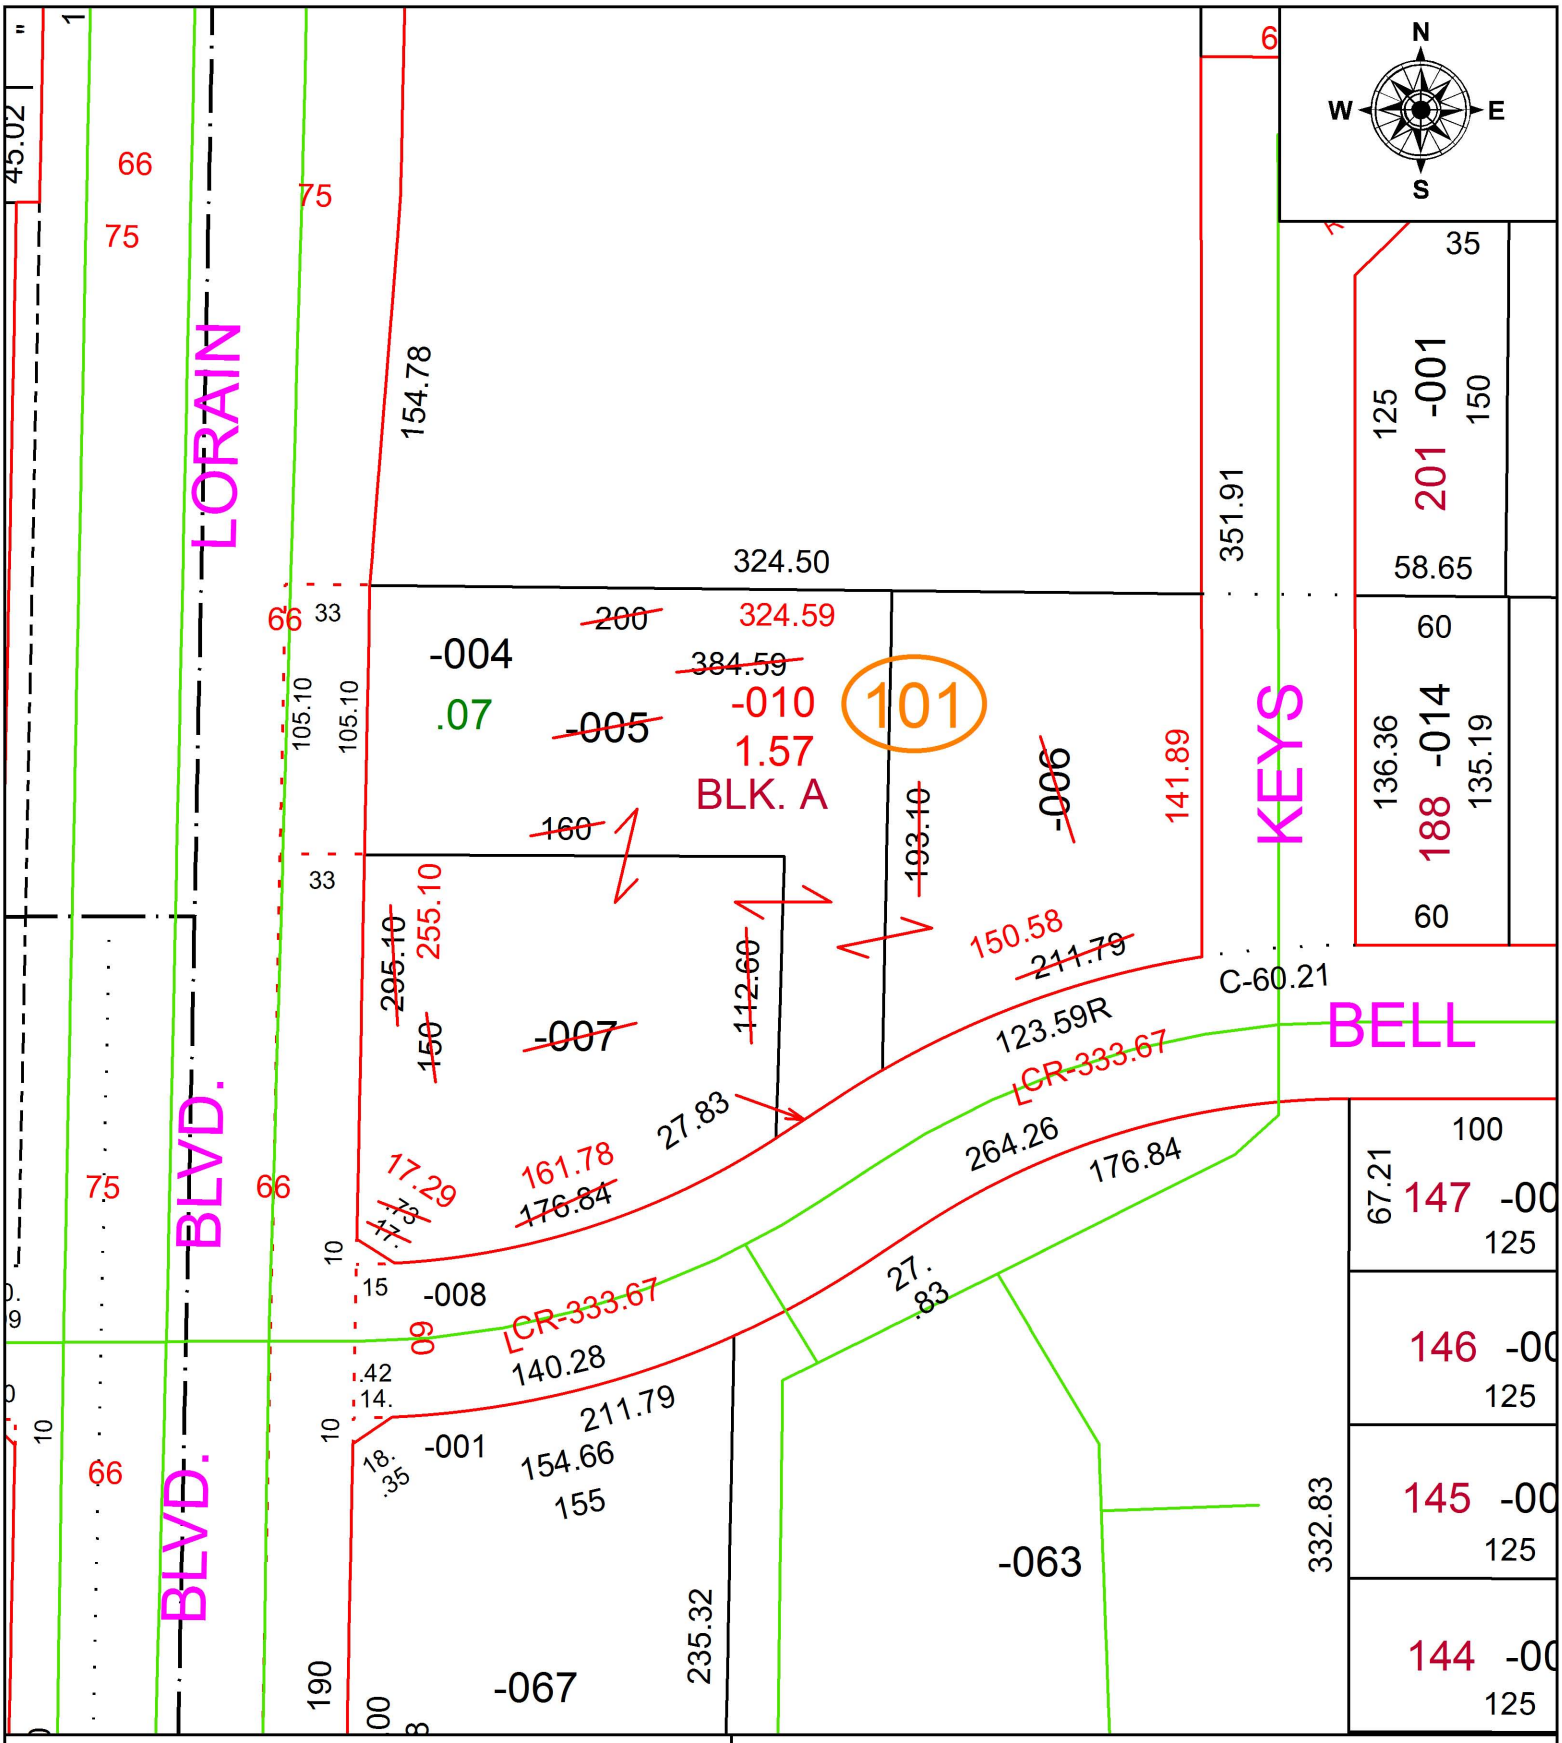

SPLITS/DEEDS PROCESSED
LORAIN COUNTY TAX MAP DEPARTMENT
226 MIDDLE AVE. ELYRIA, OH

SURVEYED BY: STEVEN J. METCALF
CLOSURE: 1:241,410
MAP PAGE(S): 6-24-028
APPOVED BY: RRM **DATE:** 6-26-19
SCALE: 1" = 75 **PRIOR INSTRUMENT:** 20070230310