PARENT PARCEL: 14-00-001-000-005

CHILD PARCEL: 14-00-001-000-006, -007

STARTING POINT: SOUTHWEST CORNER OF O.L.1

19-03987

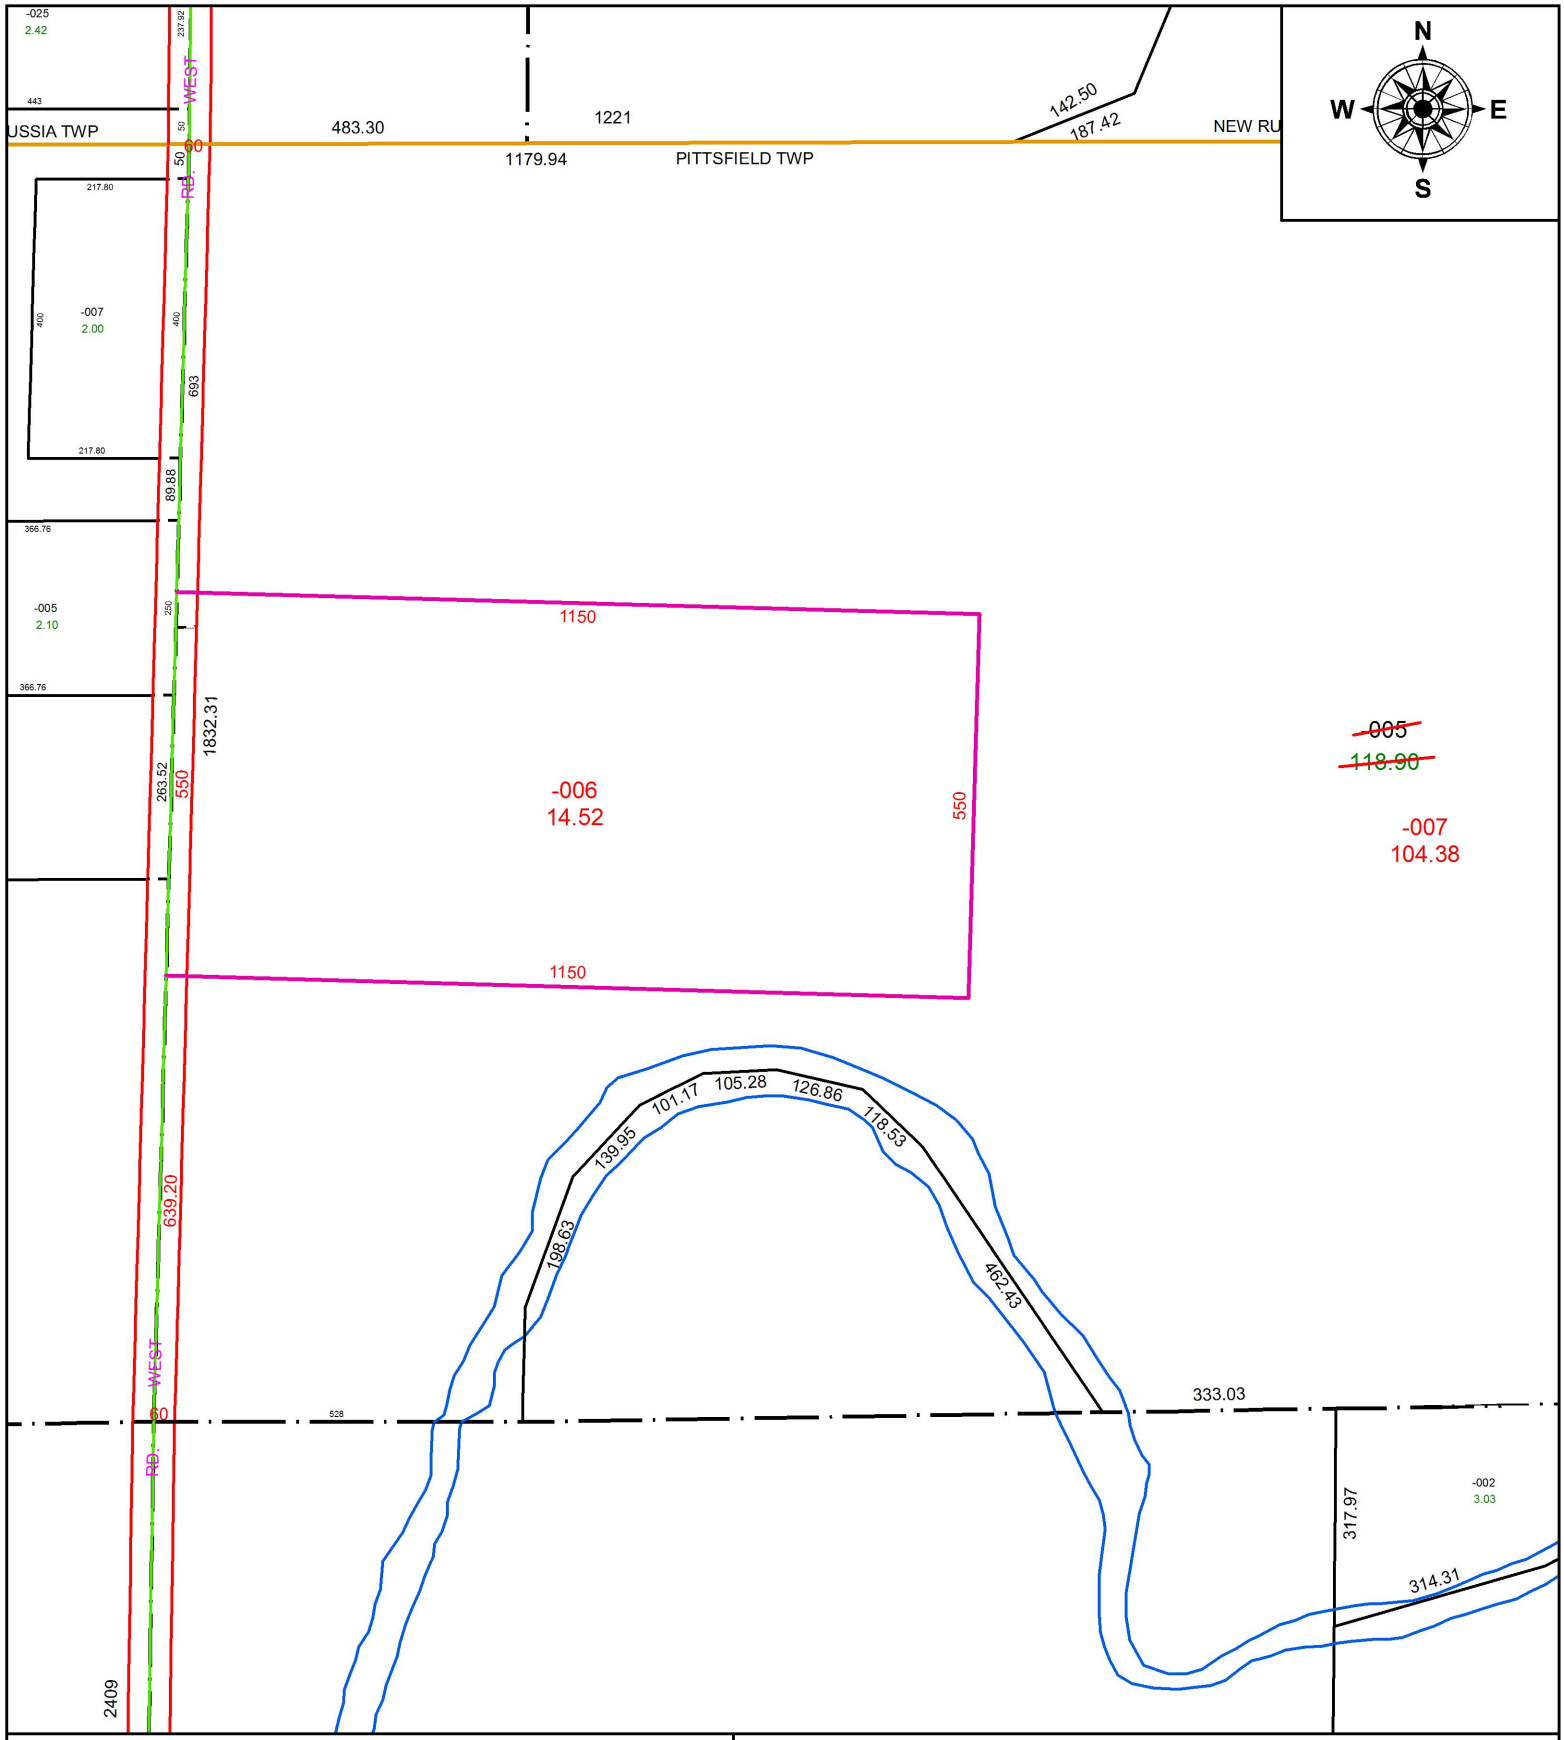

SPLITS/DEEDS PROCESSED

LORAIN COUNTY TAX MAP DEPARTMENT
226 MIDDLE AVE. ELYRIA, OH

SURVEYED BY: NATHANIEL B. RAMSEY
CLOSURE: 1: 2147483648
MAP PAGE(S): 14-00-001
APPOVED BY: RRM **DATE:** 7-5-19
SCALE: 1" = 275 **PRIOR INSTRUMENT:** 20170641760