PARENT PARCEL: 17-07-002-000-034
CHILD PARCEL: 17-07-002-000-037, -038
STARTING POINT: INTERSECTION OF C/L OF PECK WADSWORTH RD. AND C/L OF MOSHER RD.

19-03993

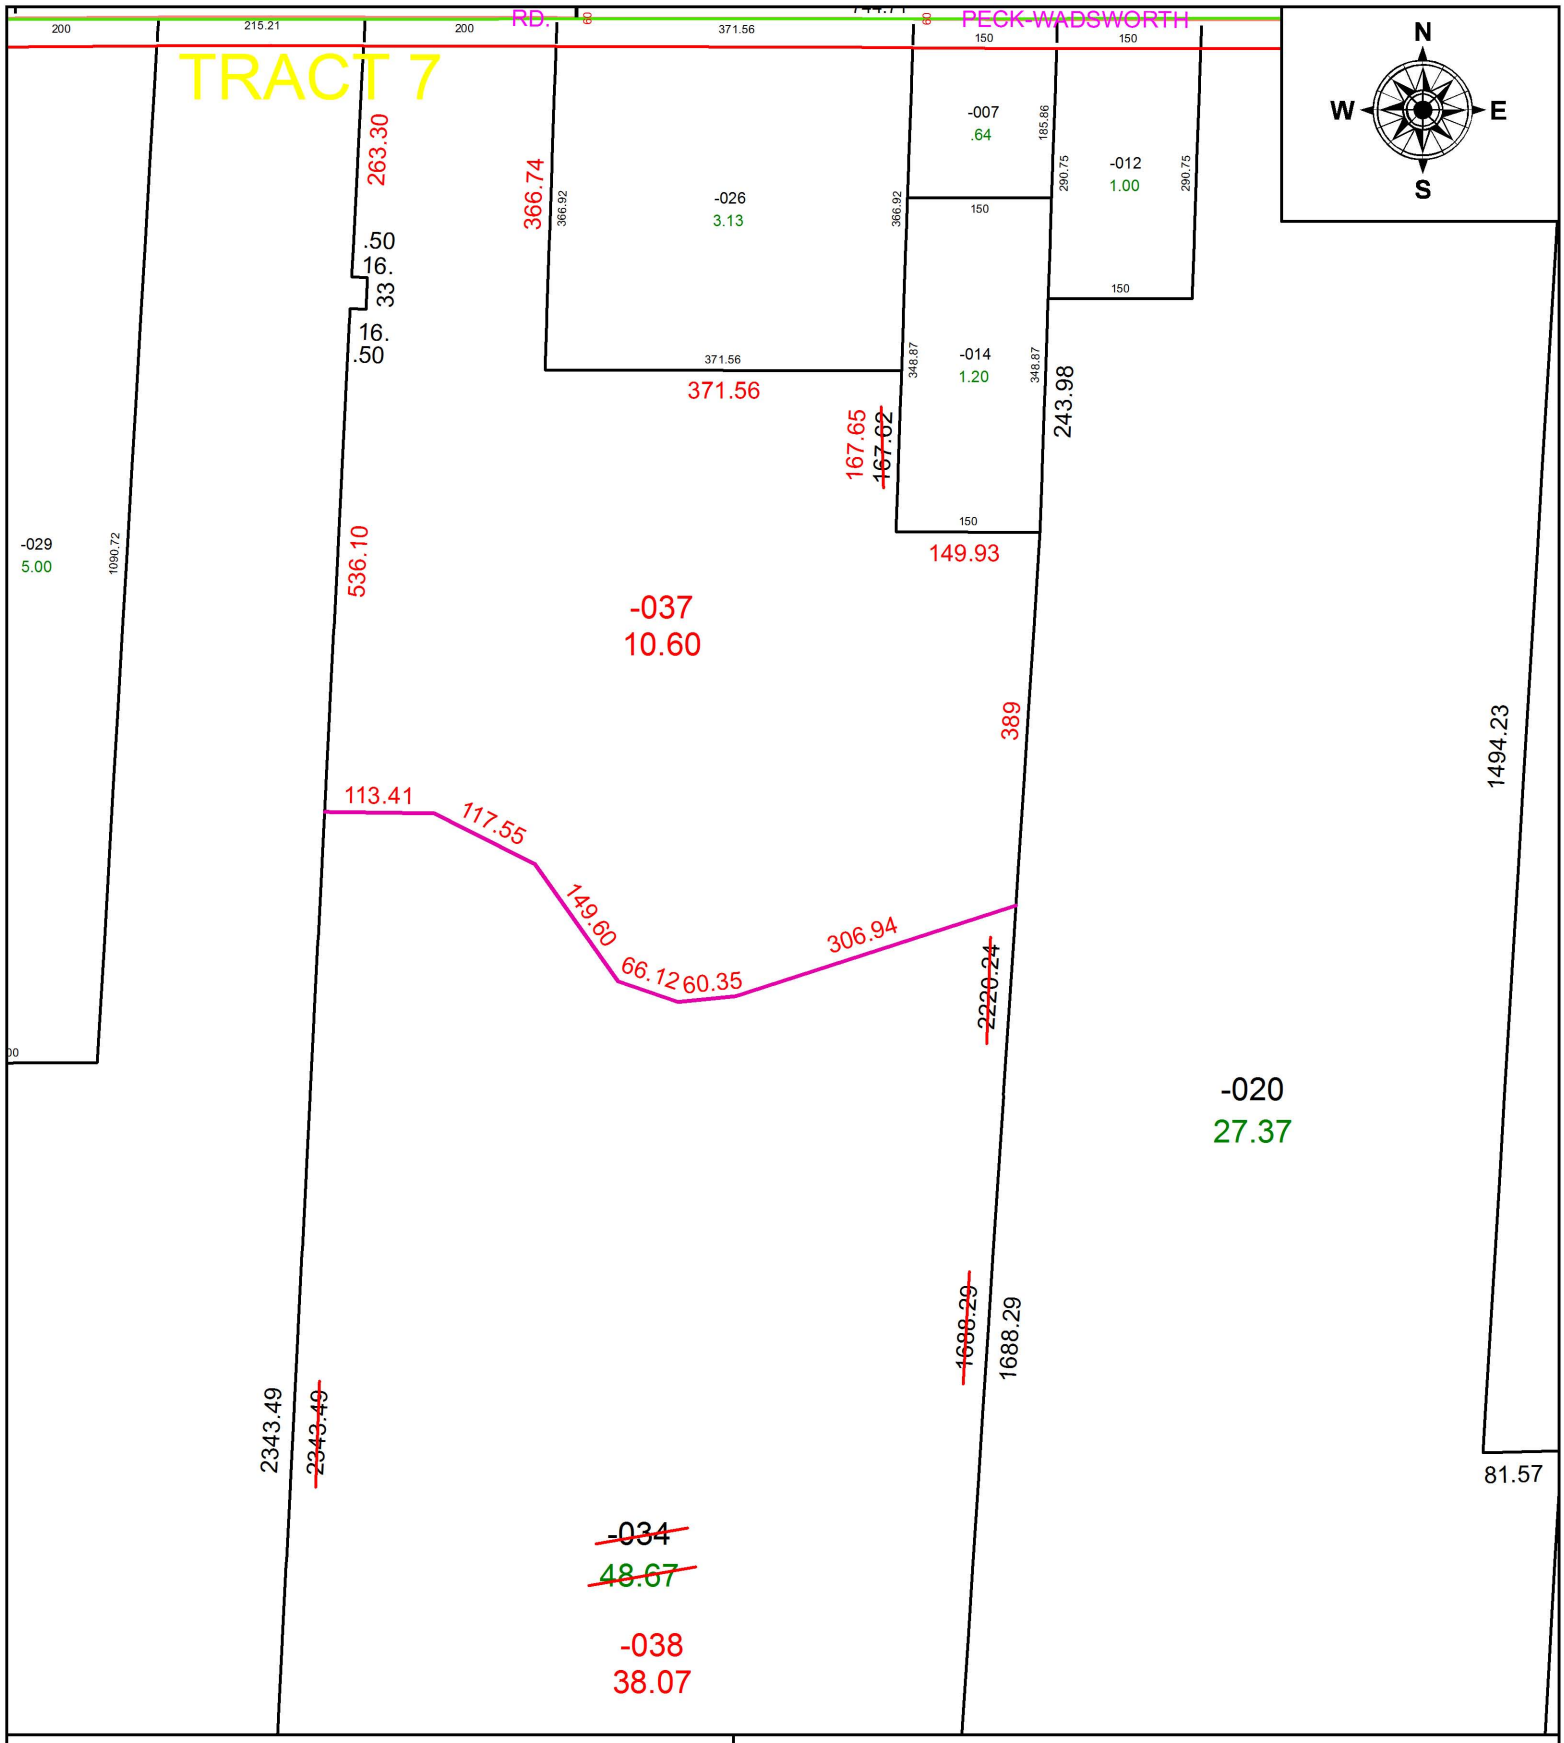

SPLITS/DEEDS PROCESSED
LORAIN COUNTY TAX MAP DEPARTMENT
226 MIDDLE AVE. ELYRIA, OH

SURVEYED BY: TIMOTHY D. HOZALSKI
CLOSURE: 1: 614,254
MAP PAGE(S): 17-07-002
APPOVED BY: RRM **DATE:** 7-15-19
SCALE: 1" = 200 **PRIOR INSTRUMENT:** 20050083253