PARENT PARCEL: 04-00-013-000-524
CHILD PARCEL: 04-00-013-000-614, -615
STARTING POINT: INTERSECTION OF C/L OF S.R. 83 AND C/L OF SOUTH PARK DR.

19-03995

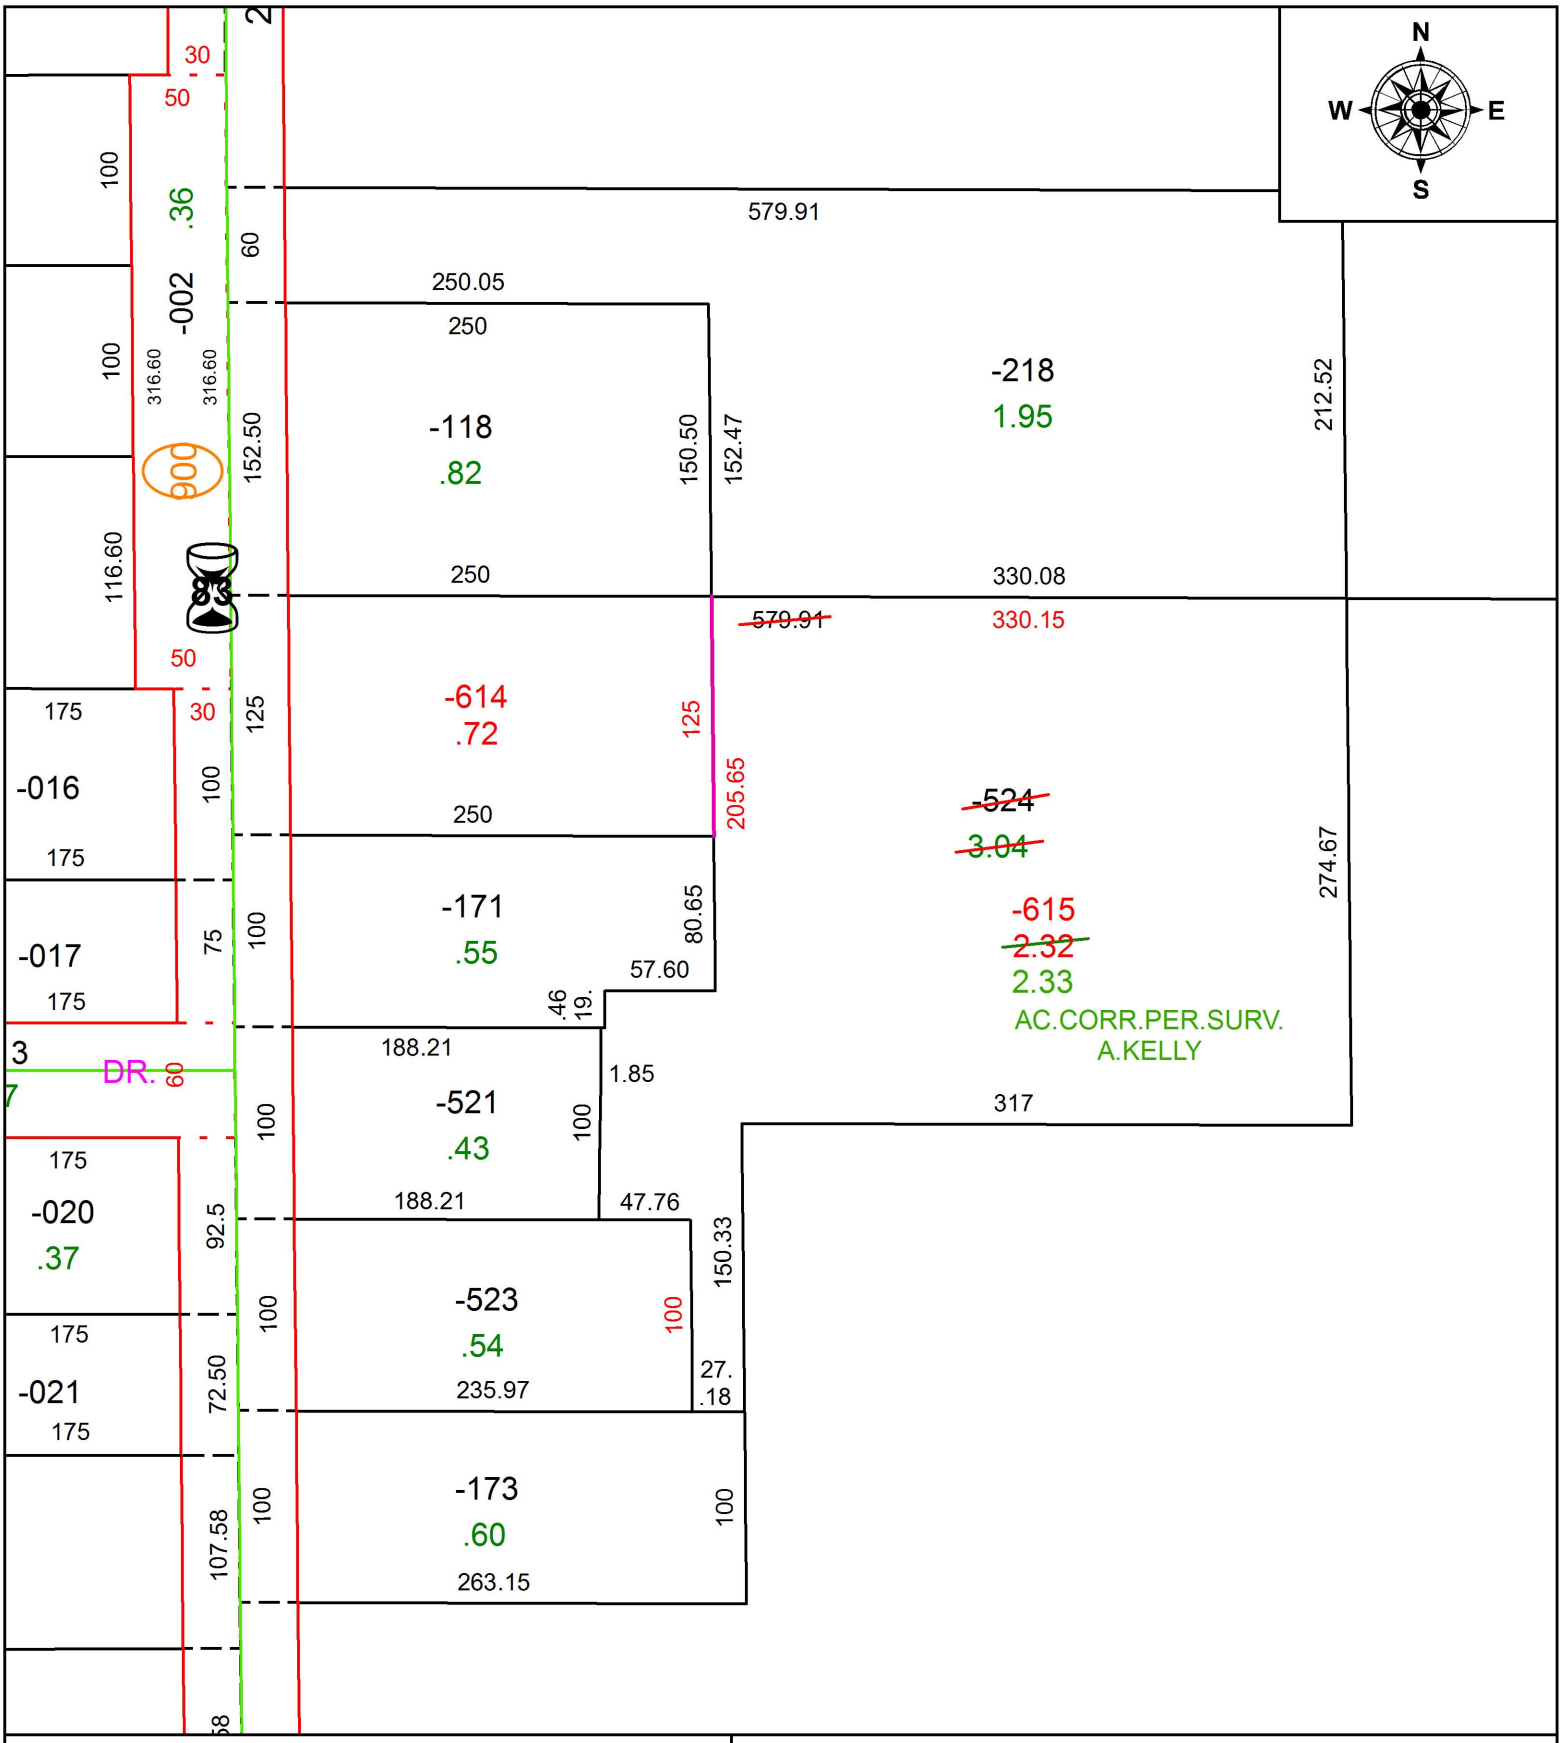

SPLITS/DEEDS PROCESSED
LORAIN COUNTY TAX MAP DEPARTMENT
226 MIDDLE AVE. ELYRIA, OH

SURVEYED BY: AMY M. KELLY
CLOSURE: 1:343,319
MAP PAGE(S): 4-00-013
APPOVED BY: RRM **DATE:** 7-19-19
SCALE: 1" = 100 **PRIOR INSTRUMENT:** 20050052920