PARENT PARCEL: 11-00-089-000-081

CHILD PARCEL:

STARTING POINT: INTERSECTION OF C/L OF DURKEE RD. AND C/L OF BUTTERNUT RIDGE RD.

18-03996-A

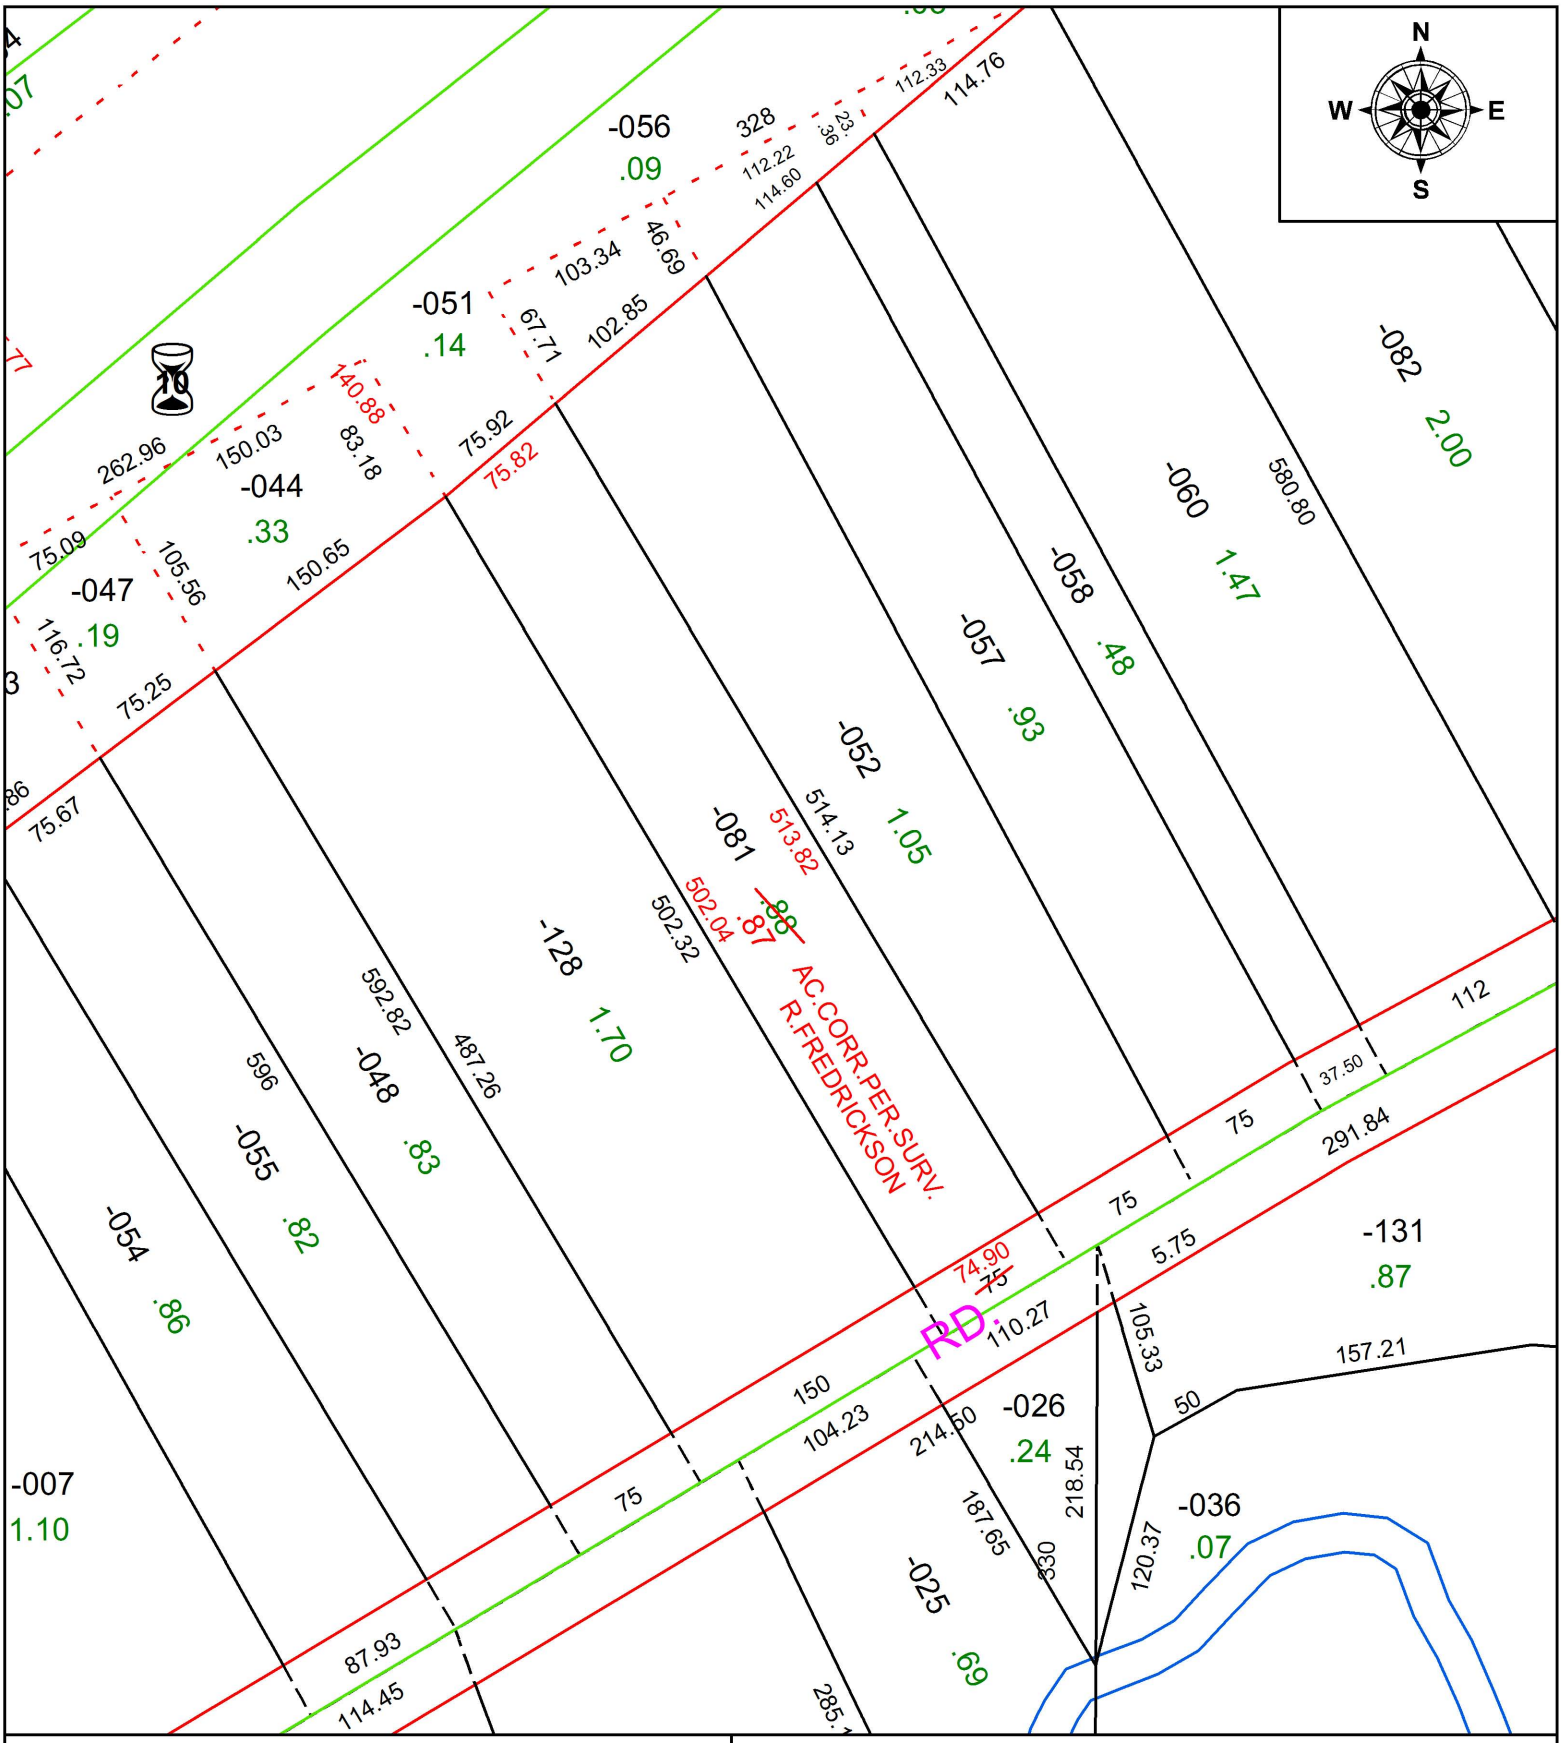

SPLITS/DEEDS PROCESSED

LORAIN COUNTY TAX MAP DEPARTMENT
226 MIDDLE AVE. ELYRIA, OH

SURVEYED BY: RICHARD A. FREDRICKSON
CLOSURE: 1: 1,150,307
MAP PAGE(S): 11-00-089
APPOVED BY: RRM **DATE:** 12-12-18
SCALE: 1" =100 **PRIOR INSTRUMENT:** 20180686768