PARENT PARCEL: 10-00-023-102-027

CHILD PARCEL:

STARTING POINT: INTERSECTION OF C/L OF BANKS RD. AND C/L OF S.R. 301

18-03999-D

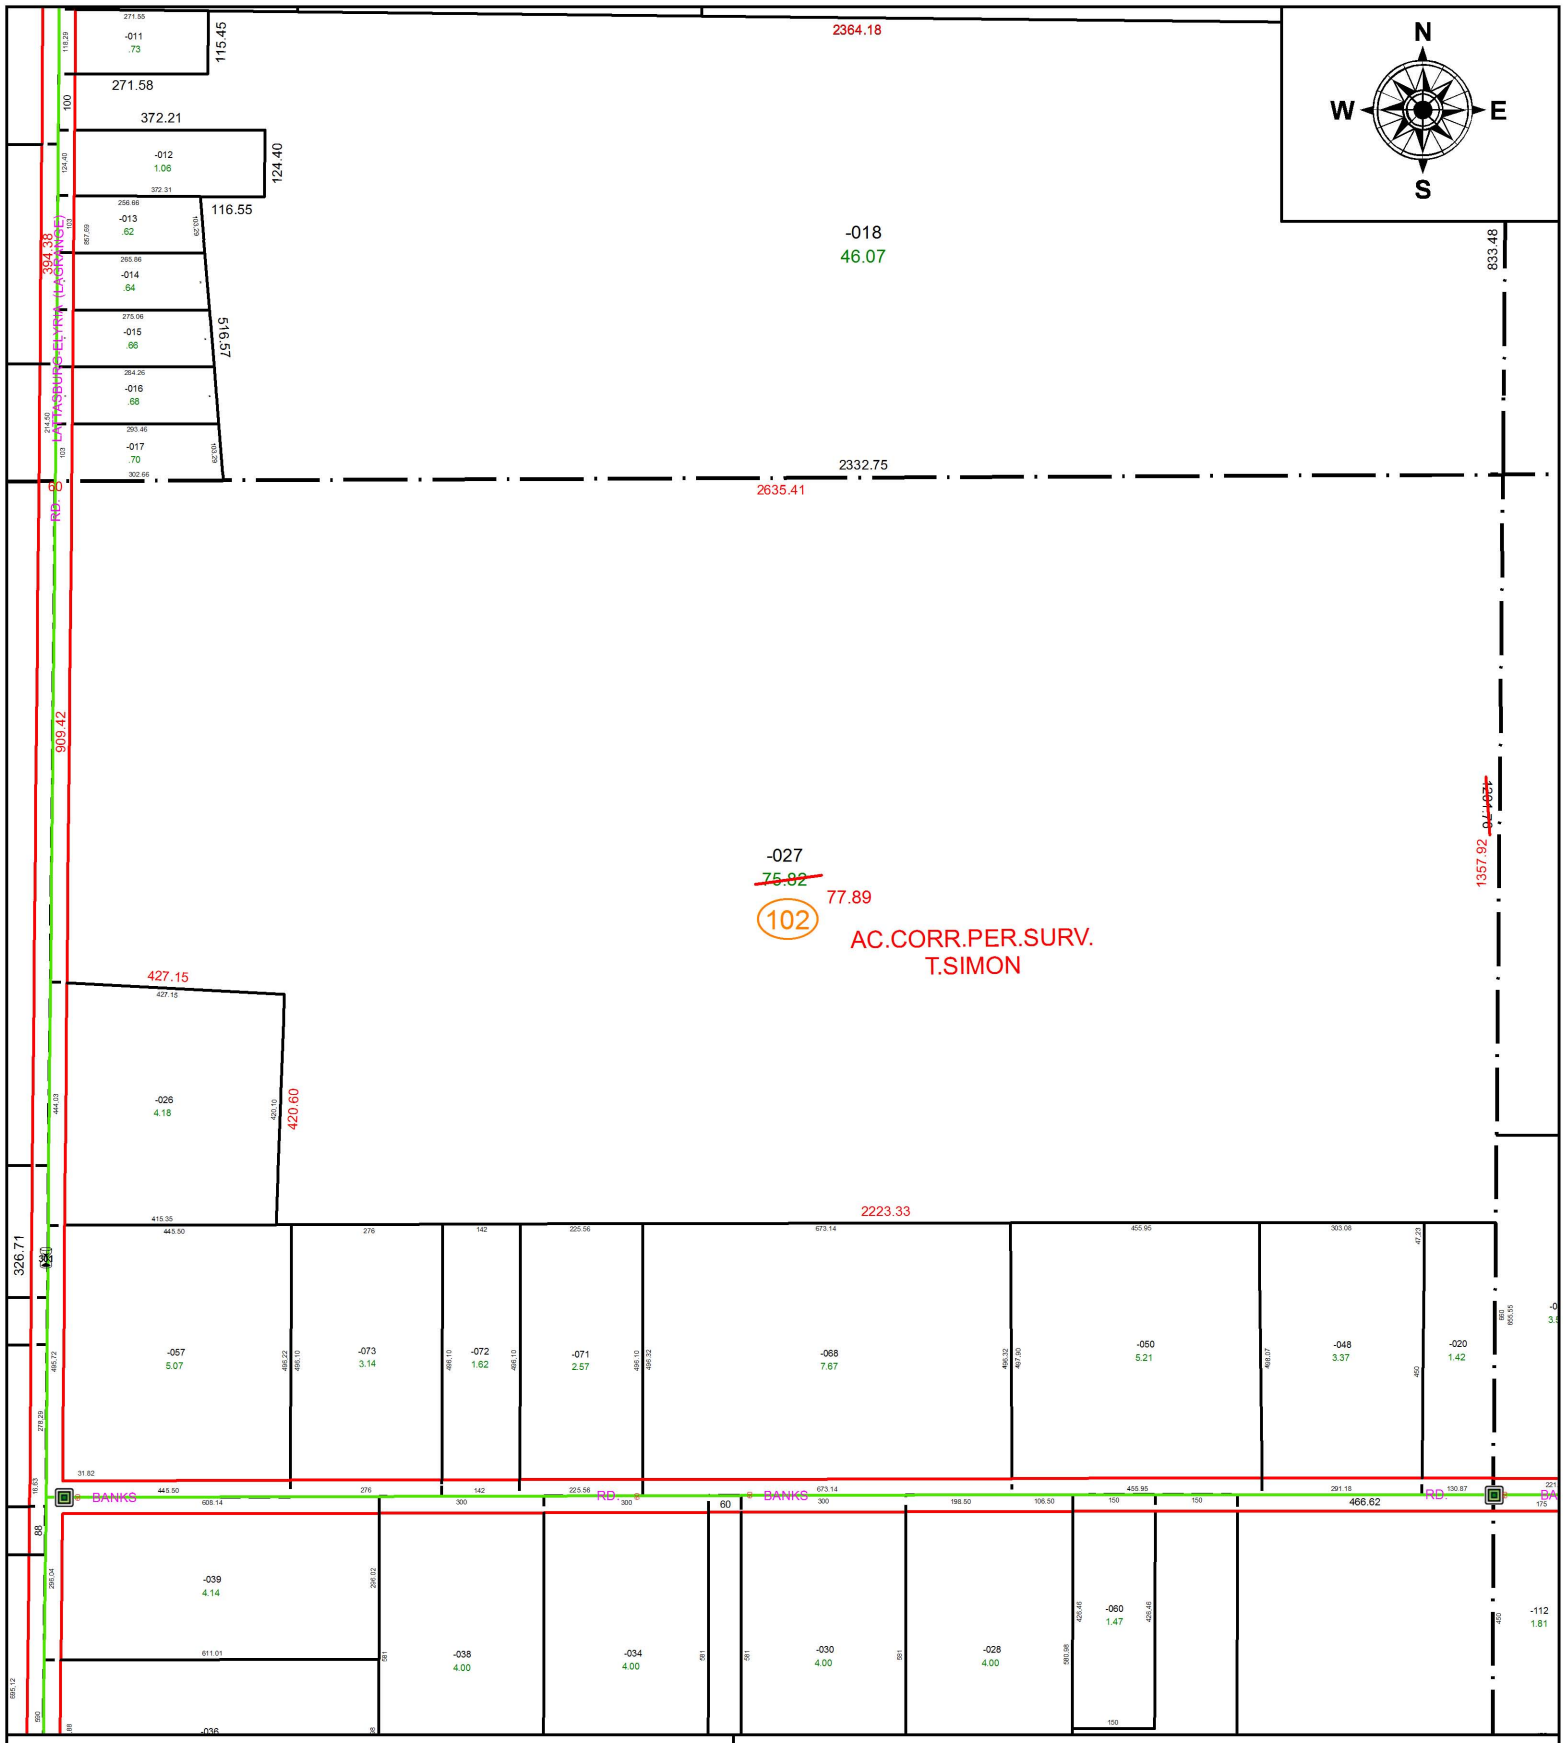

SPLITS/DEEDS PROCESSED

LORAIN COUNTY TAX MAP DEPARTMENT
226 MIDDLE AVE. ELYRIA, OH

SURVEYED BY: THOMAS A. SIMON
CLOSURE: 1: 2,002,375
MAP PAGE(S): 10-00-023
APPOVED BY: RRM **DATE:** 12-13-18
SCALE: 1" =350 **PRIOR INSTRUMENT:** N/A