RASTER

PARENT PARCEL: 12-00-025-000-045, 12-00-036-000-020, -022

CHILD PARCEL: 12-00-025-000-063, 064 12-00-036-000-041, -042

STARTING POINT: INT S LINE OF O.L. 36 AND CL S.R.82

NO. 00968-D

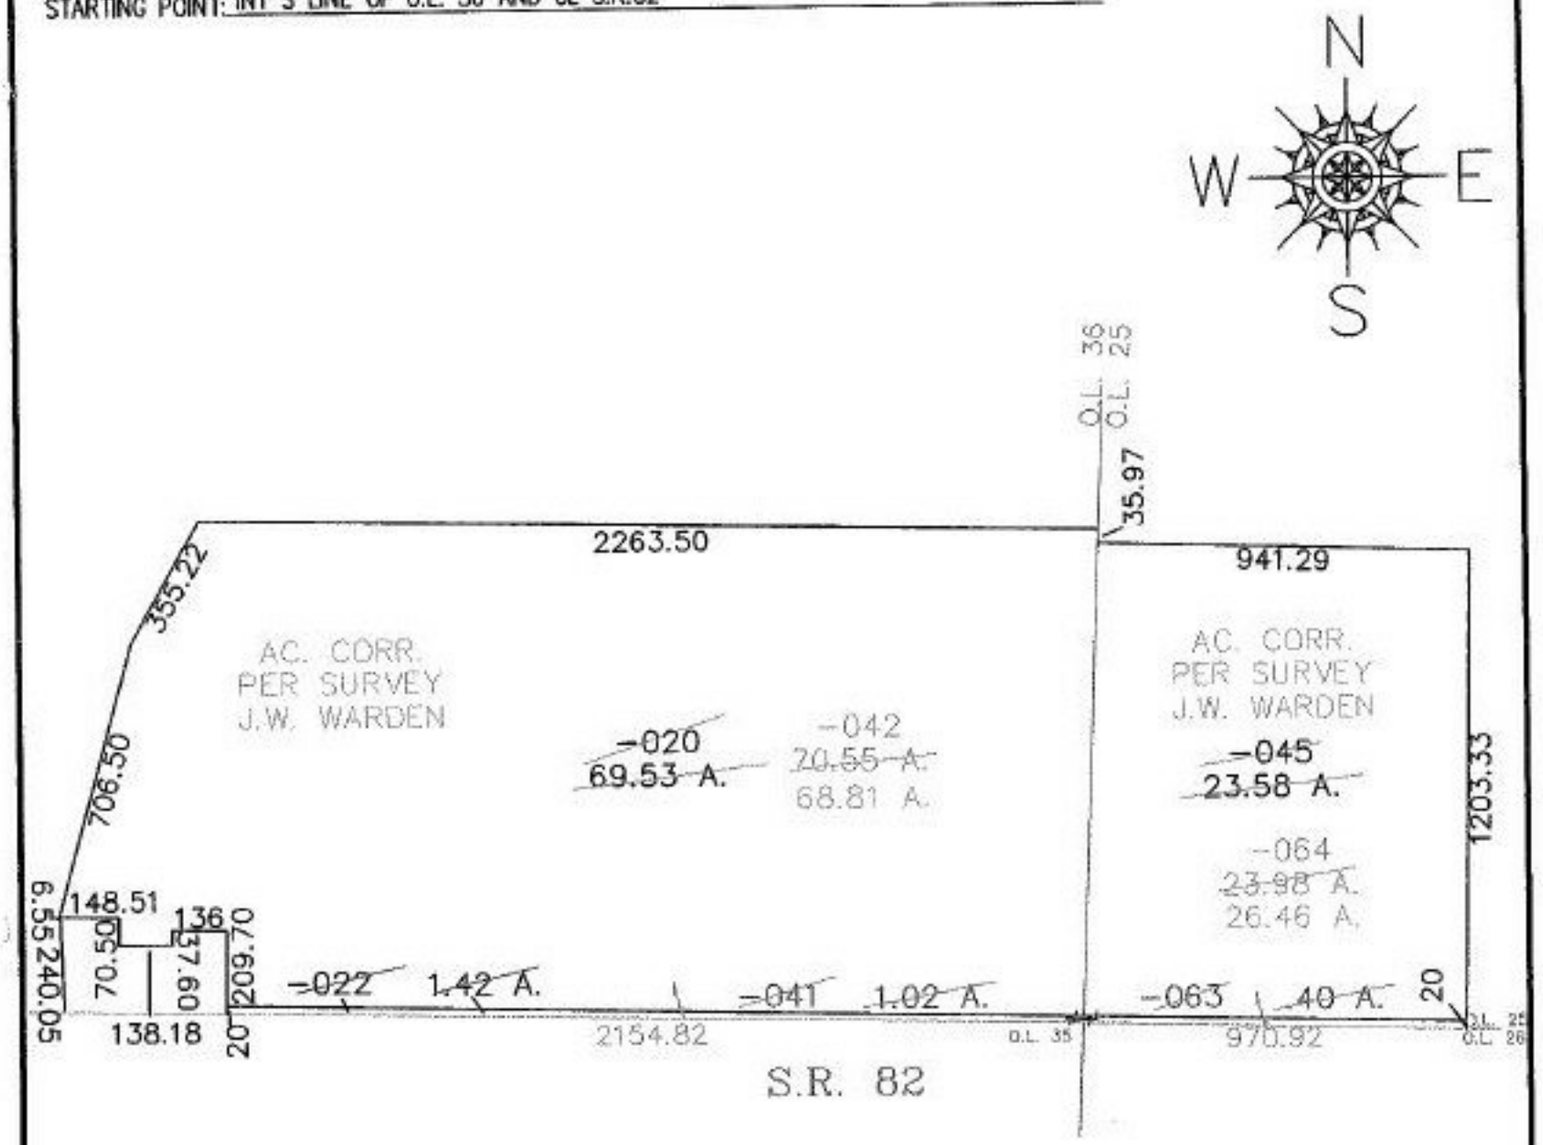


SPLITS/DEEDS PROCESSED

LORAIN COUNTY TAX MAP DEPARTMENT
226 MIDDLE AVE. ELYRIA, OHIO

SURVEYED BY: J.W. WARDEN

CLOSURE: 1:10,000

MAP PAGE(S): 12-00-025-A

APPROVED BY: DRH DATE: 2/6/2004

SCALE: 1" = 500 PRIOR INSTRUMENT: DV 1247/505