


PARENT PARCEL: 03-00-084-000-019

CHILD PARCEL: 03-00-084-000-020, -021

STARTING POINT: CENTERLINE OF GROVE AVE. & EAST 28TH ST.

NO. 01598

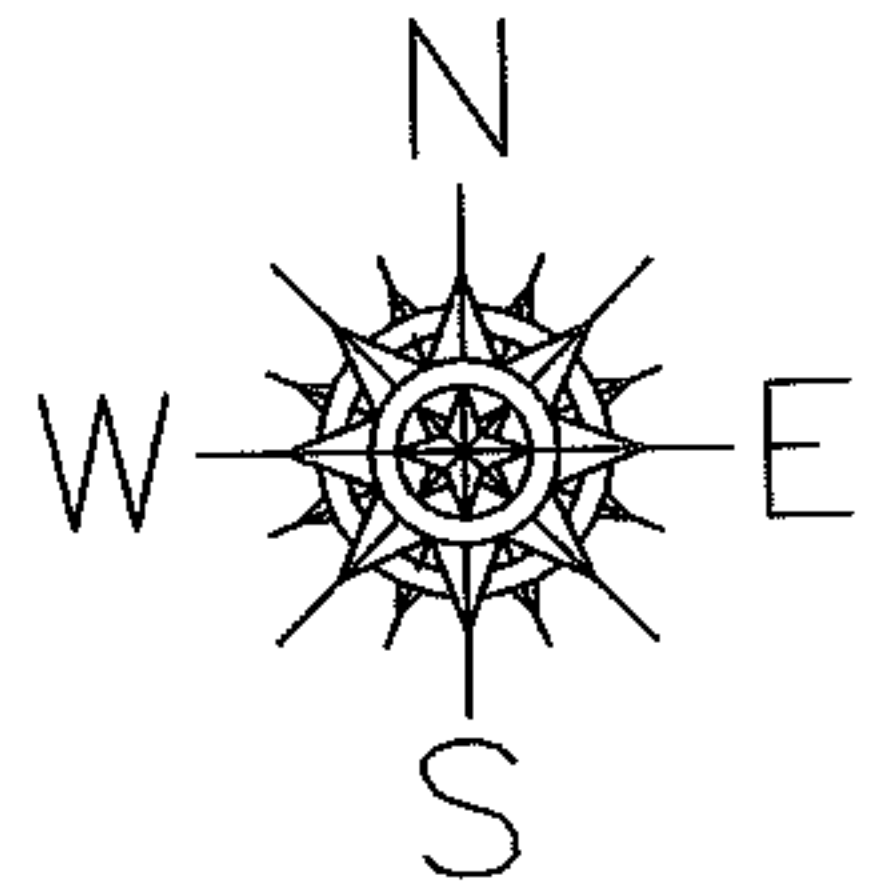

03-00-088-101-019  
192.36 A.

03-00-084-000-018  
113.06 A.

2

03-00-084-000-017  
51.58 A.

1


3

~~03-00-084-000-019~~  
~~192.11 A.~~

~~-021~~  
~~176.59 A.~~

03-00-084-000-014  
219.73 A

~~-020~~  
~~15.52 A.~~

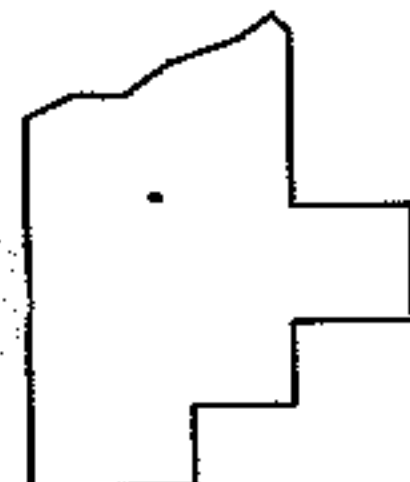

SPLITS/DEEDS PROCESSED

LORAIN COUNTY TAX MAP DEPARTMENT  
226 MIDDLE AVE. ELYRIA, OHIO

SURVEYED BY: MICHAEL STRAUB

CLOSURE: 0.00 : 10.000

MAP PAGE(S): 3-E, 3-F

APPROVED BY: JAH DATE: 2-26-04

SCALE: 1" = 1200 PRIOR INSTRUMENT: 20020850503