RASTER

PARENT PARCEL: 03-00-005-000-028

CHILD PARCEL: 03-00-005-000-061, -062

STARTING POINT: CENTERLINE OF ABBE RD. & FRENCH-CREEK RD.

NO. 01604

N

W E

S

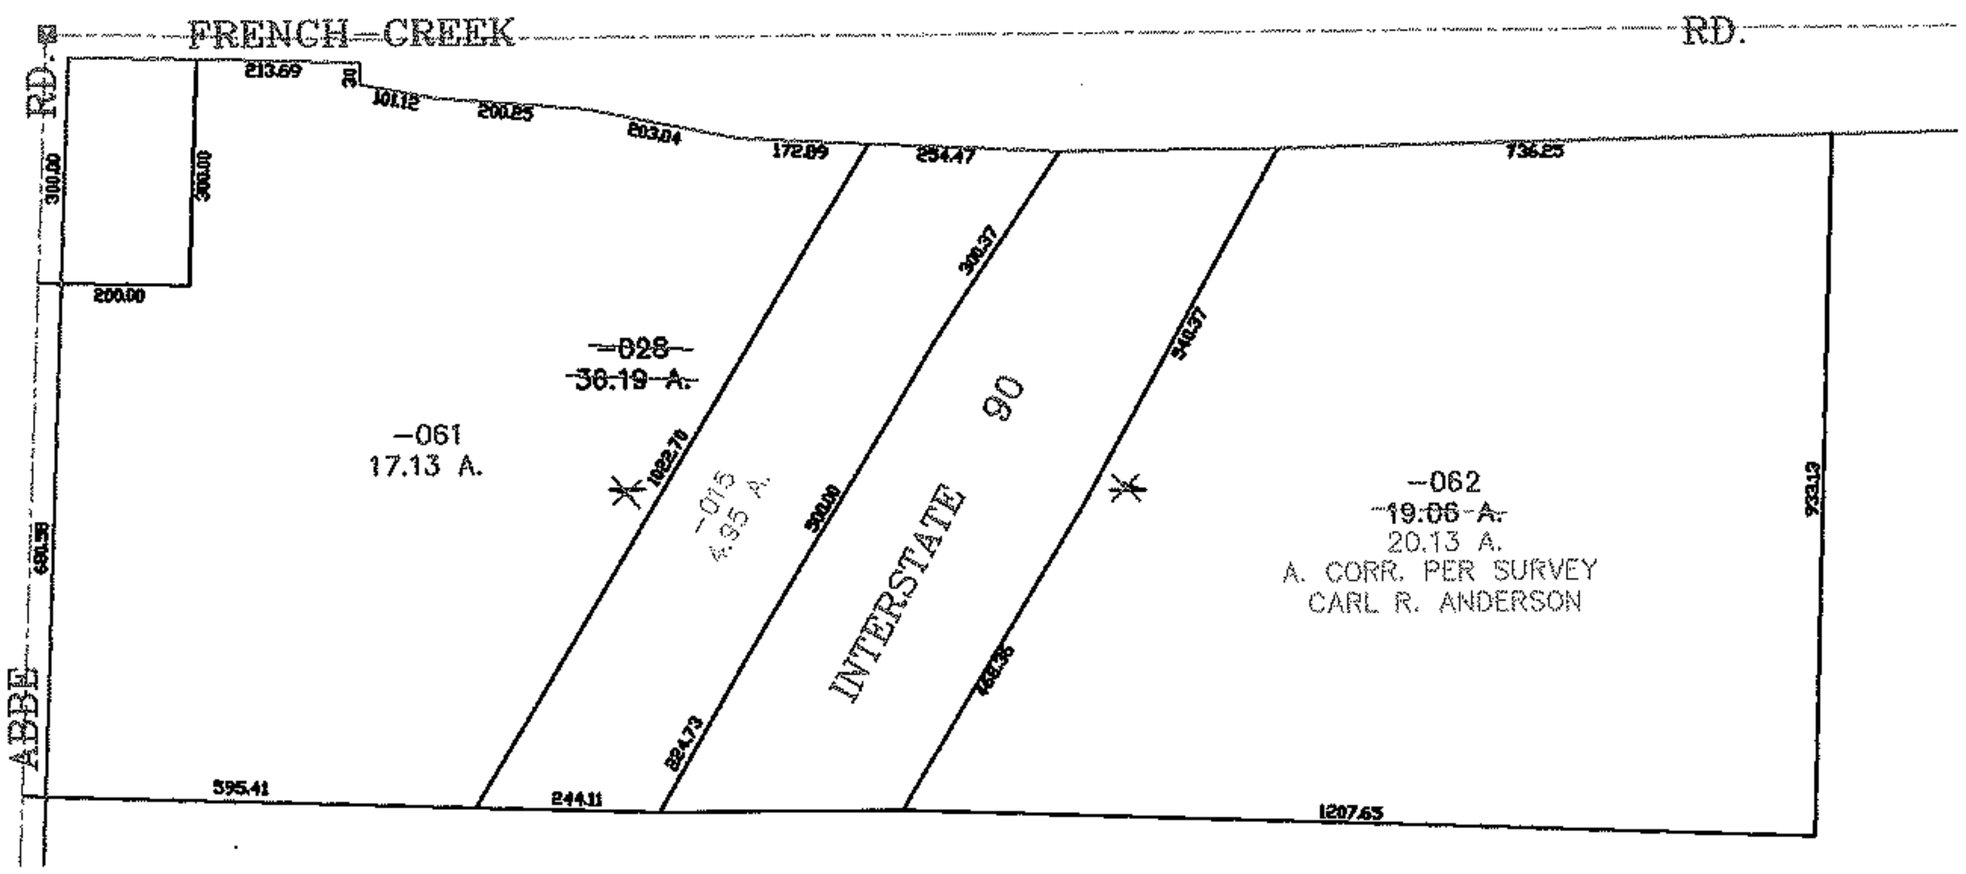

SPLITS/DEEDS PROCESSED

LORAIN COUNTY TAX MAP DEPARTMENT
226 MIDDLE AVE. ELYRIA, OHIO

SURVEYED BY: CARL R. ANDERSON

CLOSURE: 0.00 : 10,000

MAP PAGE(S): 3-00-005-A

APPROVED BY: JAH DATE: 3-8-04

SCALE: 1"= 400 PRIOR INSTRUMENT: DV 768/604