PARENT PARCEL: 01-00-041-000-024,01-00-056-000-069
CHILD PARCEL: 01-00-041-000-056,-057,01-00-056-000-078,-079
STARTING POINT: INTERSECTION OF EAST LINE OF BROWNHELM TWP. AND C/L OF RICE RD.

NO. 01622

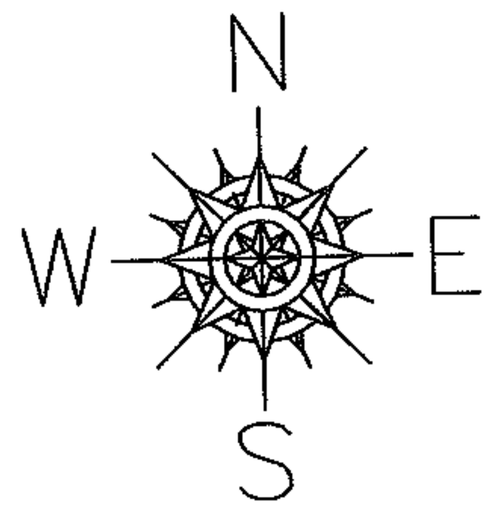

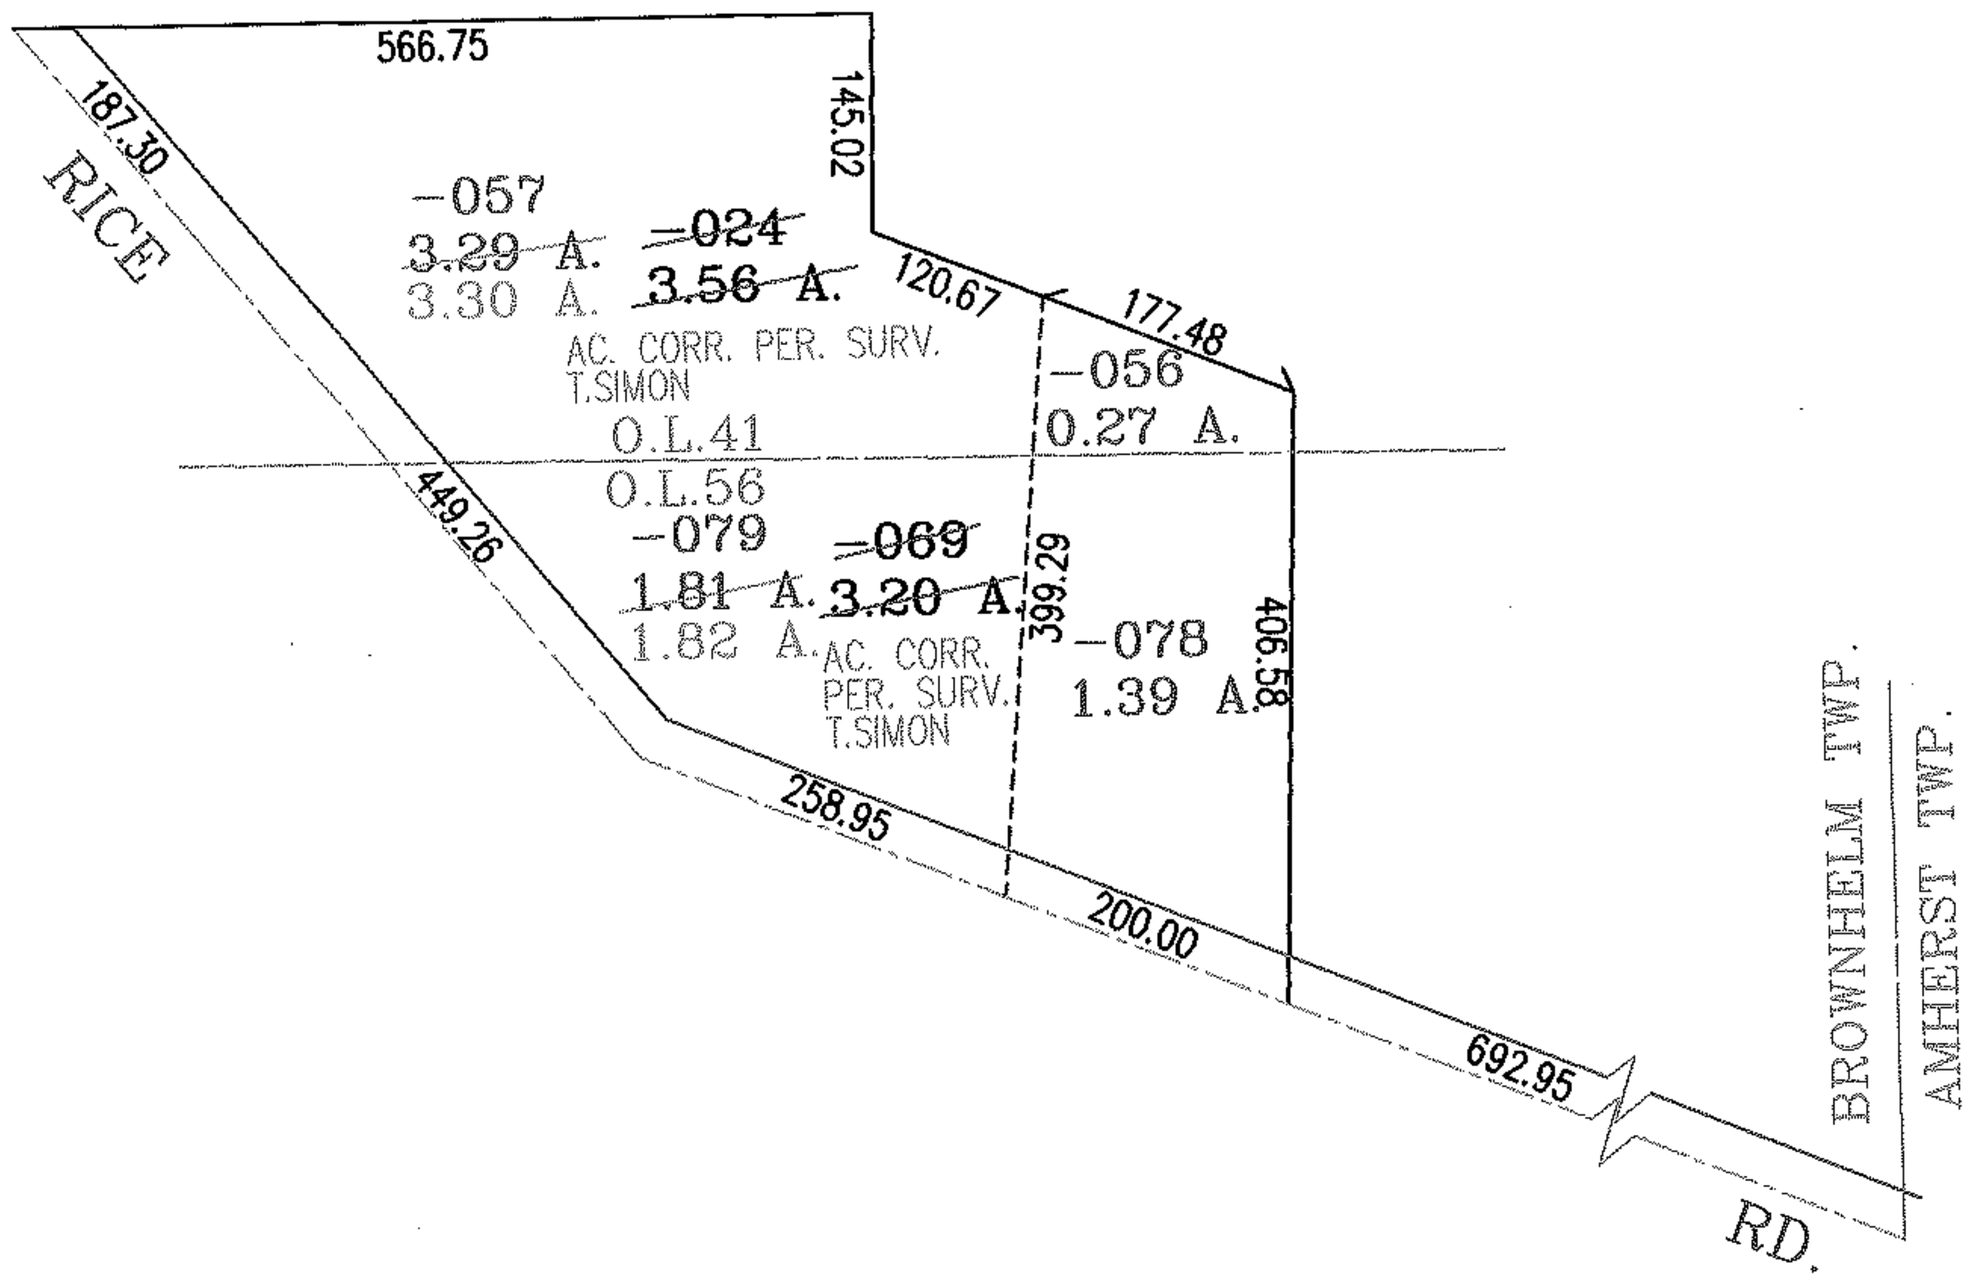

SPLITS/DEEDS PROCESSED
LORAIN COUNTY TAX MAP DEPARTMENT
226 MIDDLE AVE. ELYRIA, OHIO

SURVEYED BY: THOMAS A.SIMON
CLOSURE: .01:10,000
MAP PAGE(S): 1-H,1-L
APPROVED BY: RRM DATE: 3-30-04
SCALE: 1"= 200 PRIOR INSTRUMENT: 20010799697