RASTER

PARENT PARCEL: 09-00-074-103-070
CHILD PARCEL: 09-00-074-103-081,-082
STARTING POINT: NORTHEAST TERMINUS OF EASTERN AVE.

NO. 01623

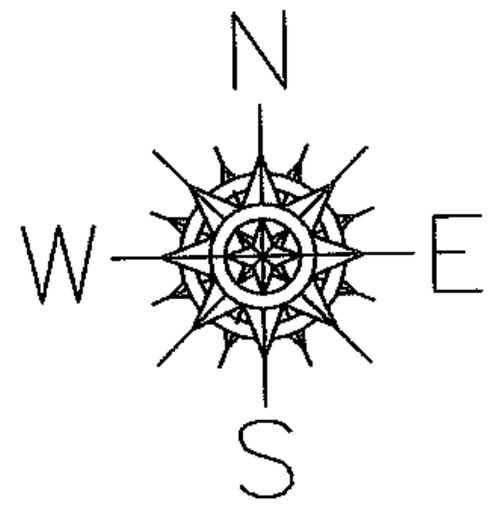

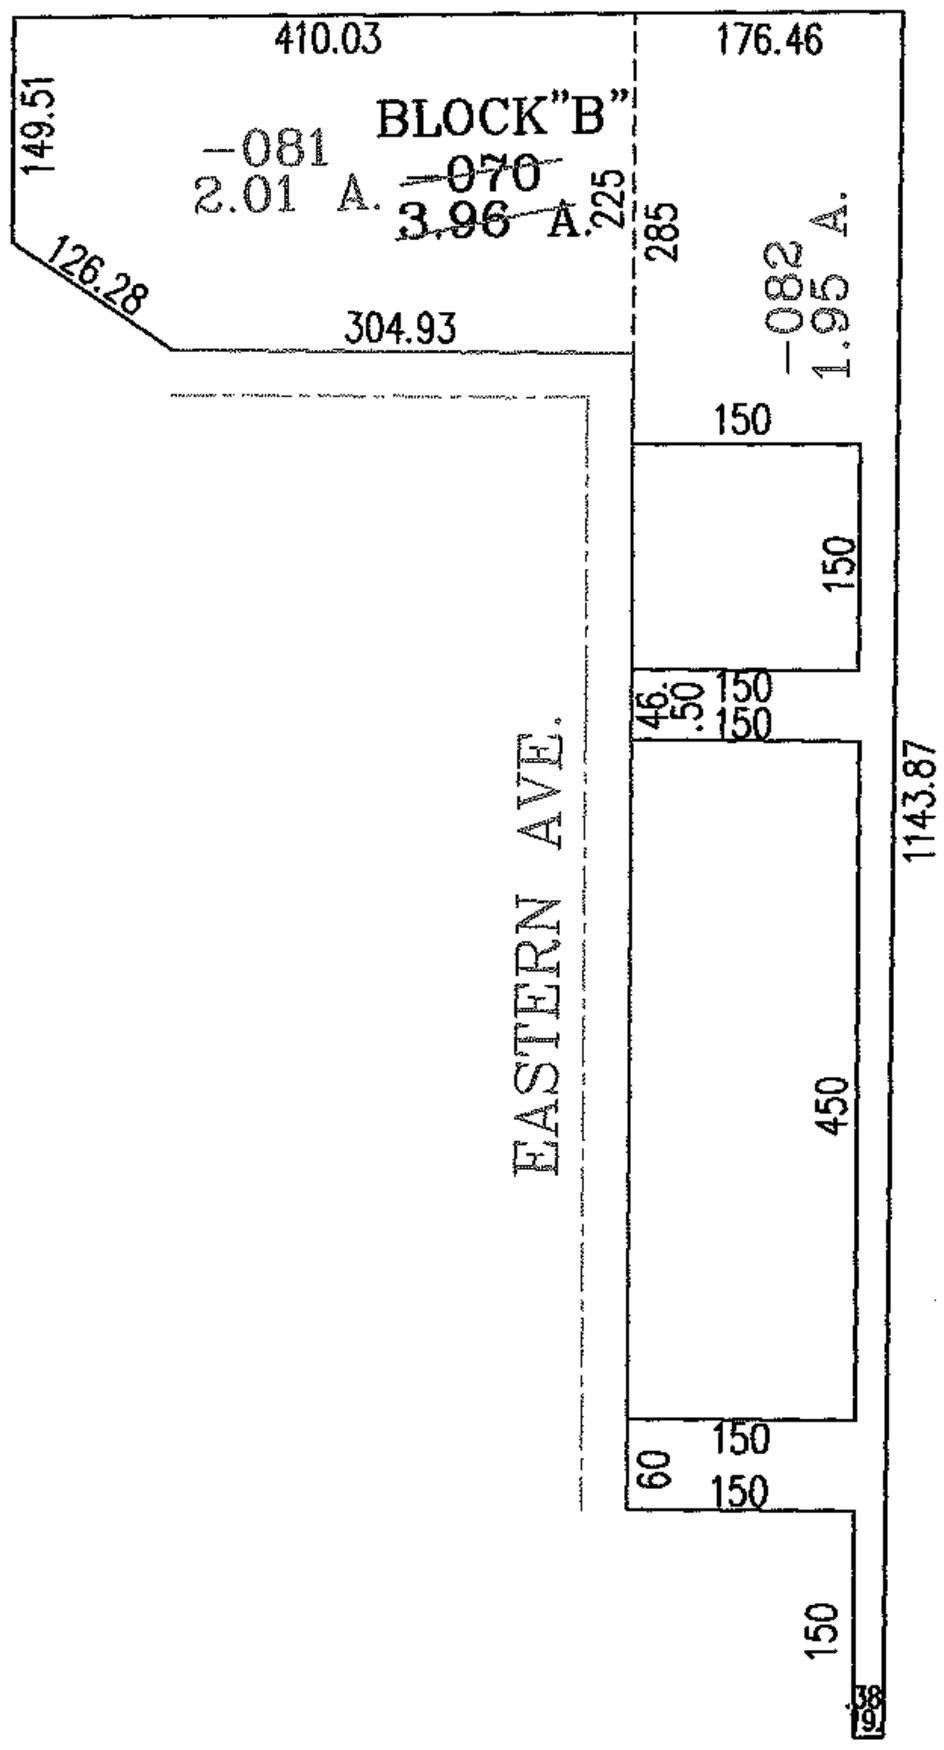

PART OF:
FUNK SUB.
VOL.63 PGS.58-60

SPLITS/DEEDS PROCESSED
LORAIN COUNTY TAX MAP DEPARTMENT
226 MIDDLE AVE. ELYRIA, OHIO

SURVEYED BY: PETER D. ZWICK
CLOSURE: .01:10,000
MAP PAGE(S): 9-00-074-B
APPROVED BY: RRM DATE: 4-5-04
SCALE: 1"= 200 PRIOR INSTRUMENT: 970484281