RASTER

PARENT PARCEL: 07-00-024-102-047,-048,07-00-013-000-144

CHILD PARCEL: 07-00-024-102-053 THRU -055

STARTING POINT: INTERSECTION OF EAST LINE OF O.L.24 AND SOUTH LINE OF RIDGEVILLE TWP.

NO. 01625

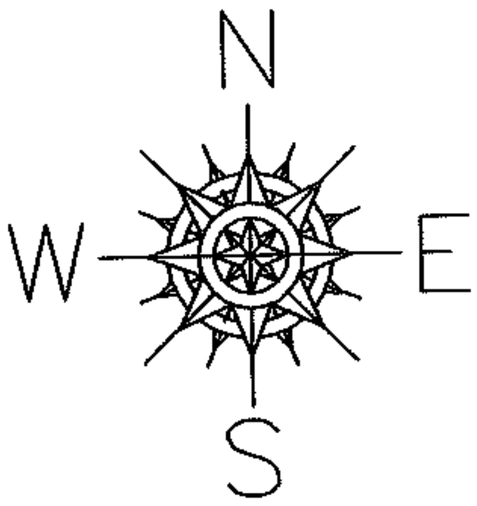

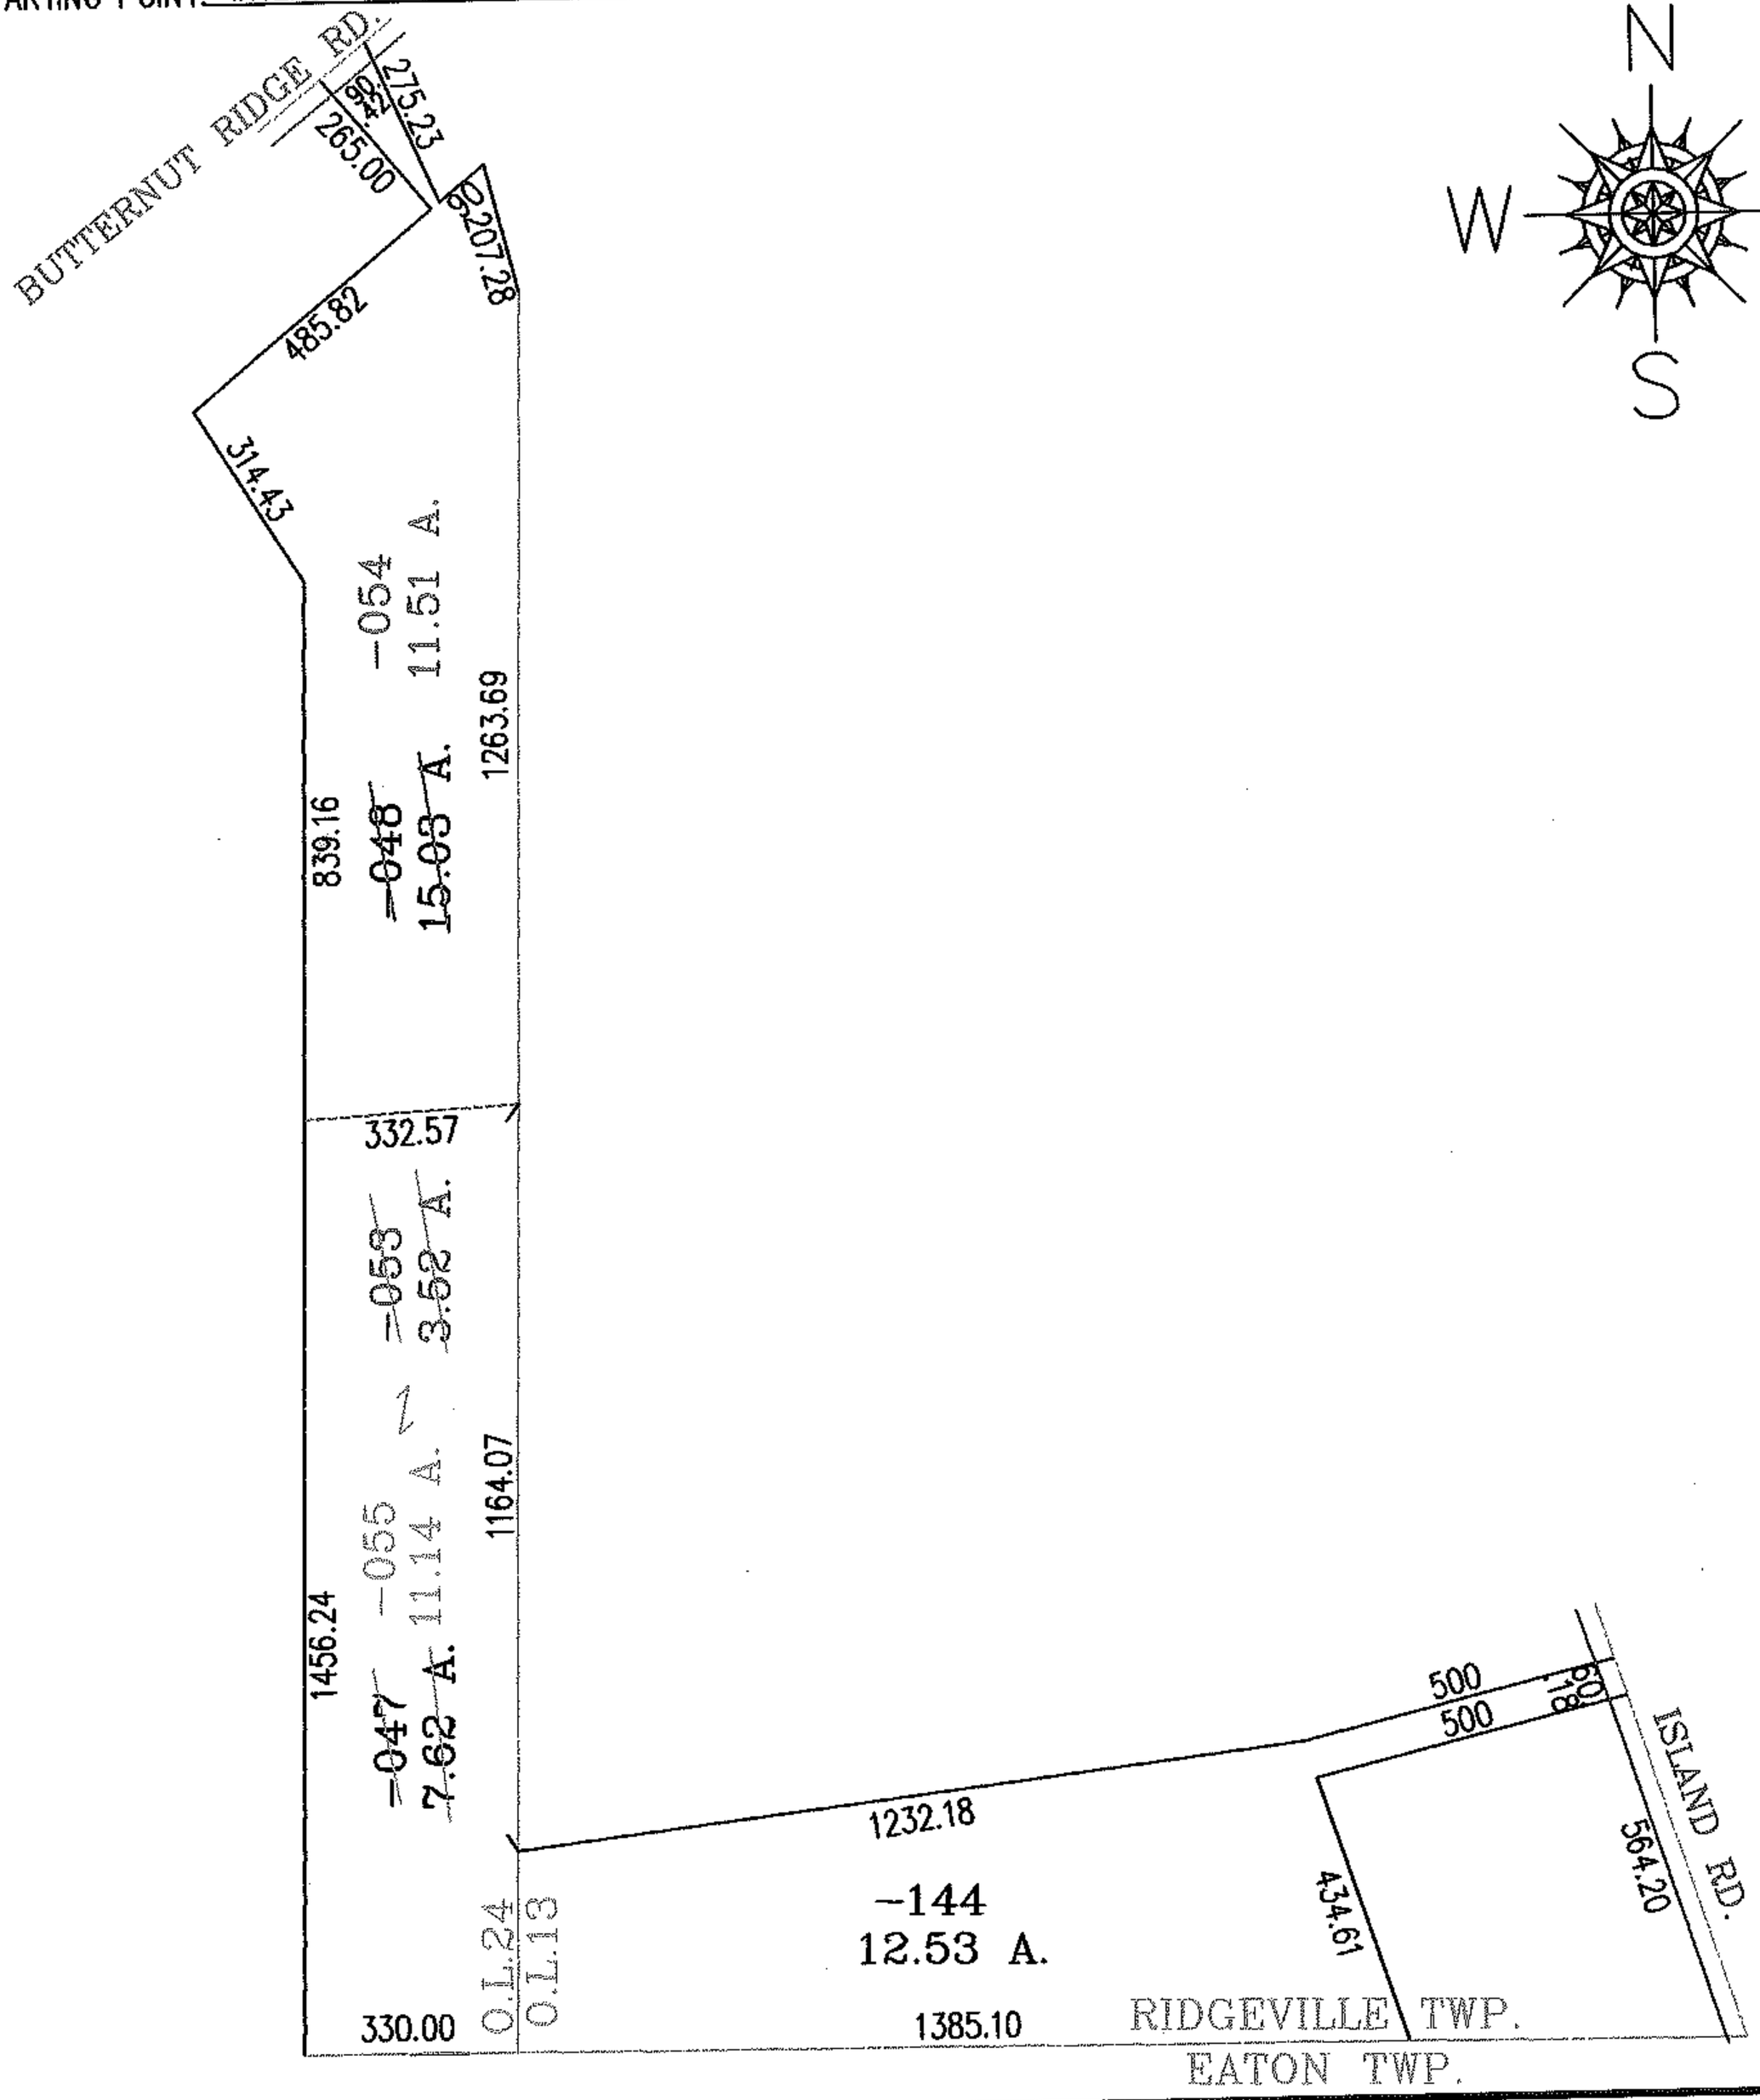

SPLITS/DEEDS PROCESSED

LORAIN COUNTY TAX MAP DEPARTMENT
226 MIDDLE AVE. ELYRIA, OHIO

SURVEYED BY: DANE A. HAPONEK

CLOSURE: .01:10,000

MAP PAGE(S): 7-00-024-C&D

APPROVED BY: RRM DATE: 4/8/04

SCALE: 1"= 400 PRIOR INSTRUMENT: 20020857566