RASTER

PARENT PARCEL: 11-00-070-000-130
CHILD PARCEL: 11-00-070-000-138 THRU -142,11-00-069-000-012
STARTING POINT: INTERSECTION OF C/L OF ARCHER RD. AND C/L OF BUTTERNUT RIDGE RD.

NO. 01647

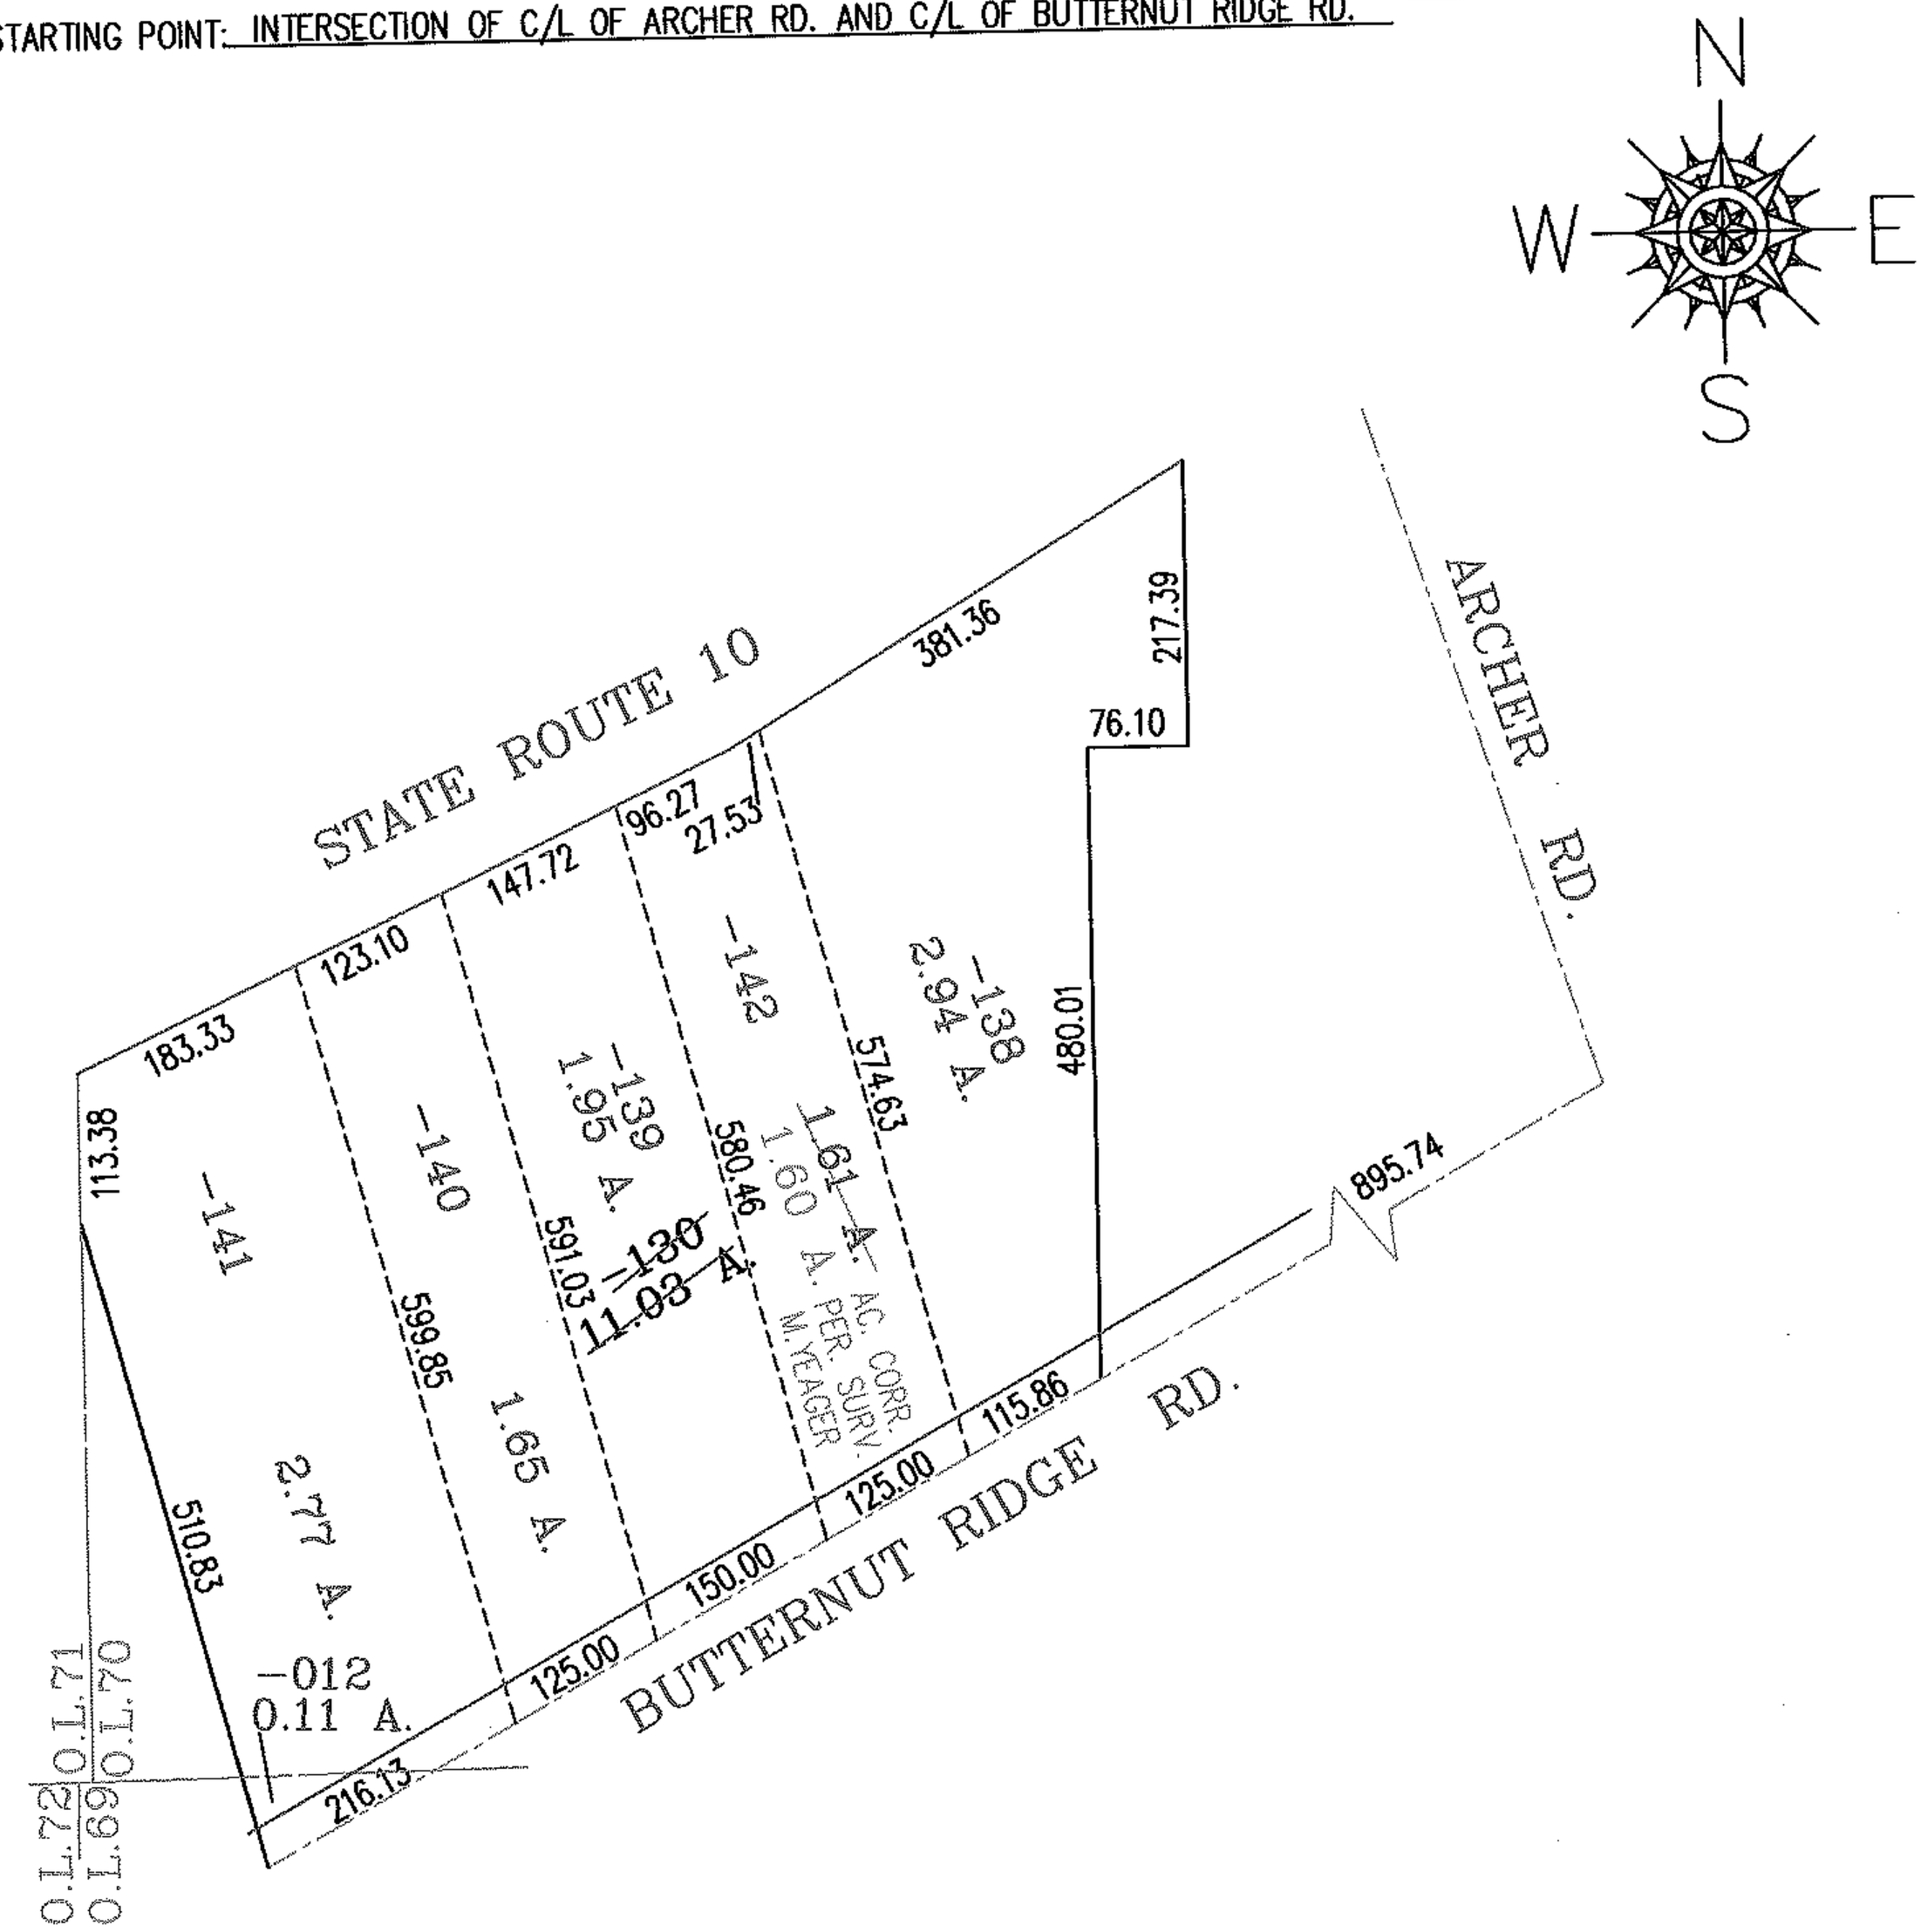

2 OF 2

SPLITS/DEEDS PROCESSED
LORAIN COUNTY TAX MAP DEPARTMENT
226 MIDDLE AVE. ELYRIA, OHIO

SURVEYED BY: MARK ALLEN YEAGER
CLOSURE: .01:10,000
MAP PAGE(S): 11-00-070-A&B
APPROVED BY: RRM DATE: 5-10-04
SCALE: 1"= 200 PRIOR INSTRUMENT: 20040993696