PASTER

PARENT PARCEL: 04-00-018-128-227

CHILD PARCEL: 04-00-018-128-229,-230

STARTING POINT: INTERSECTION OF C/L OF AVON-BELDON RD.(S.R.83) AND C/L OF WALKER RD.

NO. 01649

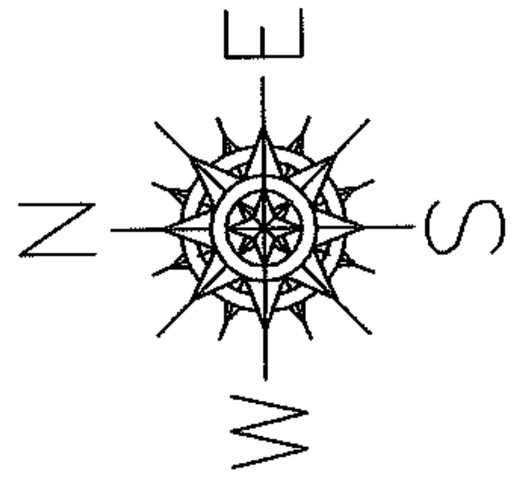

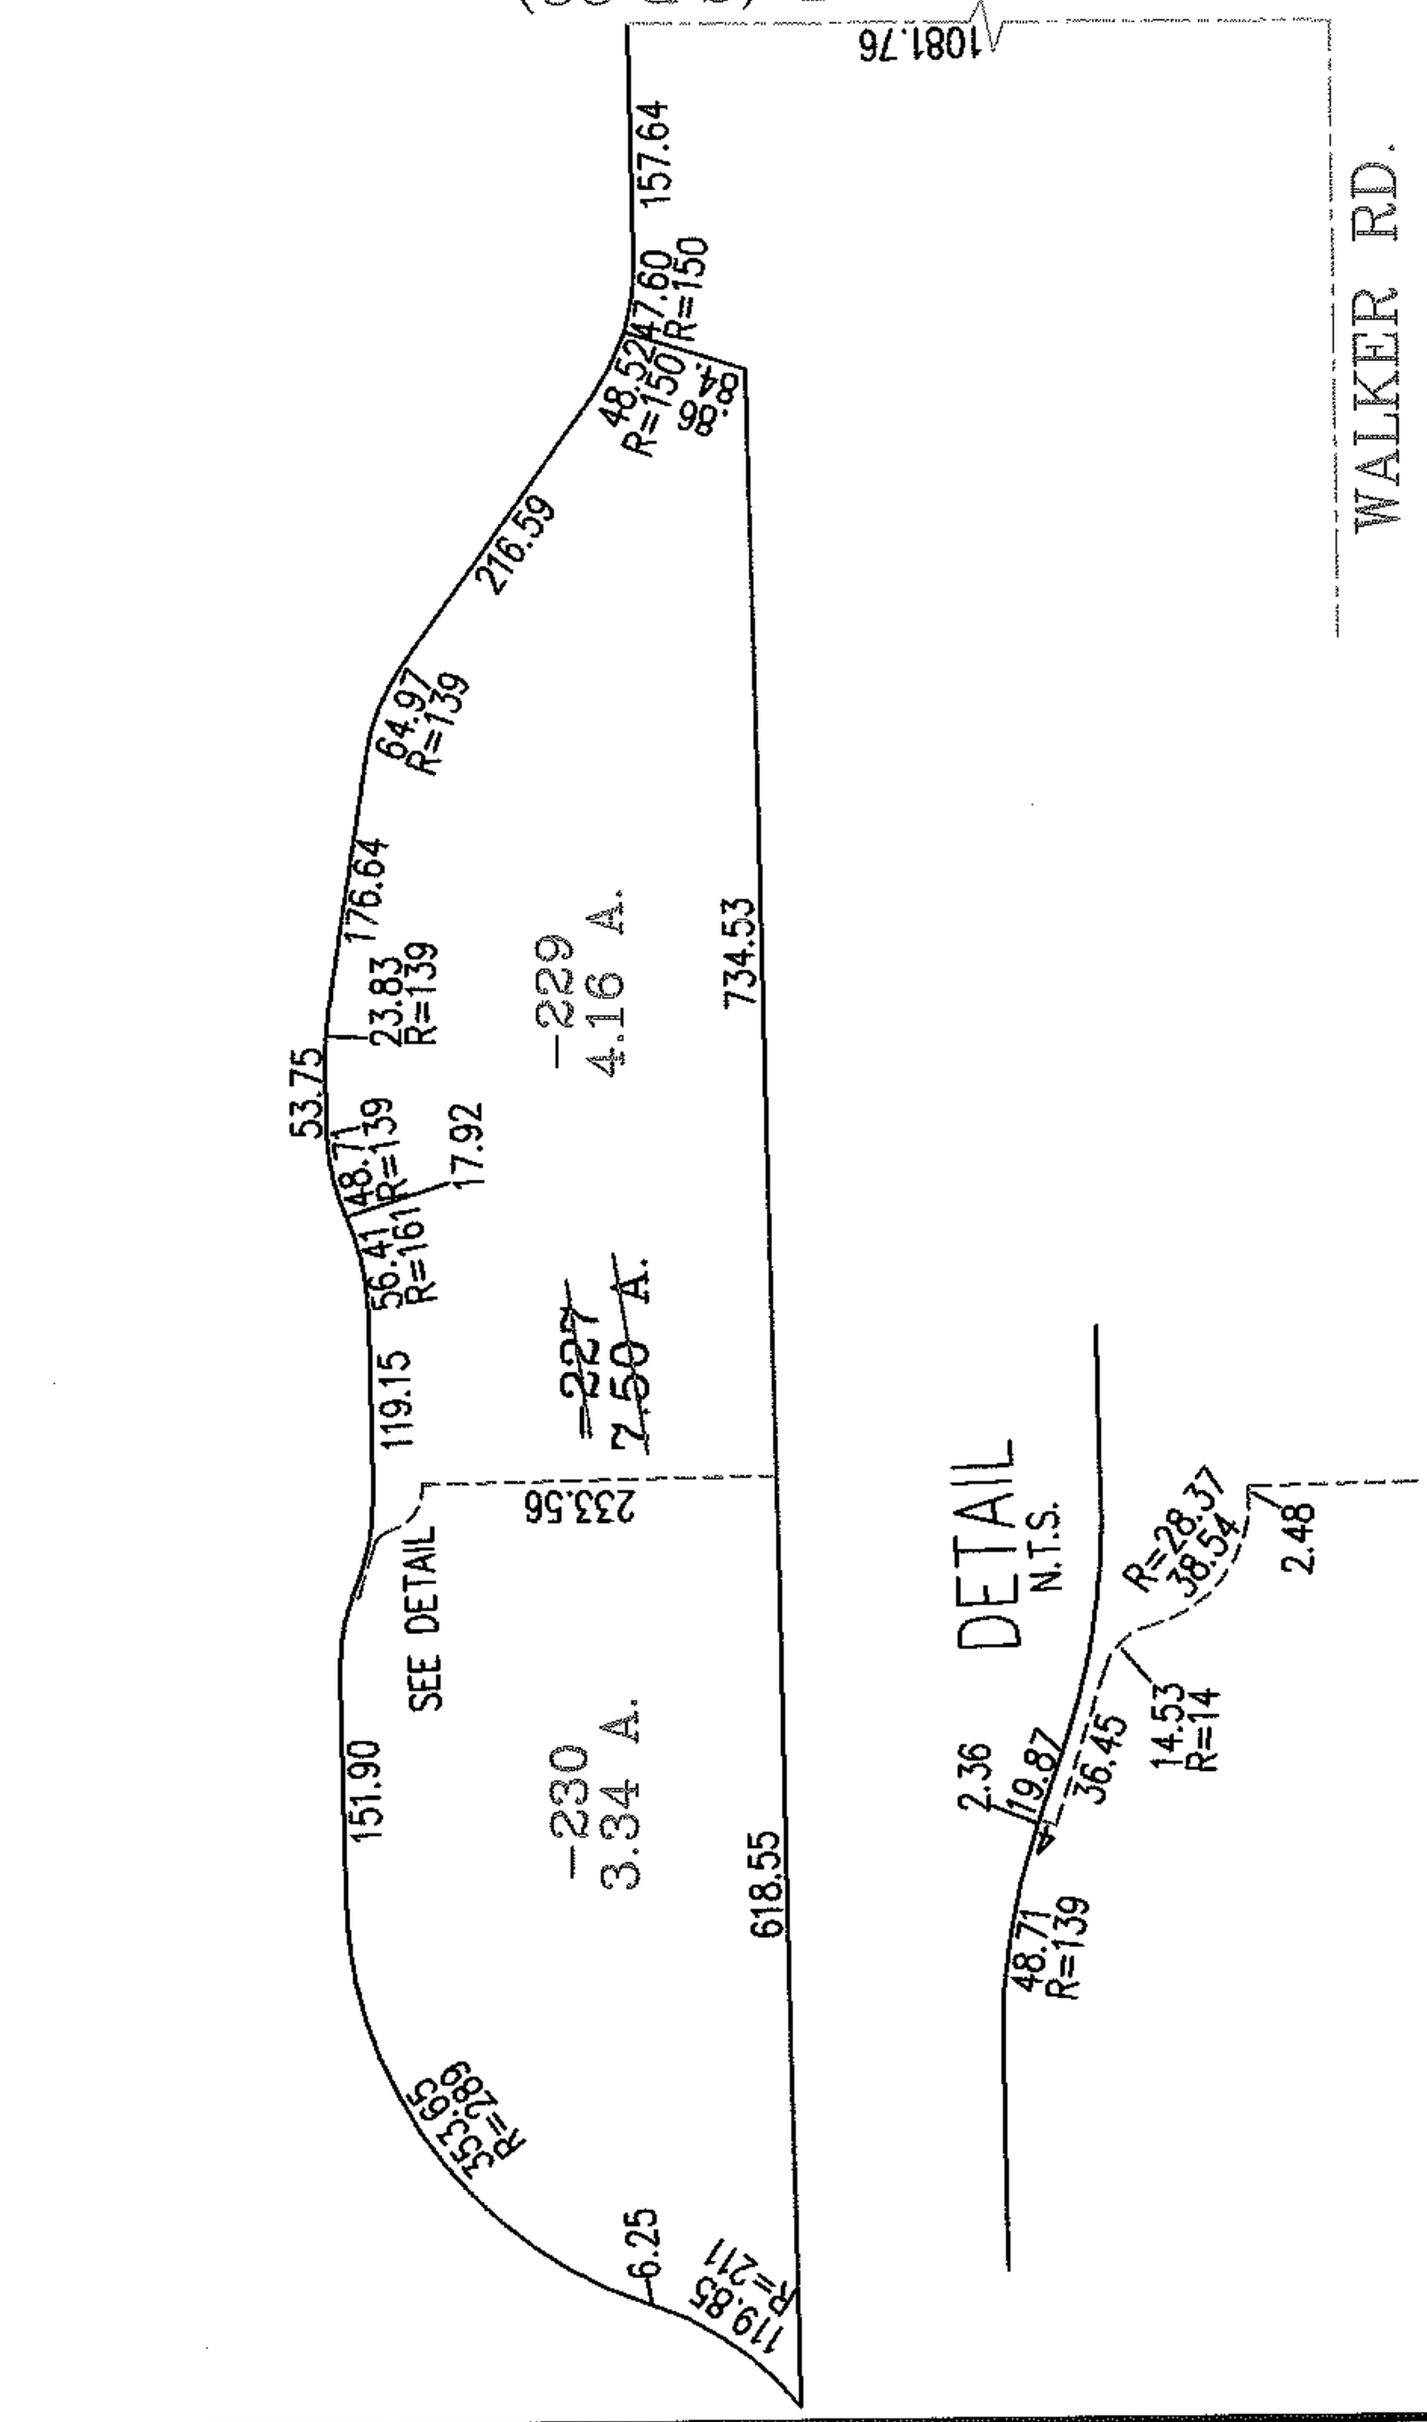

SPLITS/DEEDS PROCESSED

LORAIN COUNTY TAX MAP DEPARTMENT
226 MIDDLE AVE. ELYRIA, OHIO

SURVEYED BY: DAVID L. ELWELL

CLOSURE: .01:10,000

MAP PAGE(S): 4-00-018-J

APPROVED BY: RRM DATE: 5-11-04

SCALE: 1"= 200 PRIOR INSTRUMENT: 2002087340