RASTER

PARENT PARCEL: 02-02-009-101-026

CHILD PARCEL: 02-02-009-101-030, & -031

STARTING POINT: CL OF JAEGER RD. & WEST LINE OF O.L. 9

NO. 01652

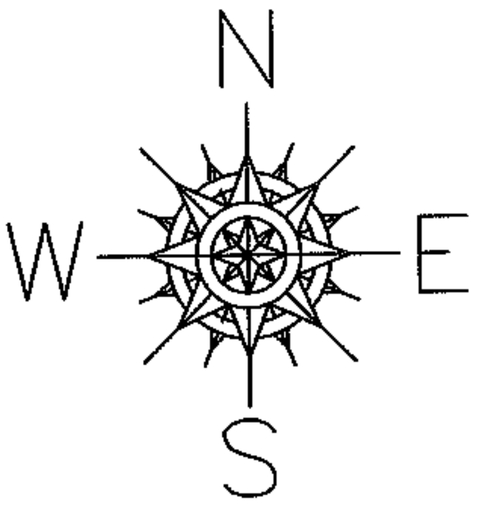

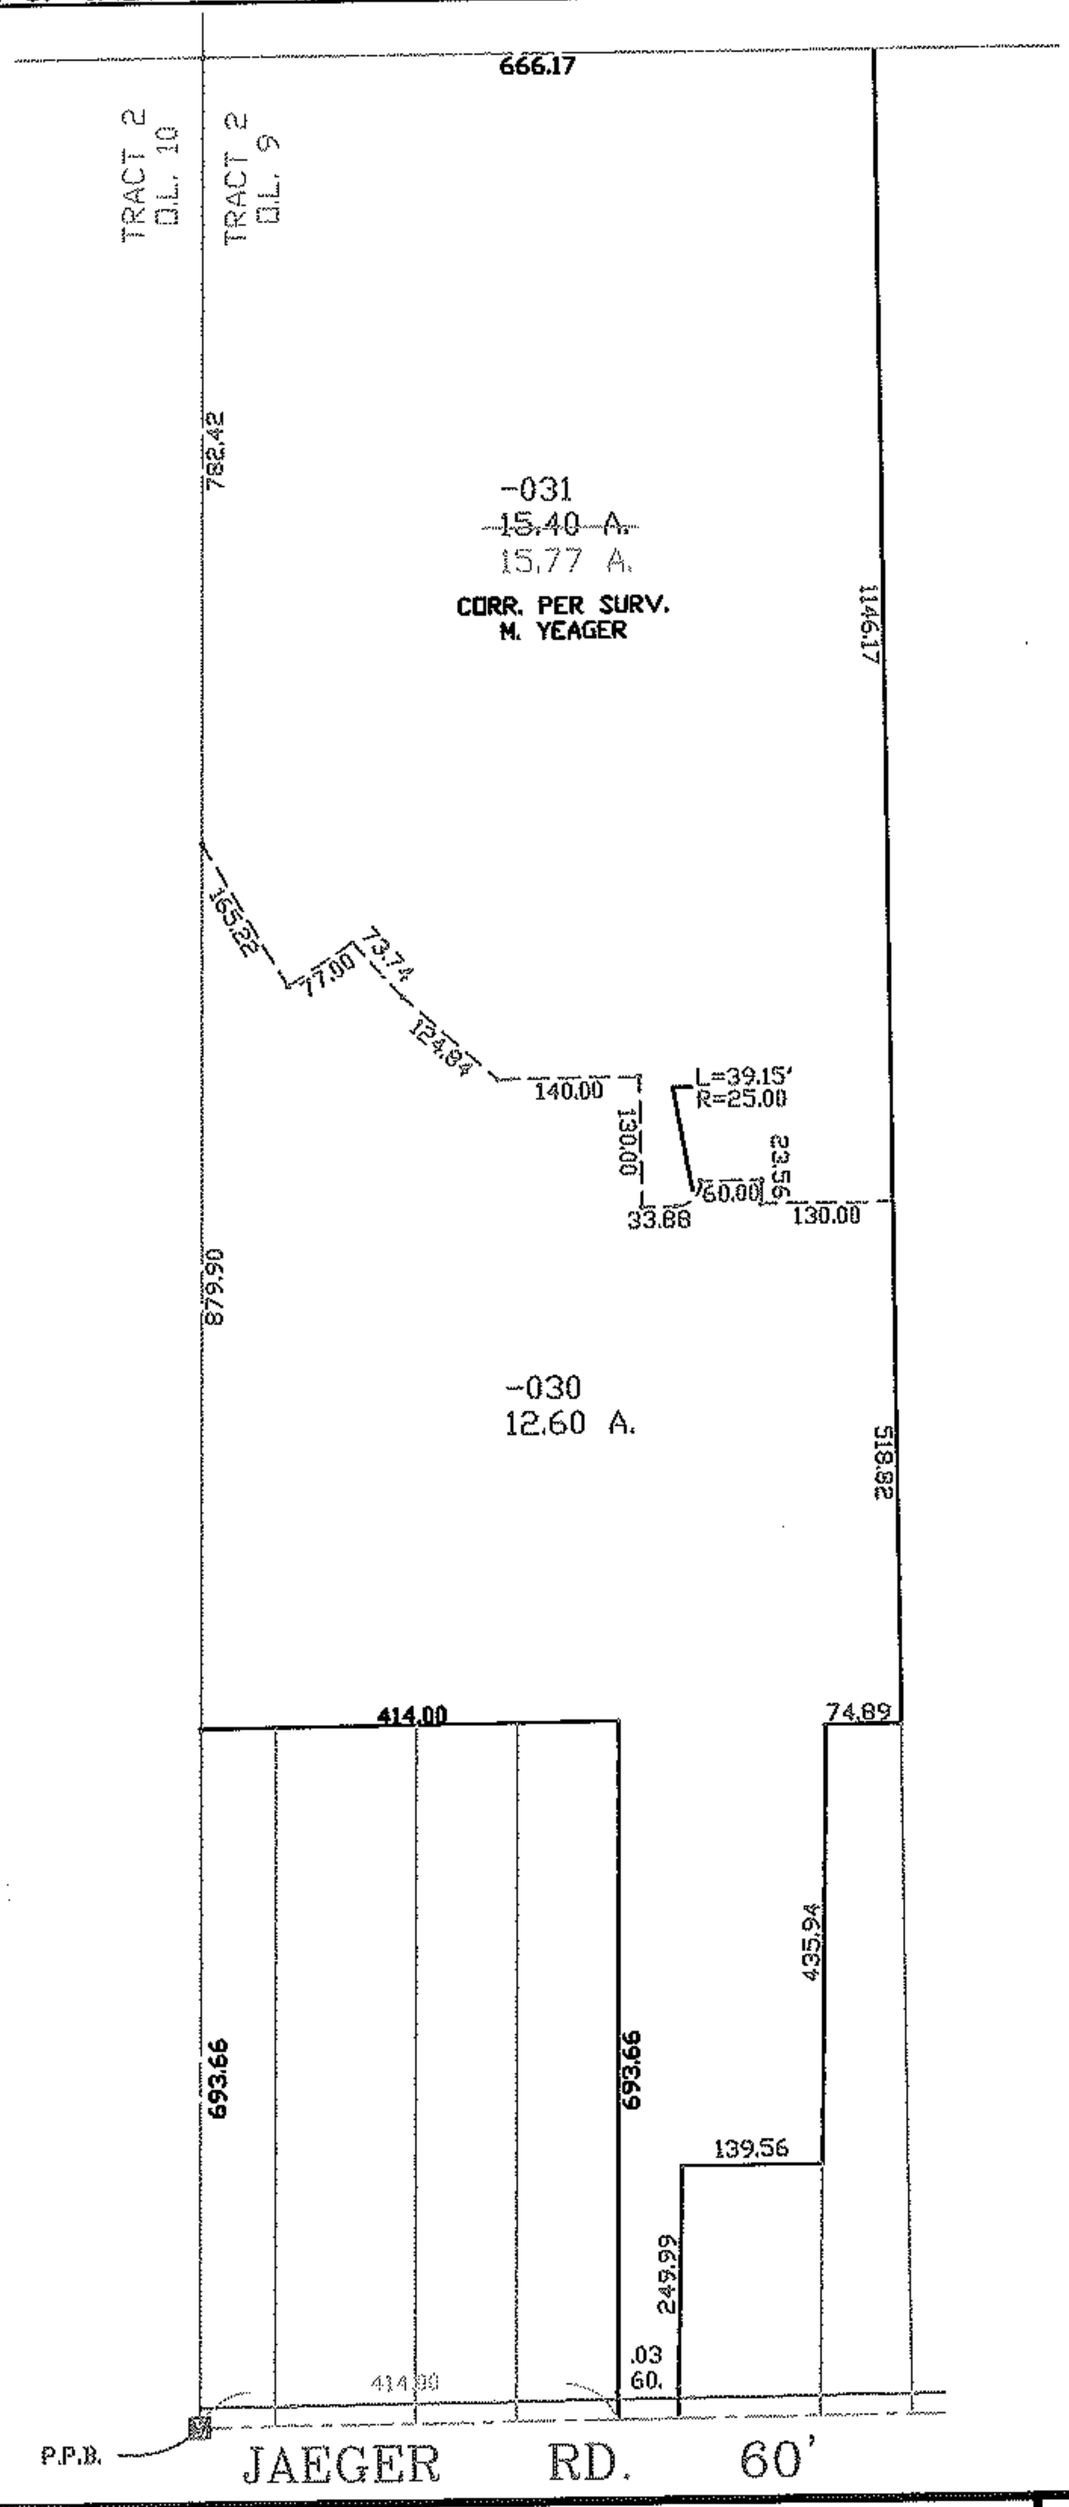

SPLITS/DEEDS PROCESSED

LORAIN COUNTY TAX MAP DEPARTMENT
226 MIDDLE AVE. ELYRIA, OHIO

SURVEYED BY: MARK YEAGER

CLOSURE: 0.01 : 10,000

MAP PAGE(S): 2-02-009-A

APPROVED BY: TJS DATE: 5/6/04

SCALE: 1"= 300 PRIOR INSTRUMENT: DV 1354/109