RASTER

PARENT PARCEL: 11-00-020-000-026, -027

CHILD PARCEL: 11-00-020-000-028 THRU -030

STARTING POINT: CENTERLINE OF COWLEY RD. & O.L. 20

NO. 01657

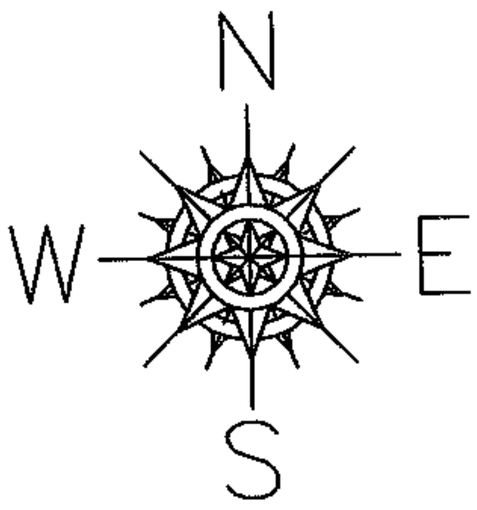

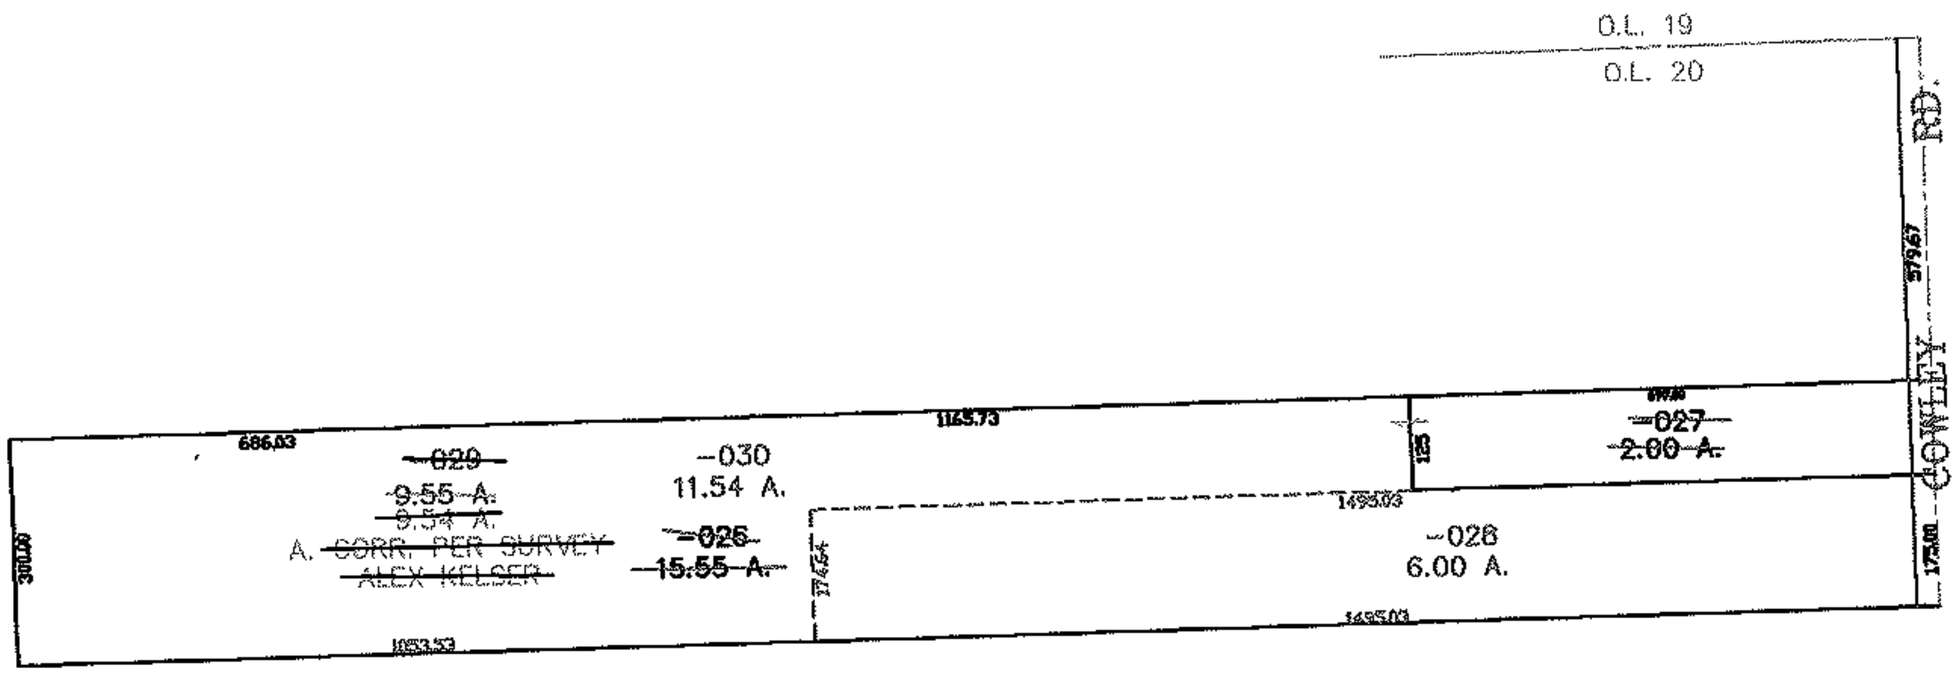

SPLITS/DEEDS PROCESSED

LORAIN COUNTY TAX MAP DEPARTMENT
226 MIDDLE AVE. ELYRIA, OHIO

SURVEYED BY: ALEX KELSER

CLOSURE: 0.00 : 10,000

MAP PAGE(S): 11-00-020-A, B

APPROVED BY: JAH DATE: 5-18-04

SCALE: 1"= 400 PRIOR INSTRUMENT: 20020804945