RASTER

PARENT PARCEL: 15-00-062-000-023, -030, -034

CHILD PARCEL: 1500-062-000-043 THRU -046

STARTING POINT: CENTERLINE OF NICKLE PLATE DIAGONAL RD. & WHITNEY RD.

NO. 01679

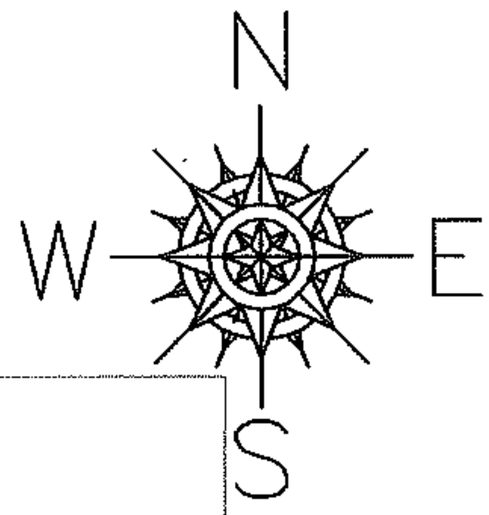

RD.

200.00

300.00

2170.57

-034
~~40.58 A.~~

1201.30

-046
~~90.41 A.~~
90.85 A.
A. CORR. PER SURVEY
RICHARD D. CARLSON

1807.24

~~-023~~
~~44.96~~

~~-044~~
~~40.83 A.~~

653.45

-022
3.00 A.

-016
3.00 A.

653.45

400.00

450.00

~~-043~~
~~4.13 A.~~

-045
6.94 A.

400.00

450.00

1368.07

140.00

~~-030~~ ~~2.81 A.~~

874.69

140.00

1332.81

NICKLE PLATE DIAGONAL

792.81

WHITNEY RD.

SPLITS/DEEDS PROCESSED

LORAIN COUNTY TAX MAP DEPARTMENT
226 MIDDLE AVE. ELYRIA, OHIO

SURVEYED BY: RICHARD D. CARLSON

CLOSURE: 0.00 : 10,000

MAP PAGE(S): 15-F

APPROVED BY: JAH DATE: 6-14-04

SCALE: 1"= 400 PRIOR INSTRUMENT: OR 1167/8