04-01682

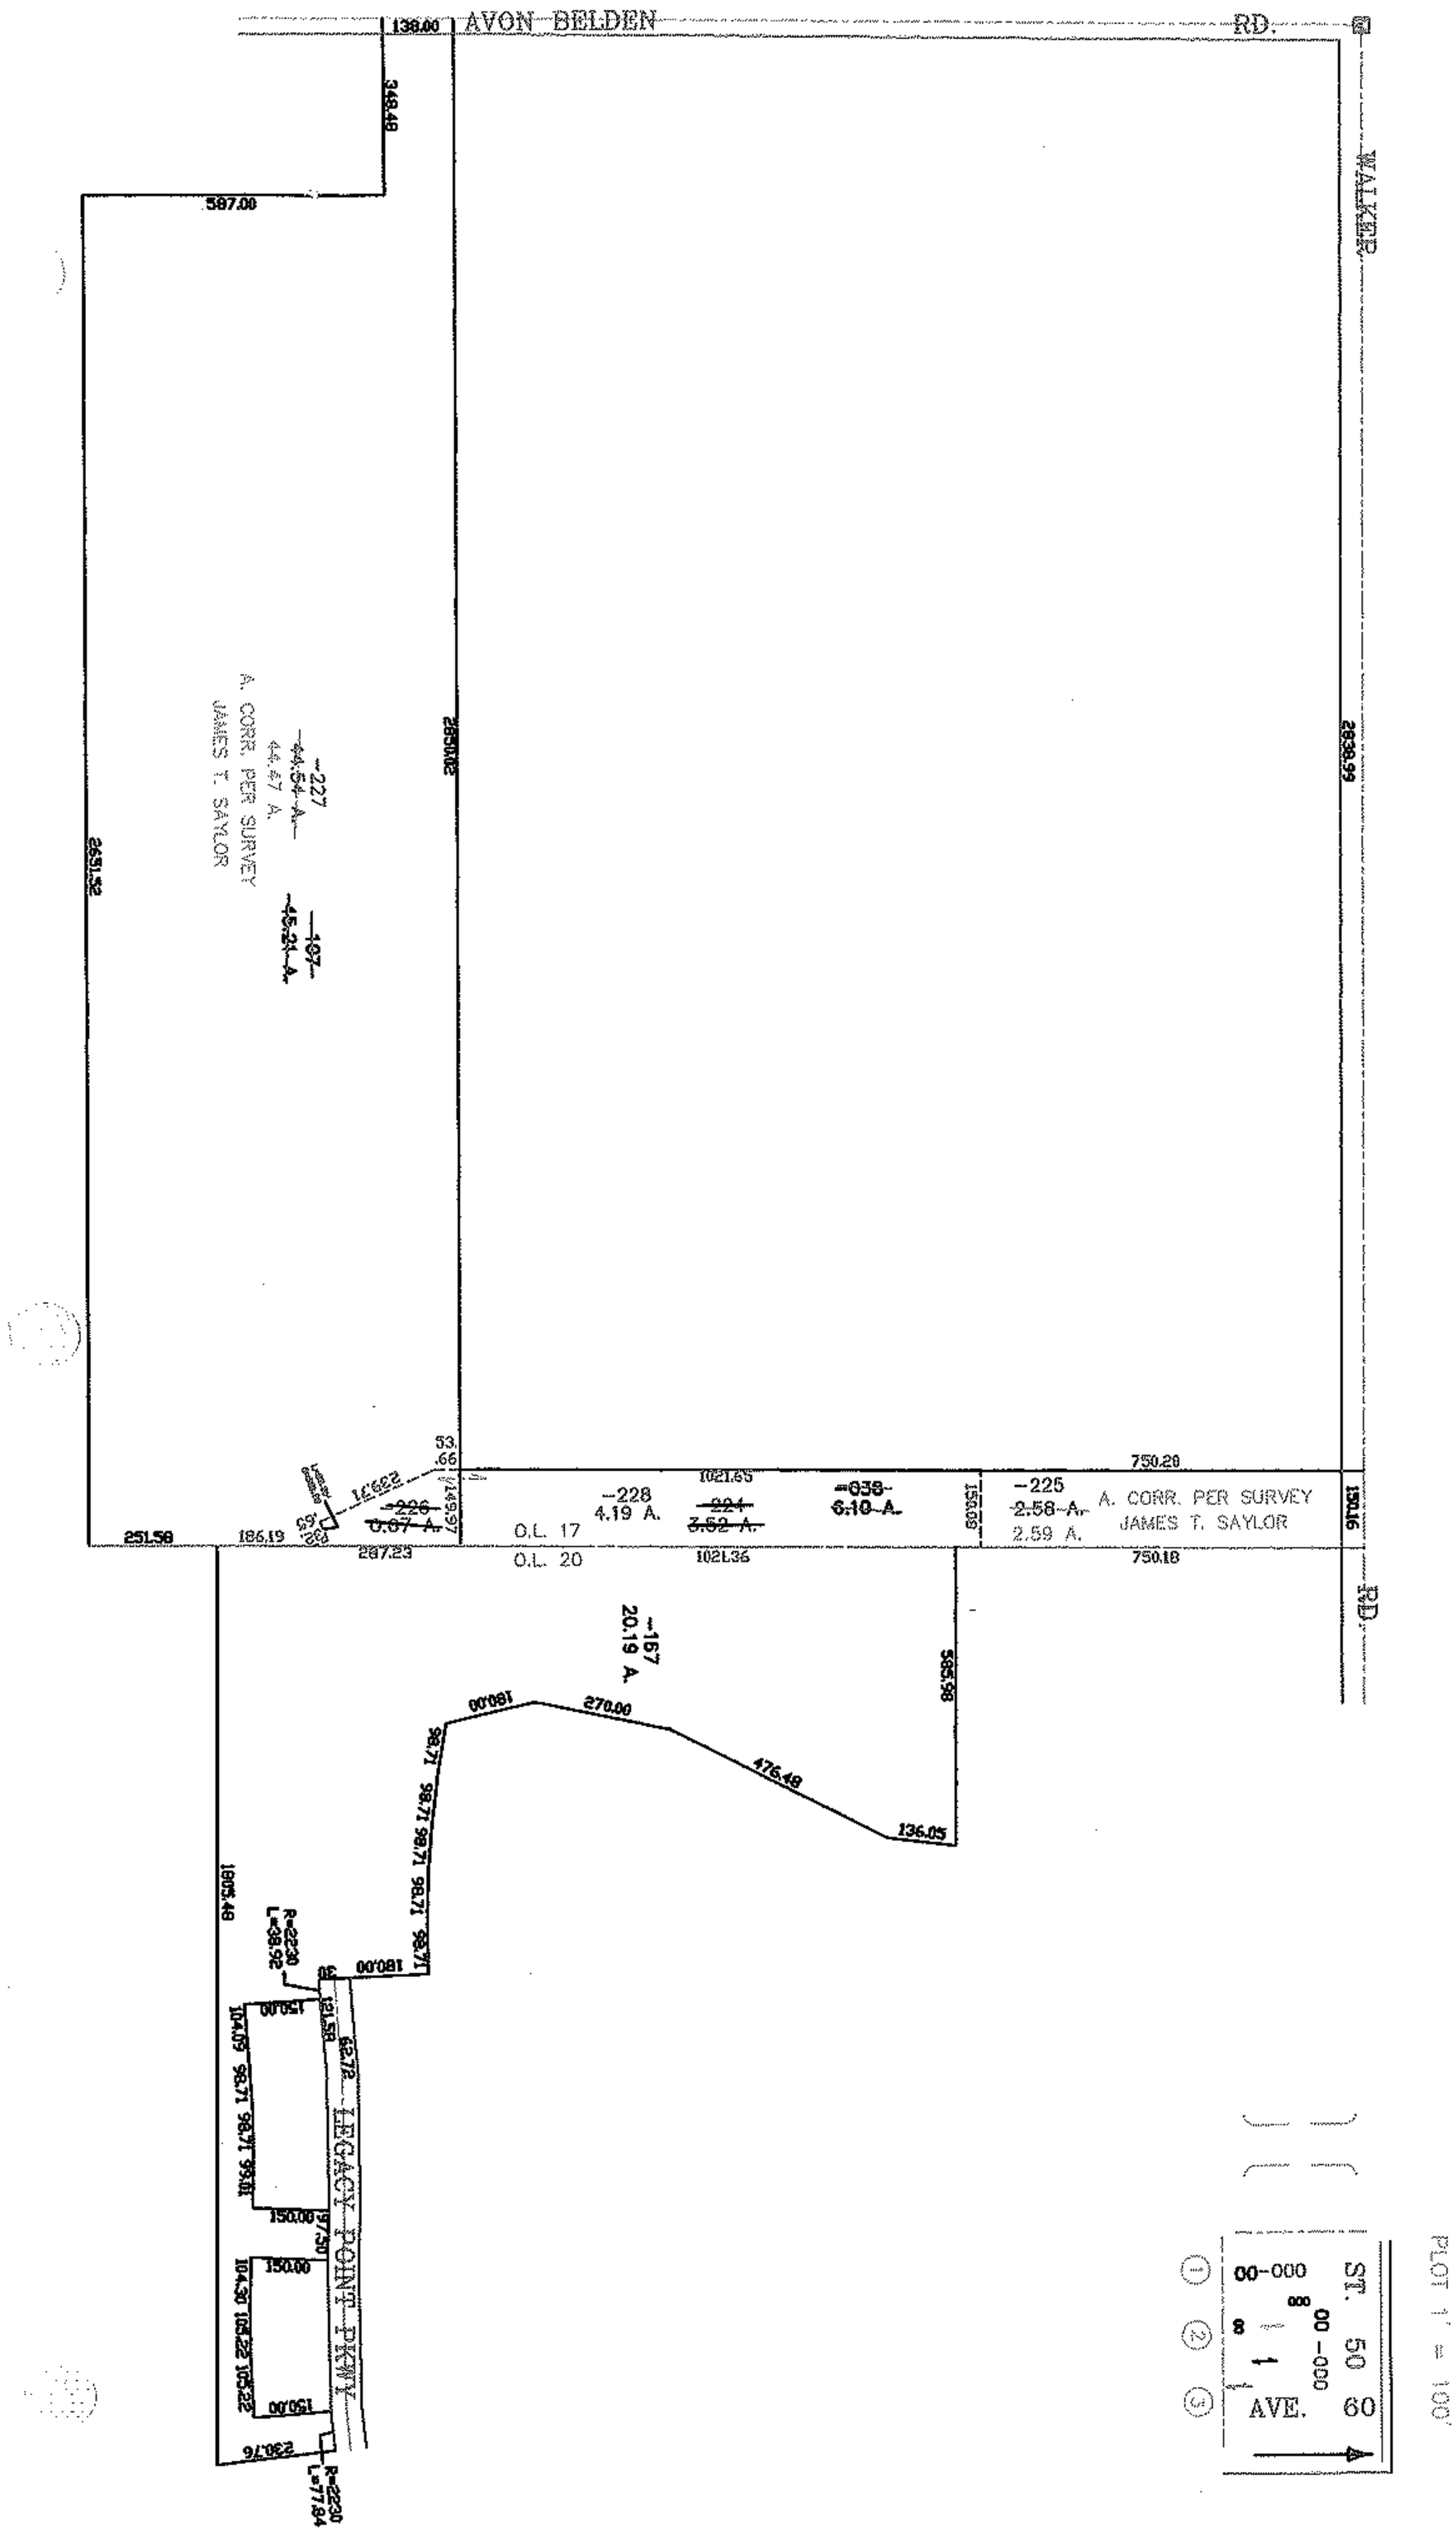
AVON BELDEN RD.
WALKER
138.00
348.49
597.00
2651.52
2651.02
2639.99
1905.46
-227
~~44.54 A.~~
44.67 A.
A. CORR. PER SURVEY
JAMES T. SAYLOR
-107-
~~45.21 A.~~
-226
~~0.67 A.~~
-228
4.19 A.
~~-224-~~
~~3.52 A.~~
~~-038-~~
~~6.10 A.~~
-225
~~2.58 A.~~
2.59 A.
A. CORR. PER SURVEY
JAMES T. SAYLOR
O.L. 17
O.L. 20
1021.85
1021.36
750.20
750.18
251.58
186.19
287.23
-167
20.19 A.
585.58
180.00
270.00
476.49
136.05
98.71
104.09
104.30
105.22
230.76
R=2230
L=38.92
R=2230
L=77.84
121.58
62.72
150.00
LEGACY POINT PKWY
ST. 50
AVE. 60
PLOT 1" = 100'