RASTER

PARENT PARCEL: 18-00-010-000-019

CHILD PARCEL: 18-00-010-000-020, -021

STARTING POINT: INTERSECTION OF C/L OF CEMETERY RD. AND C/L OF HAWLEY RD.

NO. 01683

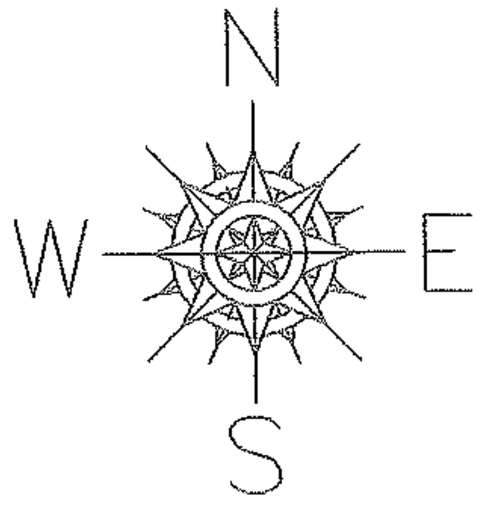

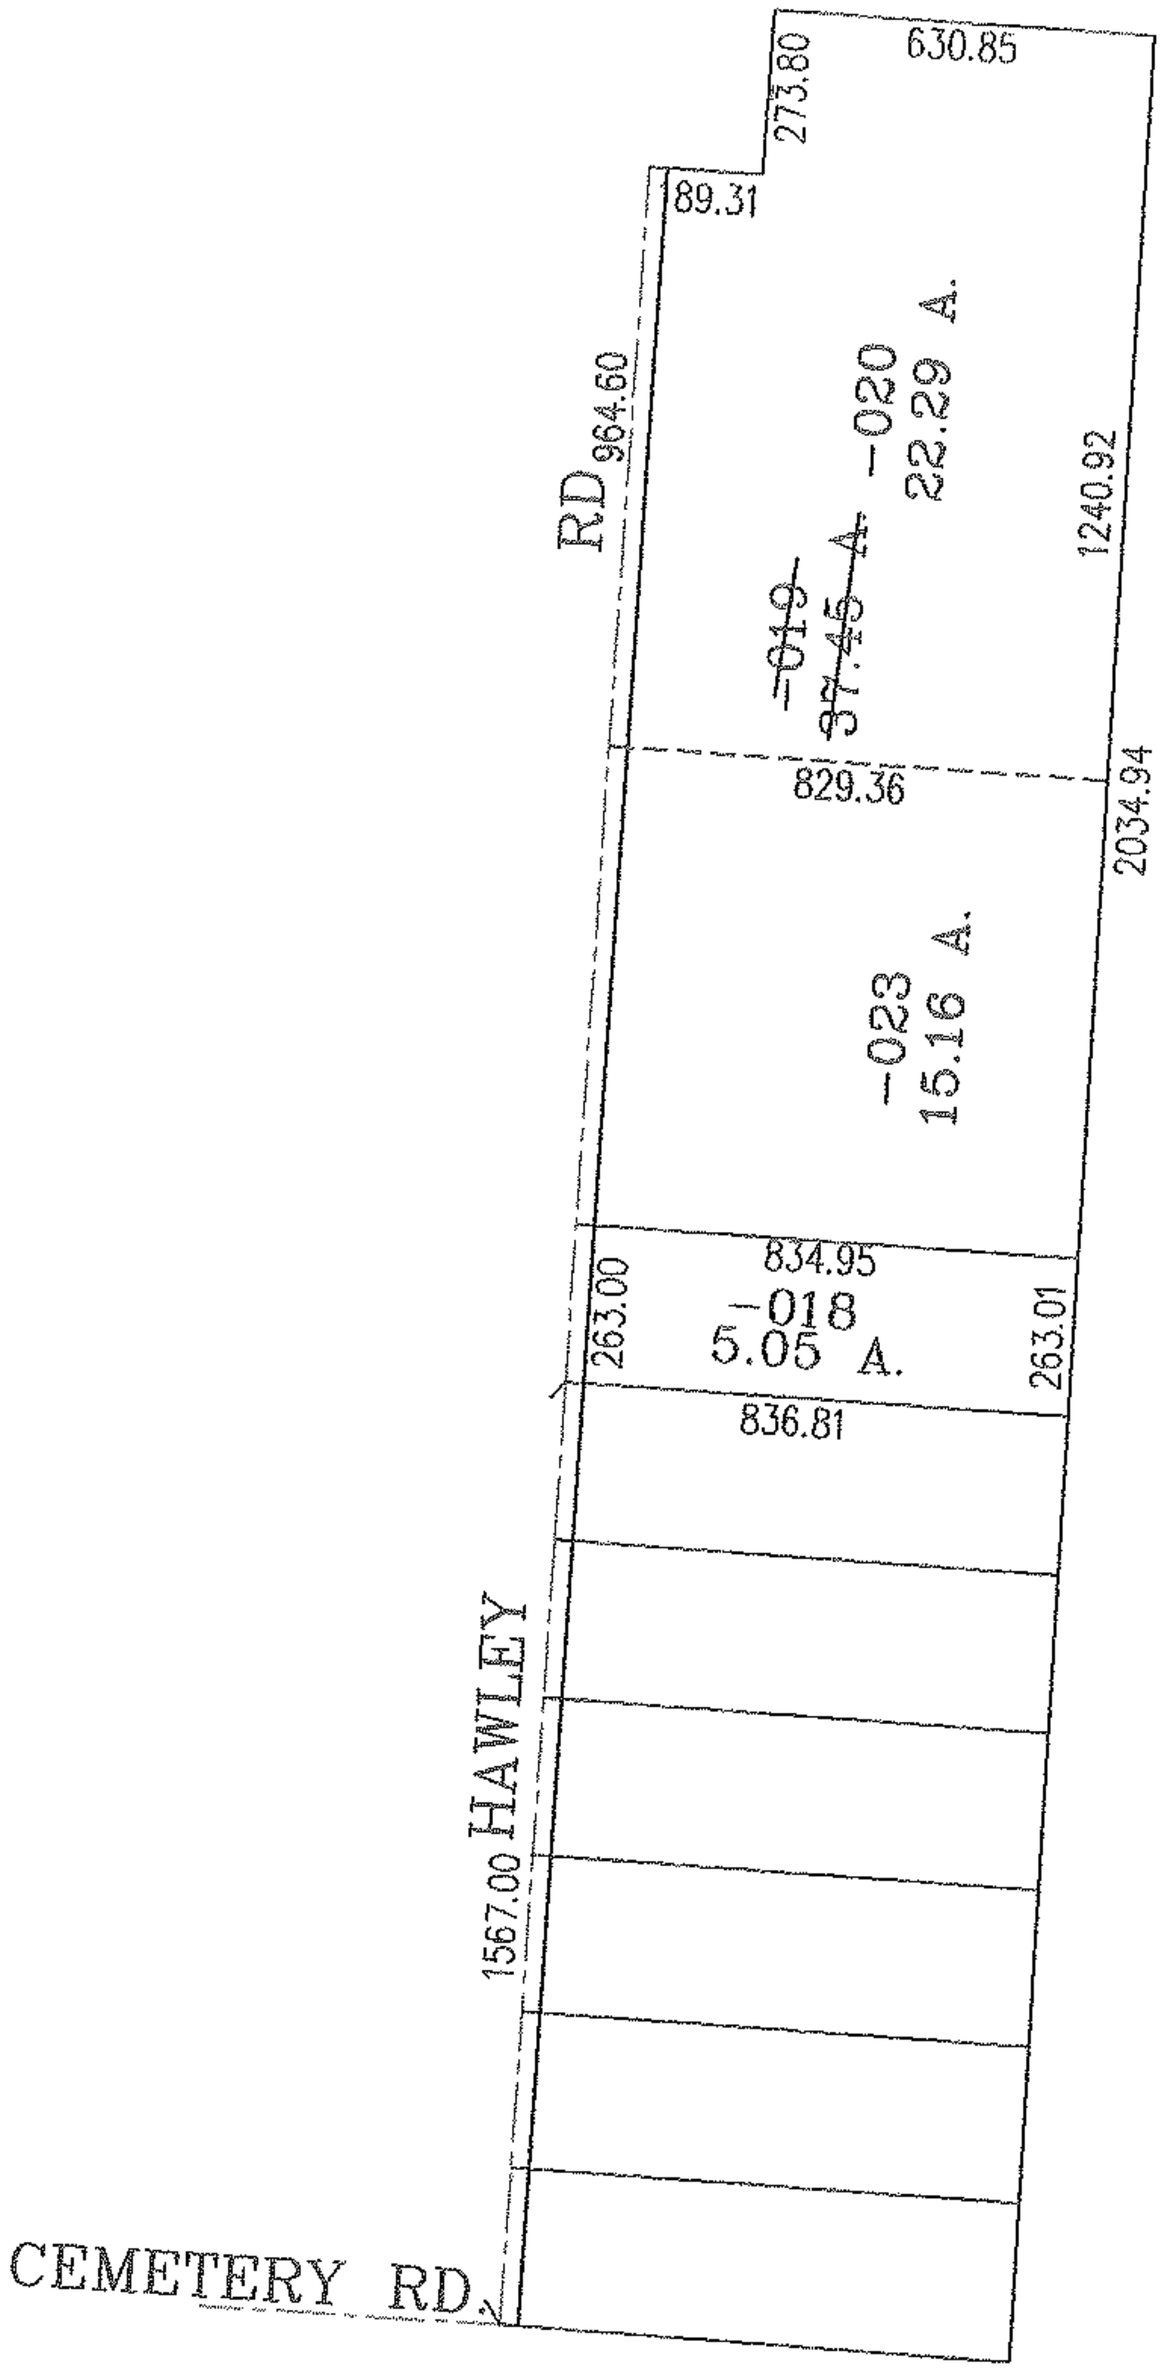

LORAIN COUNTY TAX MAP DEPARTMENT
226 MIDDLE AVE. ELYRIA, OHIO

SURVEYED BY: THOMAS A. SIMON

CLOSURE: .01:10,000

MAP PAGE(S): 18-00-010-A

APPROVED BY: JAH DATE: 6-16-04

SCALE: 1"= 500 PRIOR INSTRUMENT: 200006664964