RASTER

PARENT PARCEL: 11-00-078-000-038

CHILD PARCEL: 11-00-078-000-039 THRU -042

STARTING POINT: CENTERLINE OF DURKEE RD. & CAPEL RD.

NO. 01686

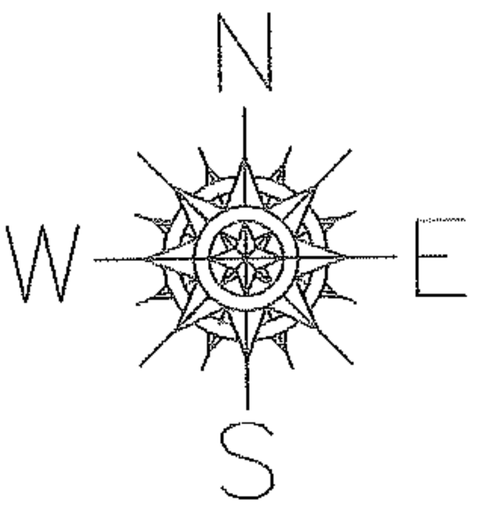

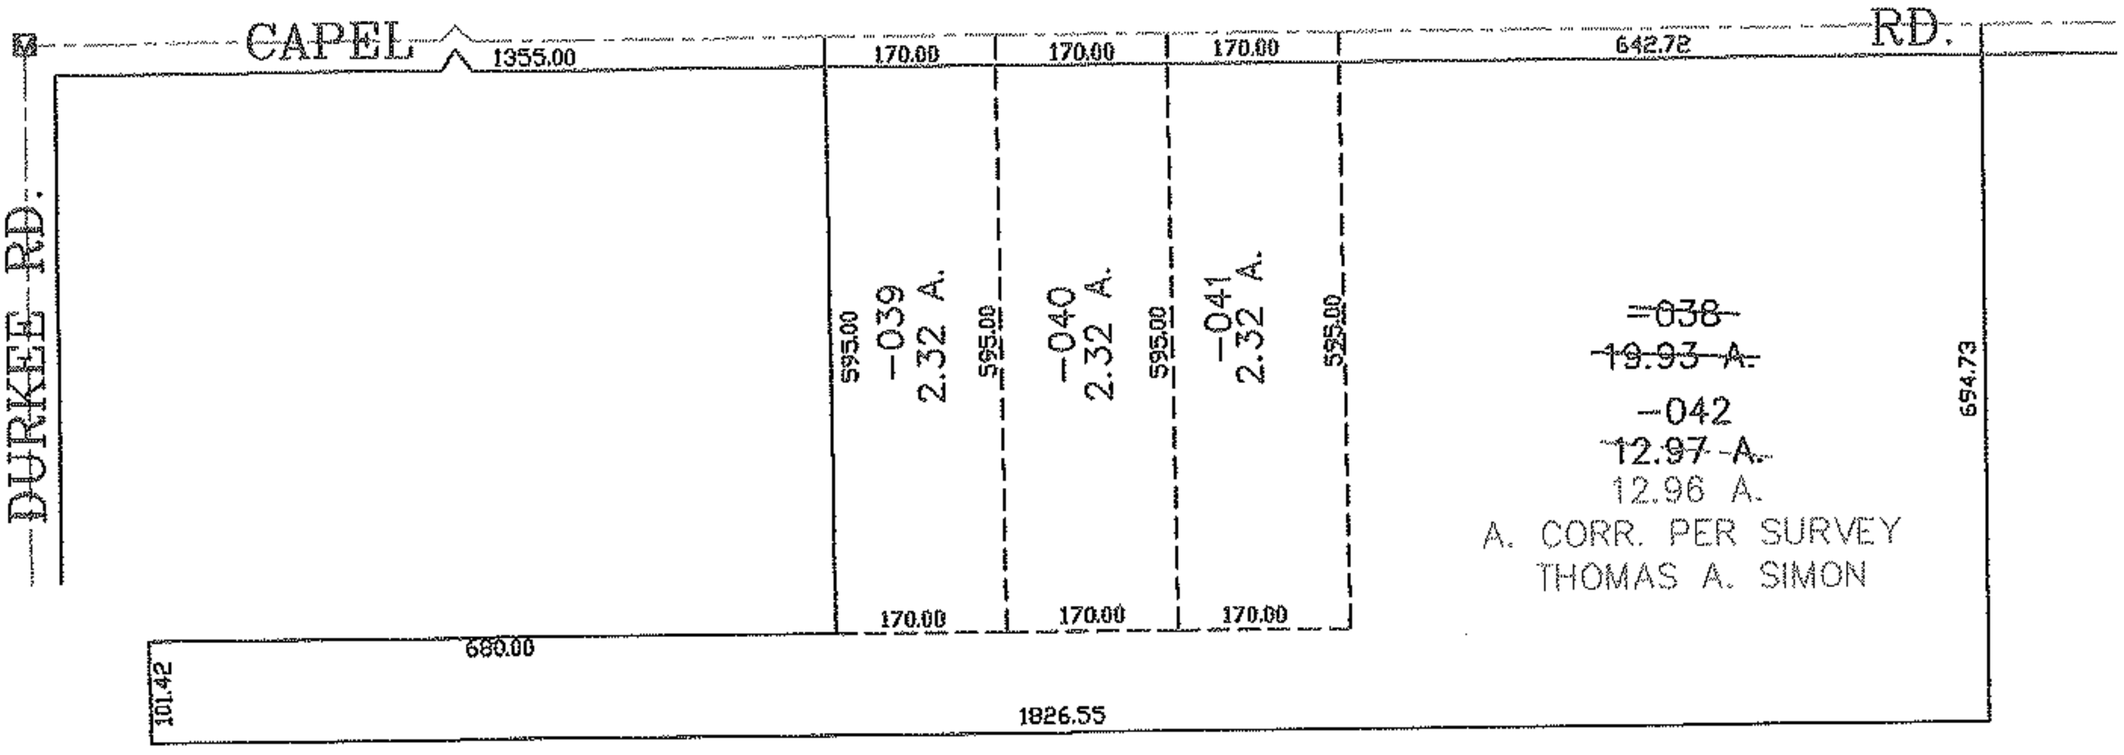

SPLITS/DEEDS PROCESSED

LORAIN COUNTY TAX MAP DEPARTMENT
226 MIDDLE AVE. ELYRIA, OHIO

SURVEYED BY: THOMAS A. SIMON

CLOSURE: 0.00 : 10,000

MAP PAGE(S): 11-00-078-B

APPROVED BY: JAH DATE: 6-23-04

SCALE: 1"= 300 PRIOR INSTRUMENT: 20040006545