RASTER

PARENT PARCEL: 01-00-003-139-044
CHILD PARCEL: 01-00-003-139-045, -046, -047
STARTING POINT: SW CORNER SL 5 AND ROW OF ELIZABETH DR

NO. 01717

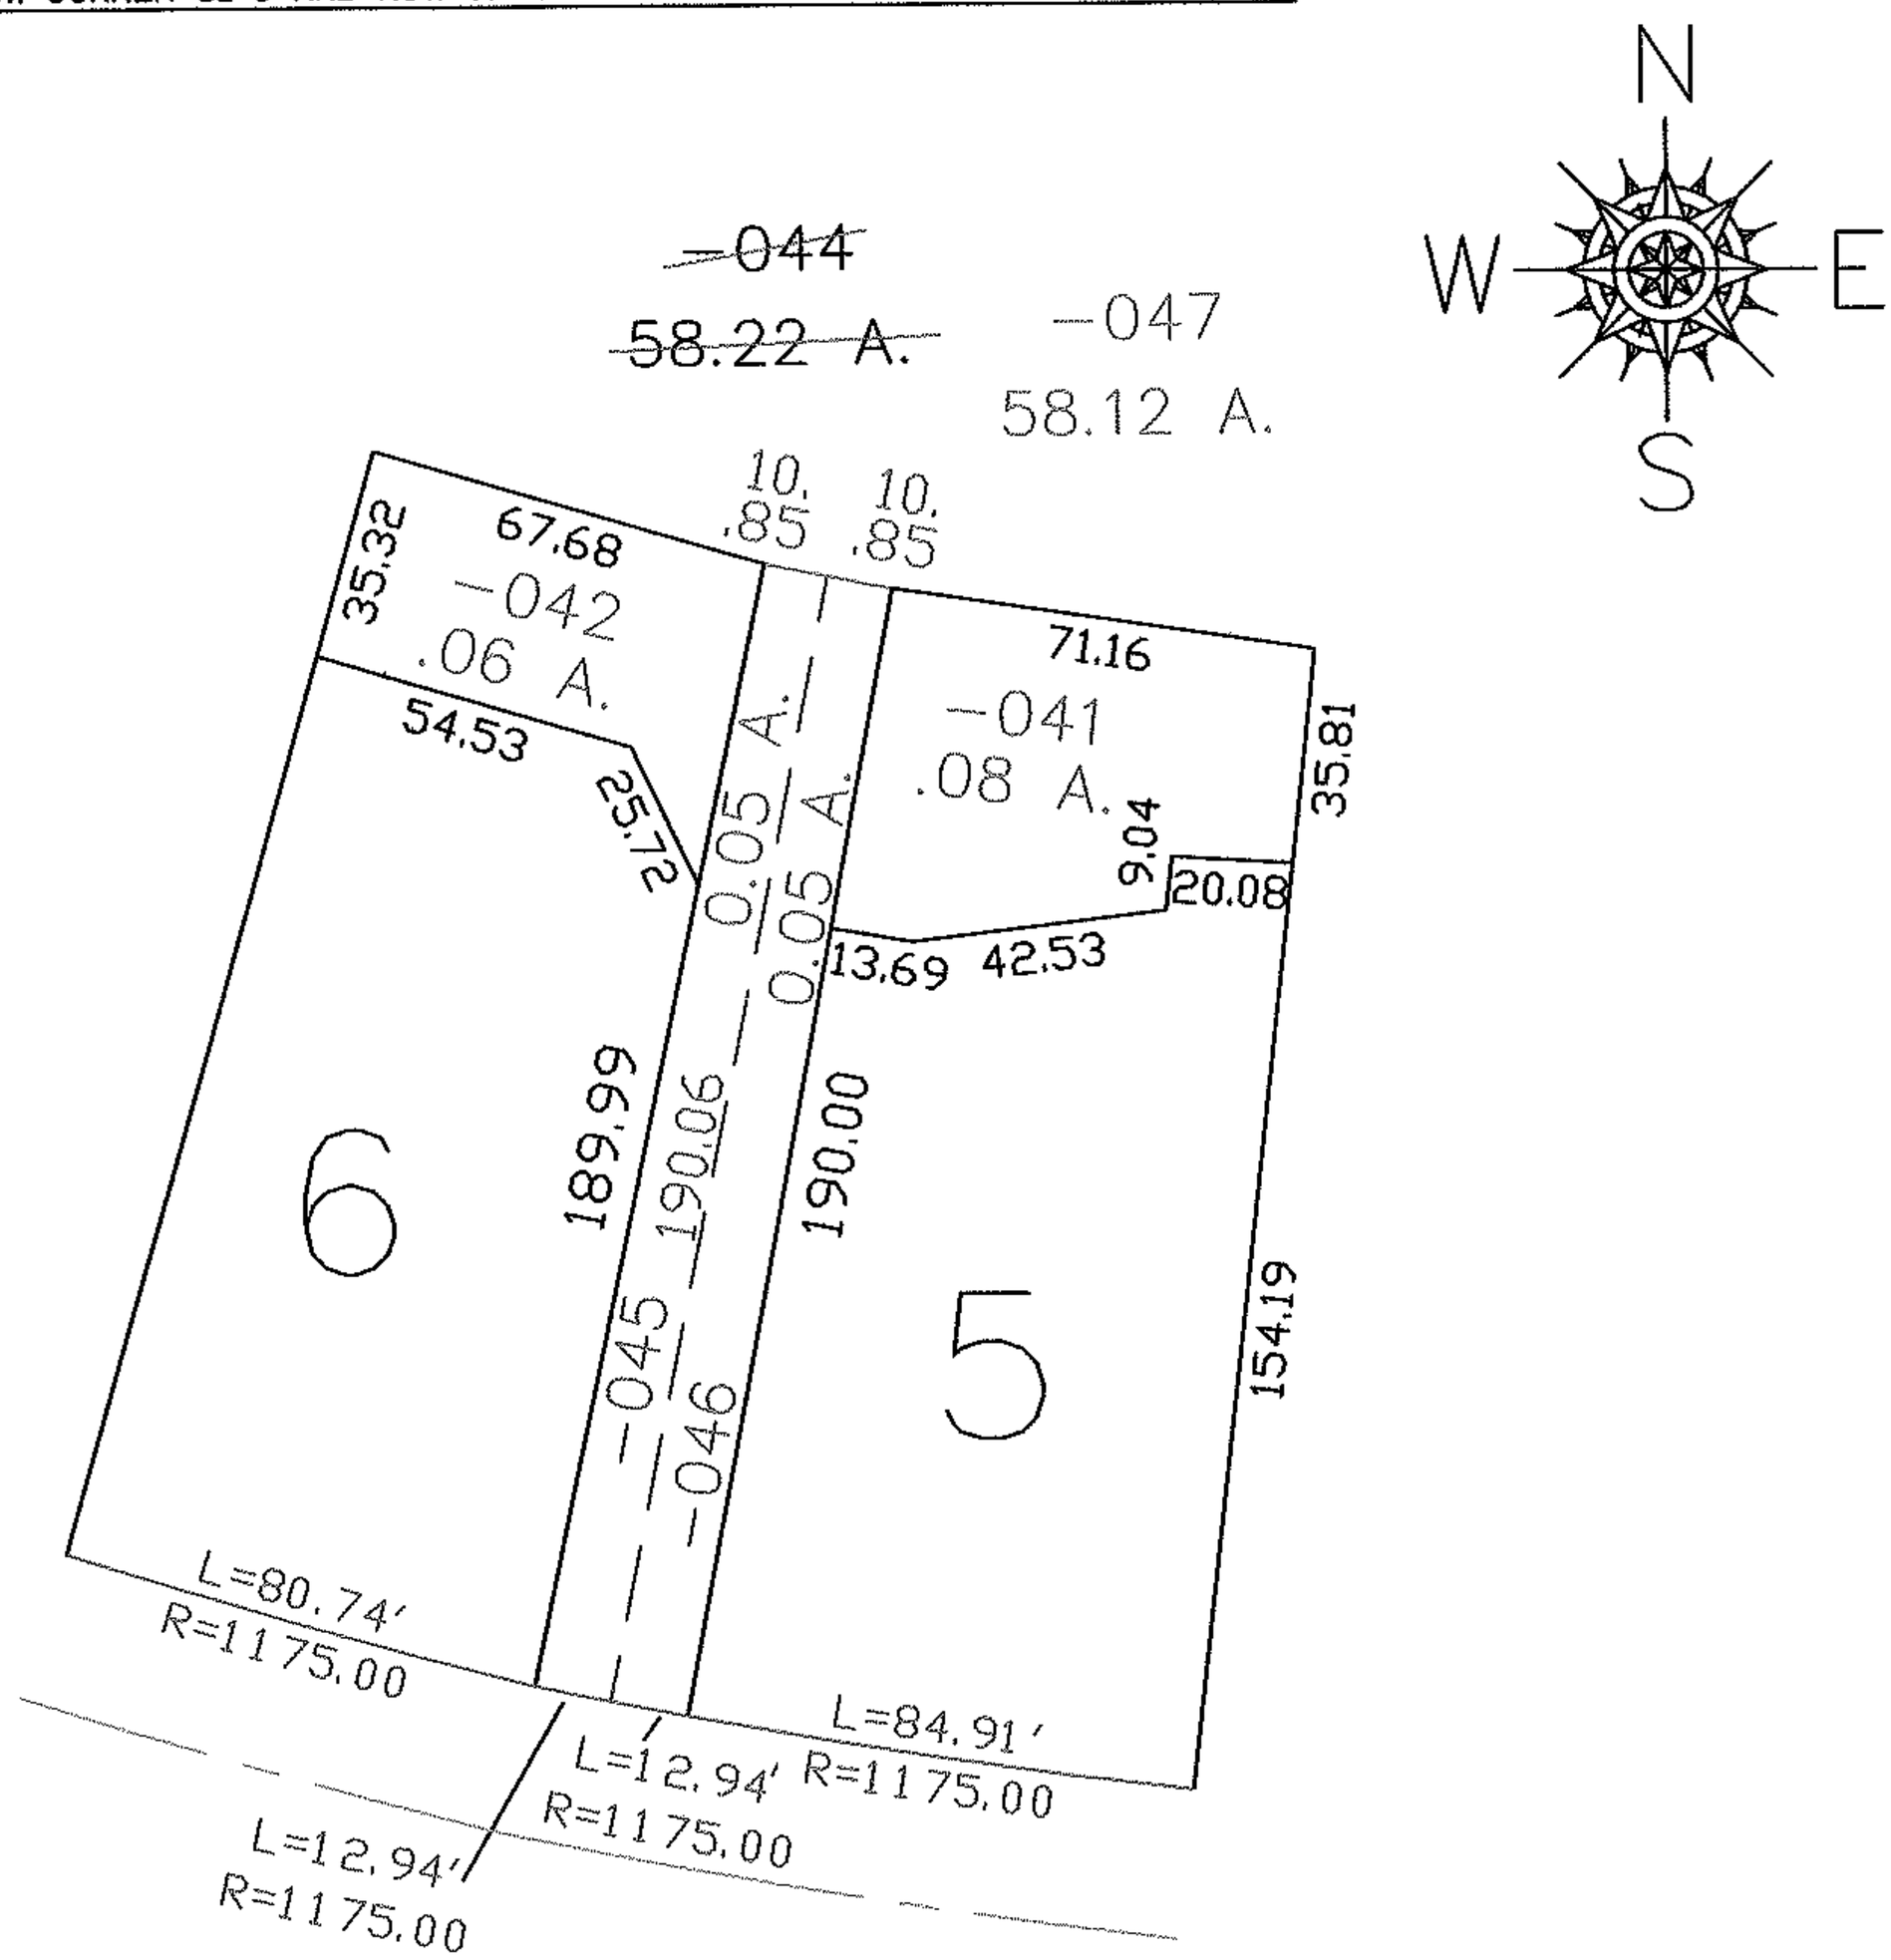

SPLITS/DEEDS PROCESSED

LORAIN COUNTY TAX MAP DEPARTMENT
226 MIDDLE AVE. ELYRIA, OHIO

SURVEYED BY: CARL R. ANDERSON
CLOSURE: 1:10,000
MAP PAGE(S): 01-00-003-C
APPROVED BY: DRH DATE: 8/4/2004
SCALE: 1"= 50 PRIOR INSTRUMENT: 20000723771