RASTER

PARENT PARCEL: 04-00-024-109-111
CHILD PARCEL: 04-00-024-109-112 THRU -125
STARTING POINT: CORNER OF MEADOW ACRES SUBDIVISION

NO. 01737

N
W E
S

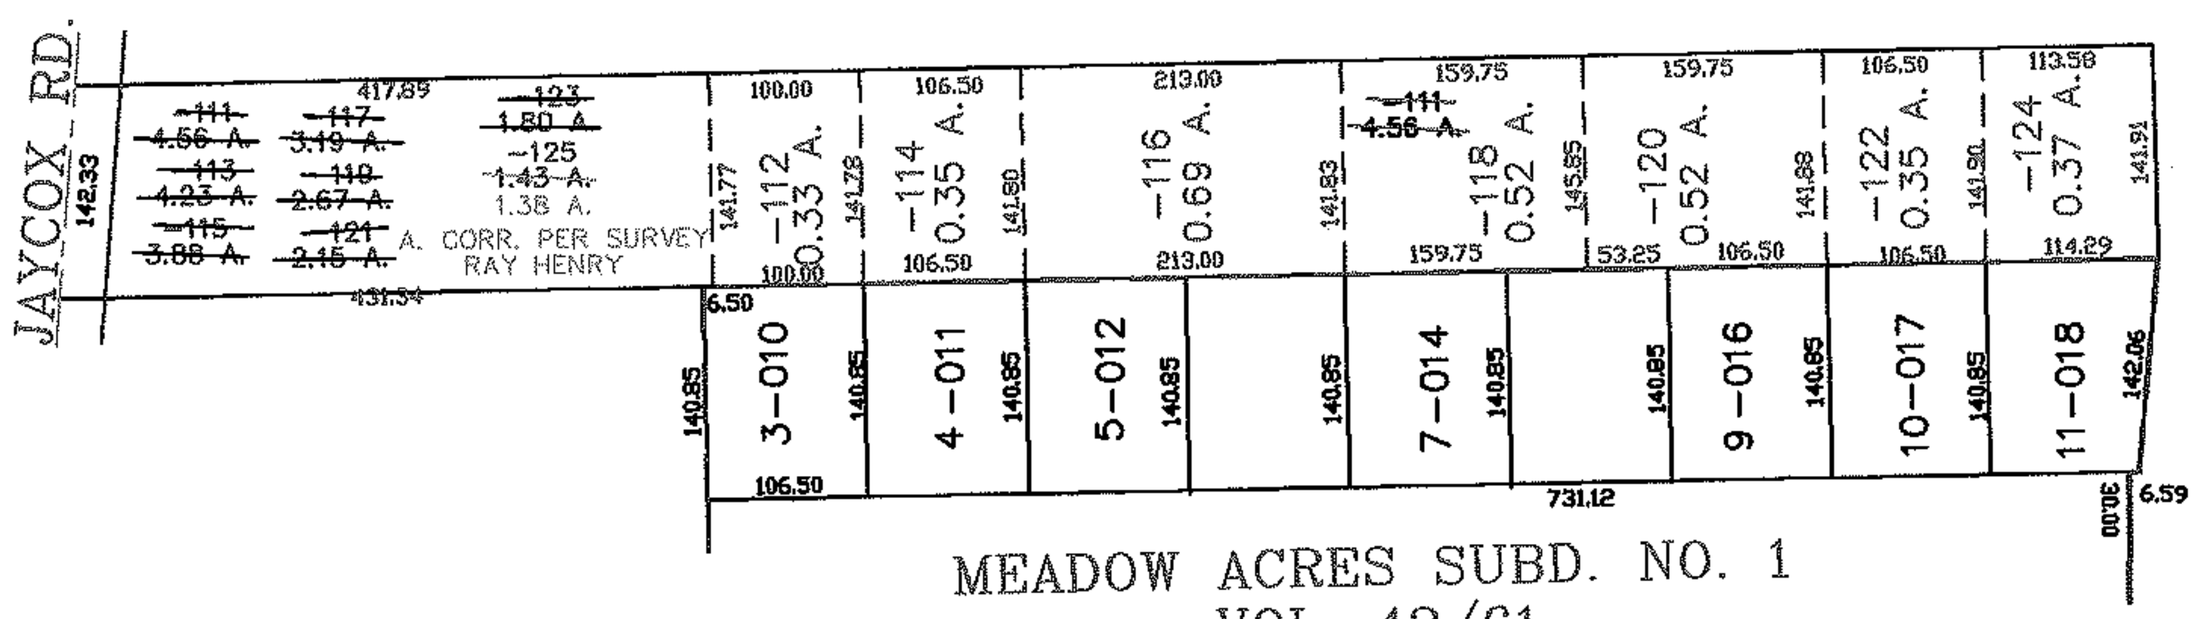

MEADOW ACRES SUBD. NO. 1
VOL. 42/61

SPLITS/DEEDS PROCESSED
LORAIN COUNTY TAX MAP DEPARTMENT
226 MIDDLE AVE. ELYRIA, OHIO

SURVEYED BY: RAY HENRY
CLOSURE: 0.06 : 10,000
MAP PAGE(S): 04-00-024-B
APPROVED BY: JAH DATE: 8-18-04
SCALE: 1"= 200 PRIOR INSTRUMENT: 19970508005