RASTER

PARENT PARCEL: 04-00-025-000-008, -274

CHILD PARCEL: 04-00-025-000-325 THRU -330

STARTING POINT: CENTERLINE OF NAGEL RD. & O.L. 25

NO. 01746

N

W E

S

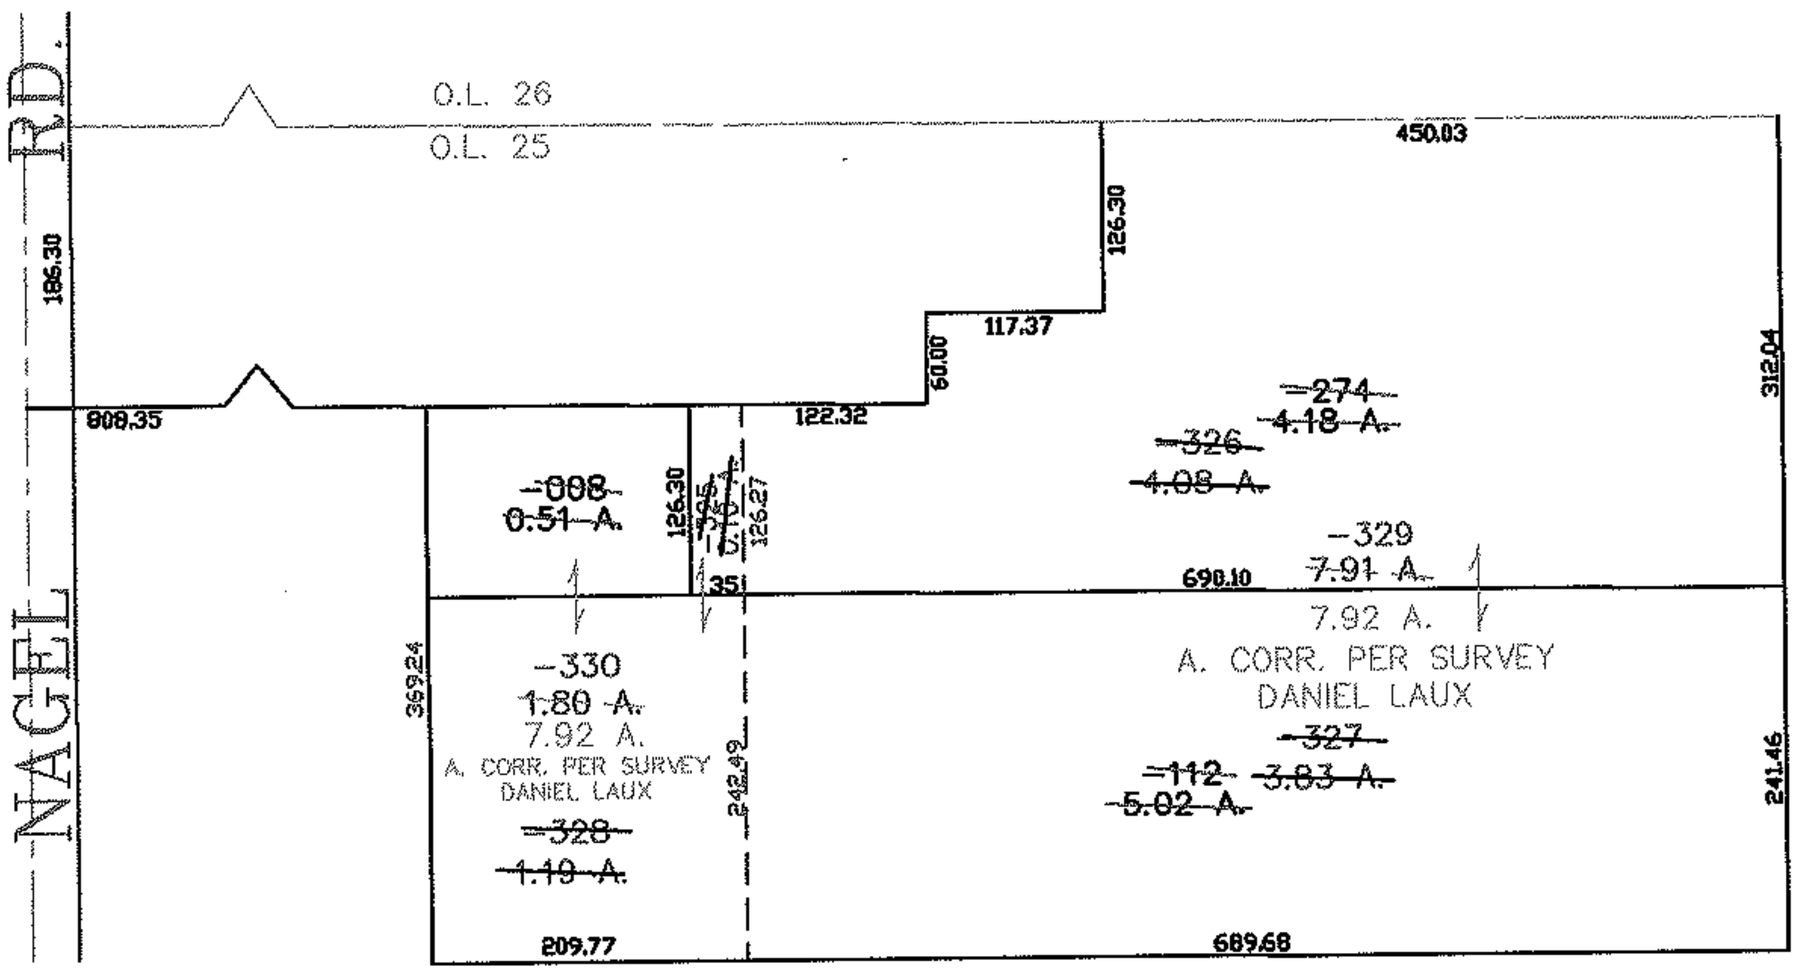

SPLITS/DEEDS PROCESSED

LORAIN COUNTY TAX MAP DEPARTMENT
226 MIDDLE AVE. ELYRIA, OHIO

SURVEYED BY: DANIEL LAUX

CLOSURE: 0.00 : 10,000

MAP PAGE(S): 4-00-025-A

APPROVED BY: JAH DATE: 8-25-04

SCALE: 1"= 200 PRIOR INSTRUMENT: OR 829/523